



10+50.00

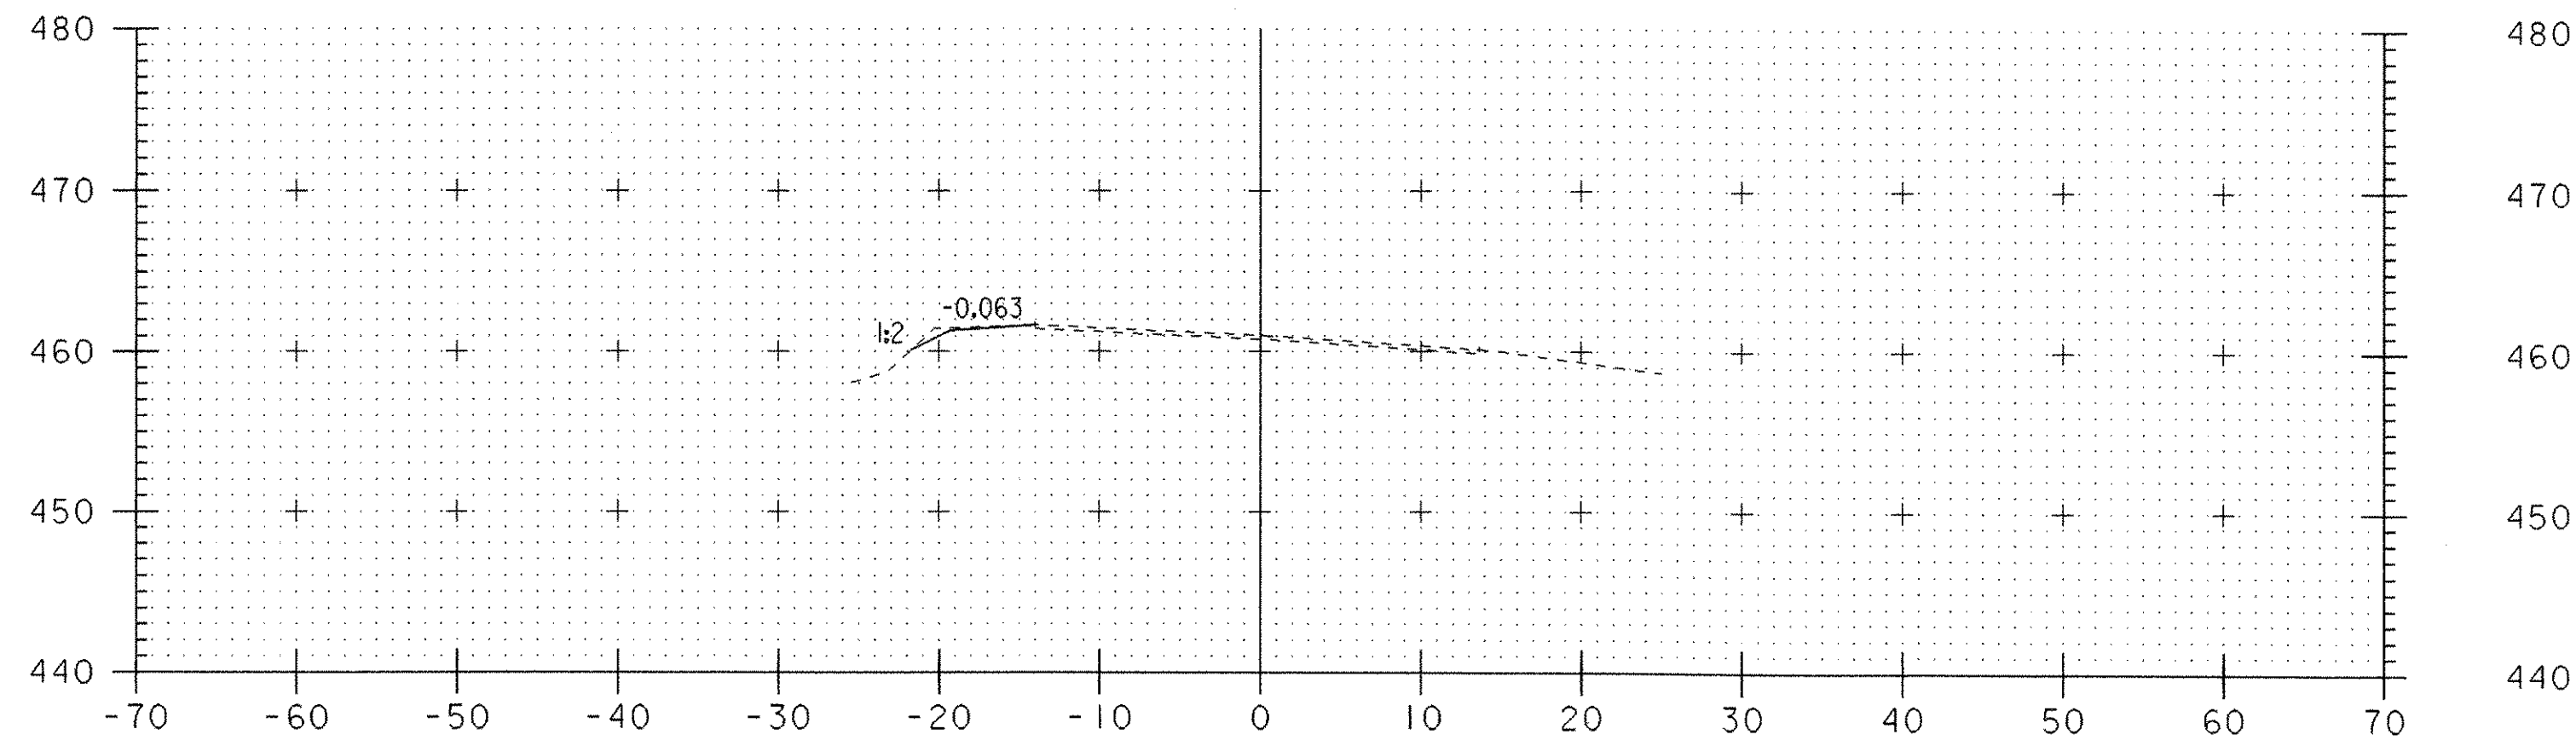

10+00.00

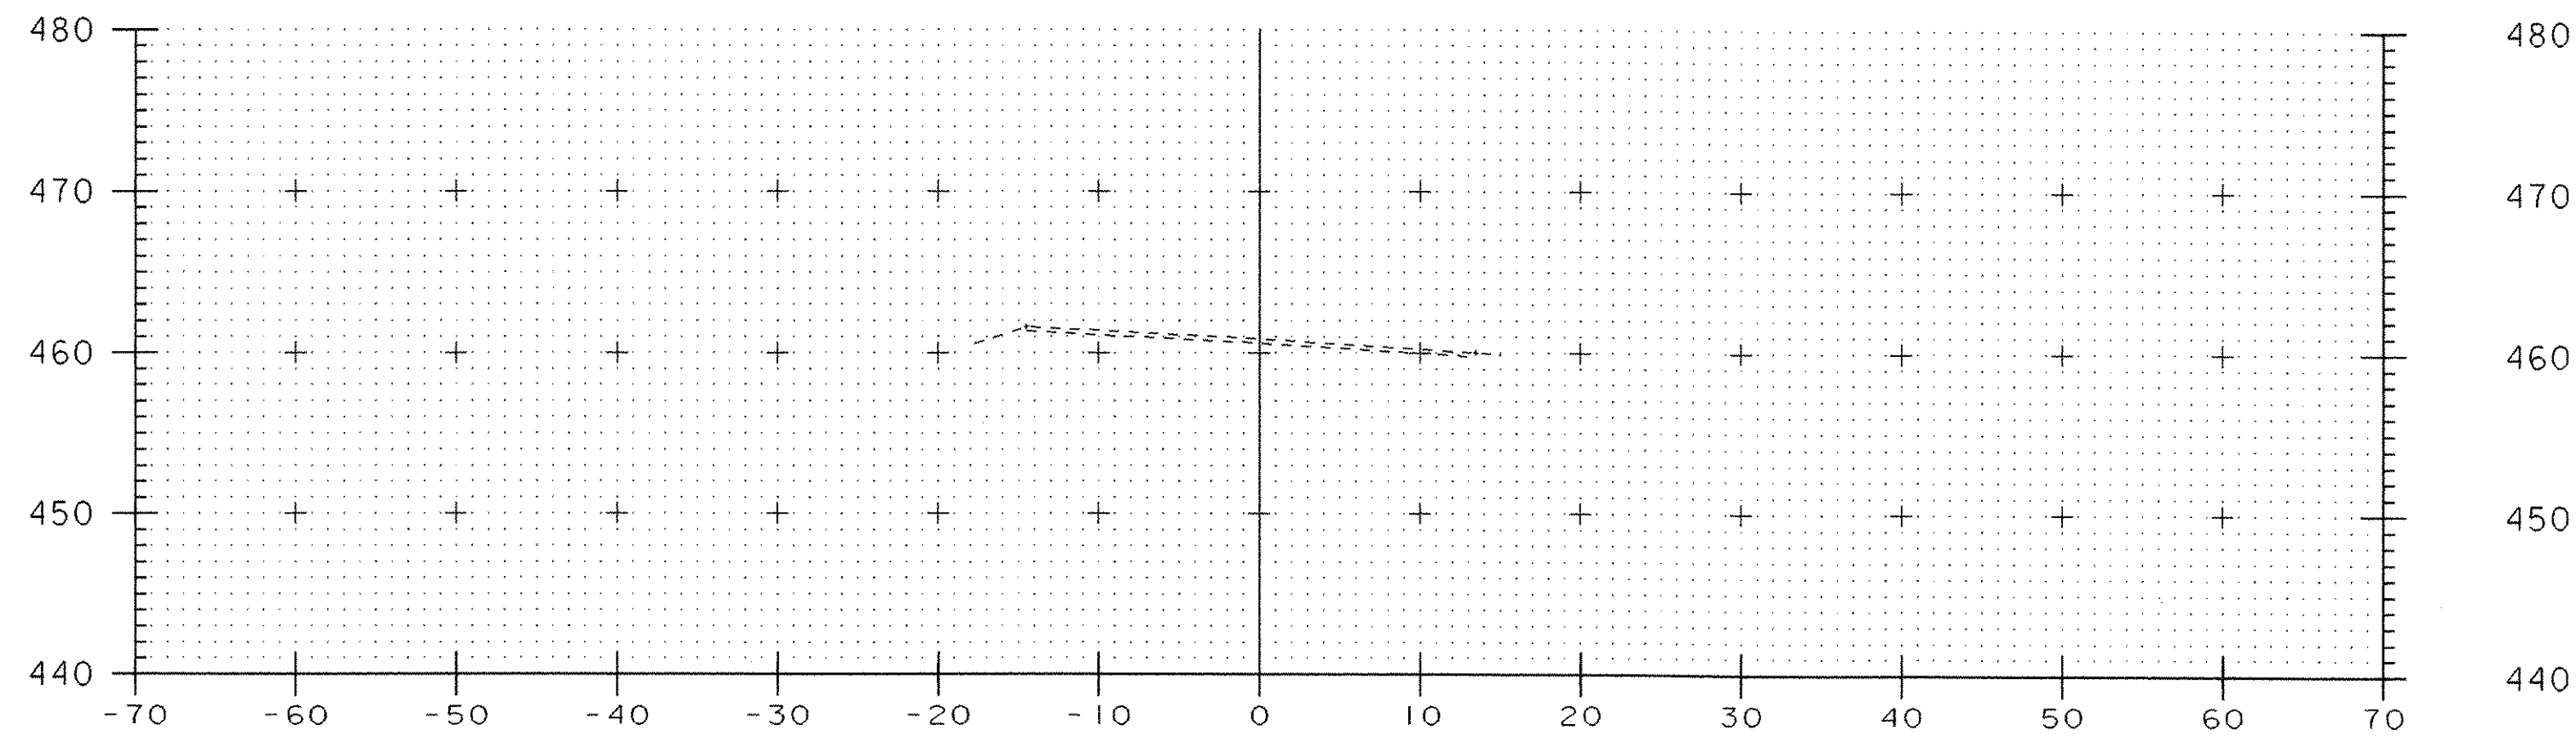

9+84.76
BEGIN APPROACH

STATE OF VERMONT AGENCY OF TRANSPORTATION			
Town Of	<i>MONTGOMERY</i>	Bridge No.	<i>21</i>
Highway No.		Log Sta.	
		Surv. Sta.	
<i>VT 118 OVER TROUT RIVER</i>			
<i>CROSS SECTIONS</i>			
Designed By	<i>D Bryant</i>	Drawn By	<i>P Donovan</i>
Checked By	<i>R Hebert</i>	Bridge Design Supervisor	<i>R.WHITCOMB</i>
	<i>08/31/01</i>	Date	
PROJECT	<i>MONTGOMERY</i>	PROJECT NO.	<i>BHF 0283(8)S</i>
I.G.C. Info.			<i>ZC316XSI.DGN</i>
Bridge Sheet No.		Sheet	<i>35</i> of <i>45</i>

TYLININTERNATIONAL