



13+00.00

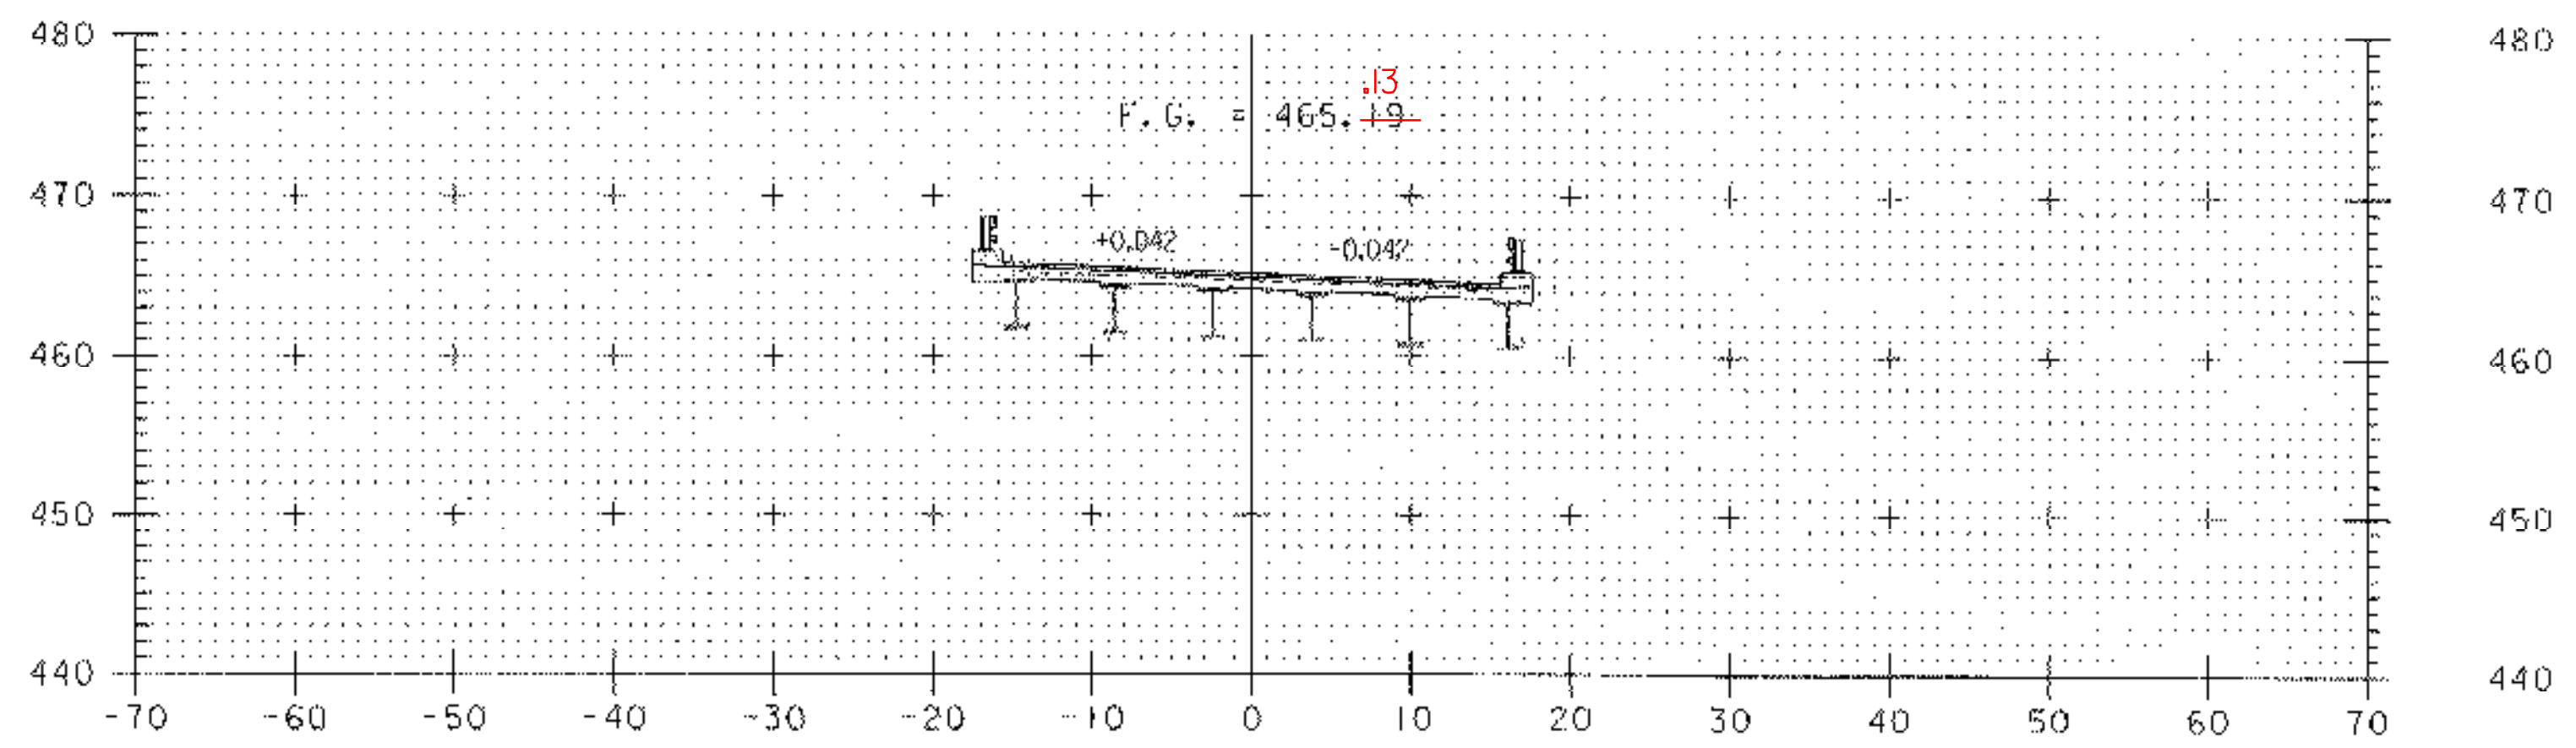

12+50.00

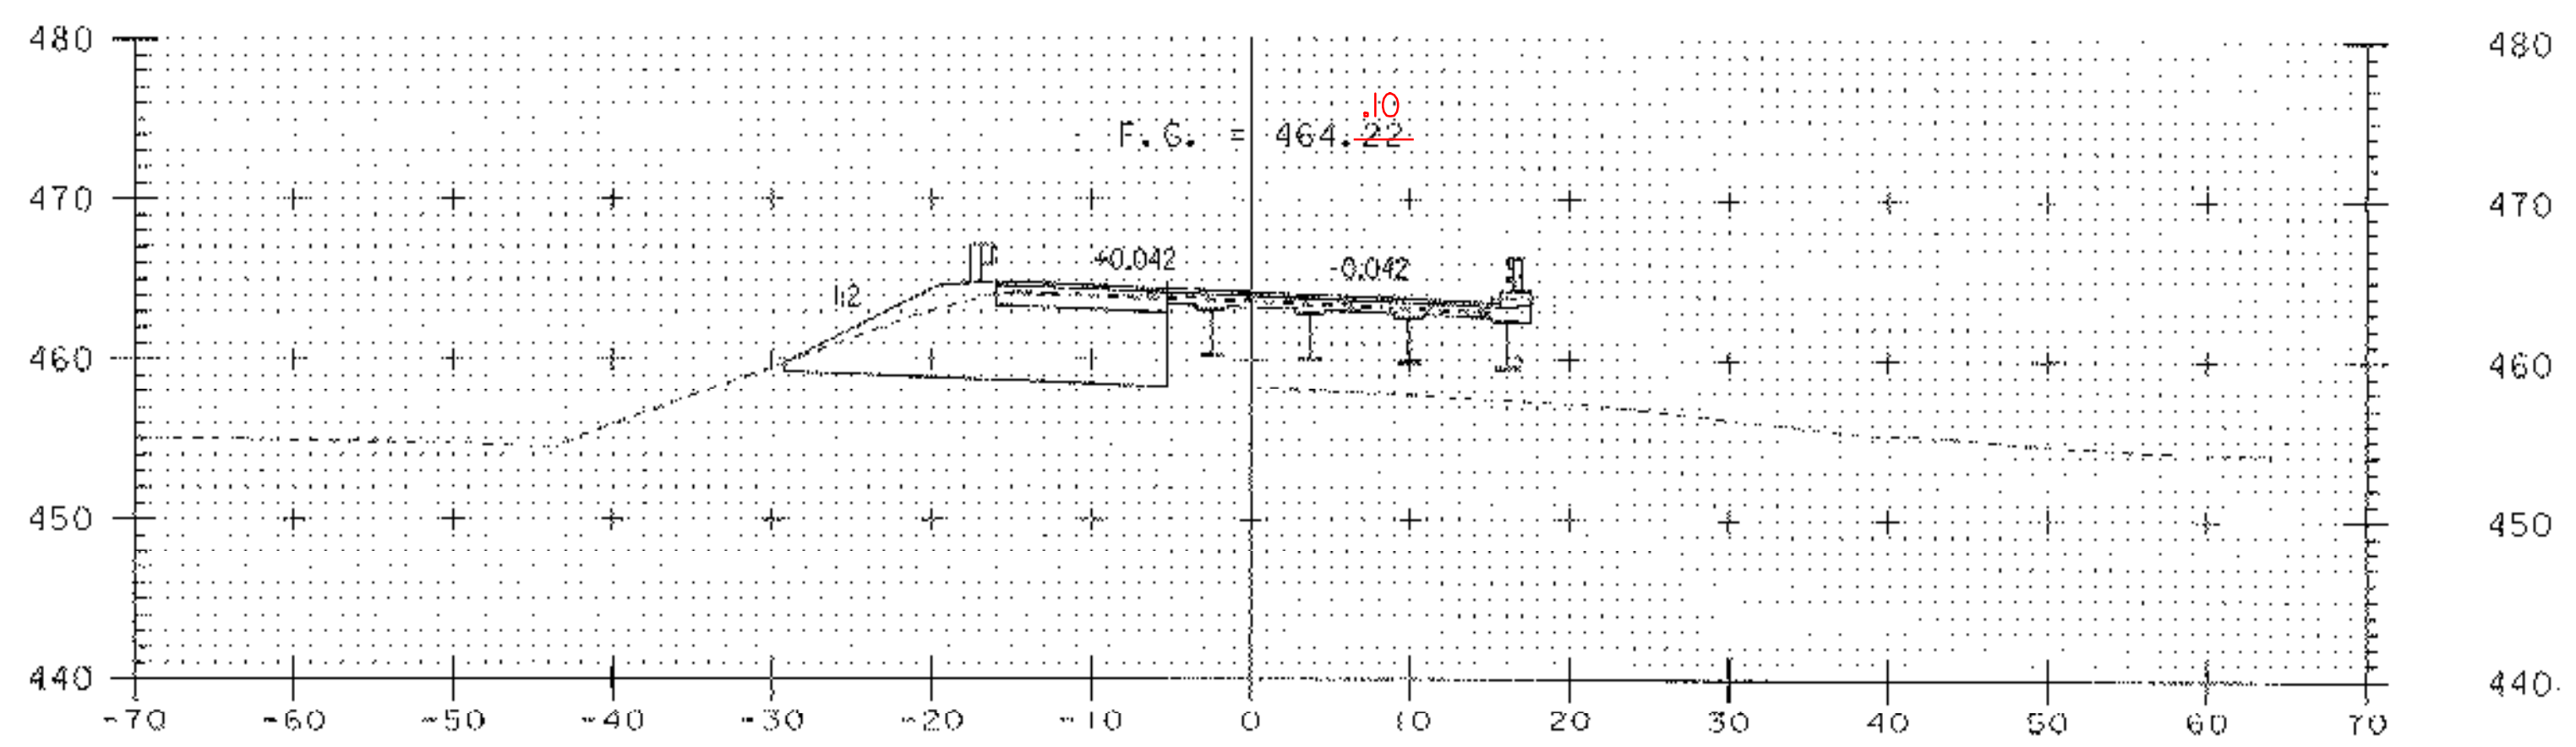

12+00.00

STA 11+97.91
BEGIN BRIDGE
END ROADWAY
OVERLAY AND
WIDENING

REVISED 3/13/06

STATE OF VERMONT AGENCY OF TRANSPORTATION			
Town Of	MONTGOMERY	Bridge No.	21
Highway No.		Leg. Sta.	
		Surv. Sta.	
VT 118 OVER TROUT RIVER			
CROSS SECTIONS			
Designed By	D. Bryant	Drawn By	P. Donovan
Checked By	R. Hebert	Date	08/31/01
		Bridge Design Supervisor	A. WHITCOMB
		Date	
PROJECT	MONTGOMERY	PROJECT NO.	BHF 0283(B)S
I.G.C. Info.			ZC316XSLDCM
Bridge Sheet No.		Sheet	37 of 45

TY-LIN INTERNATIONAL

DATE: 08/31/01 FILE: 118