
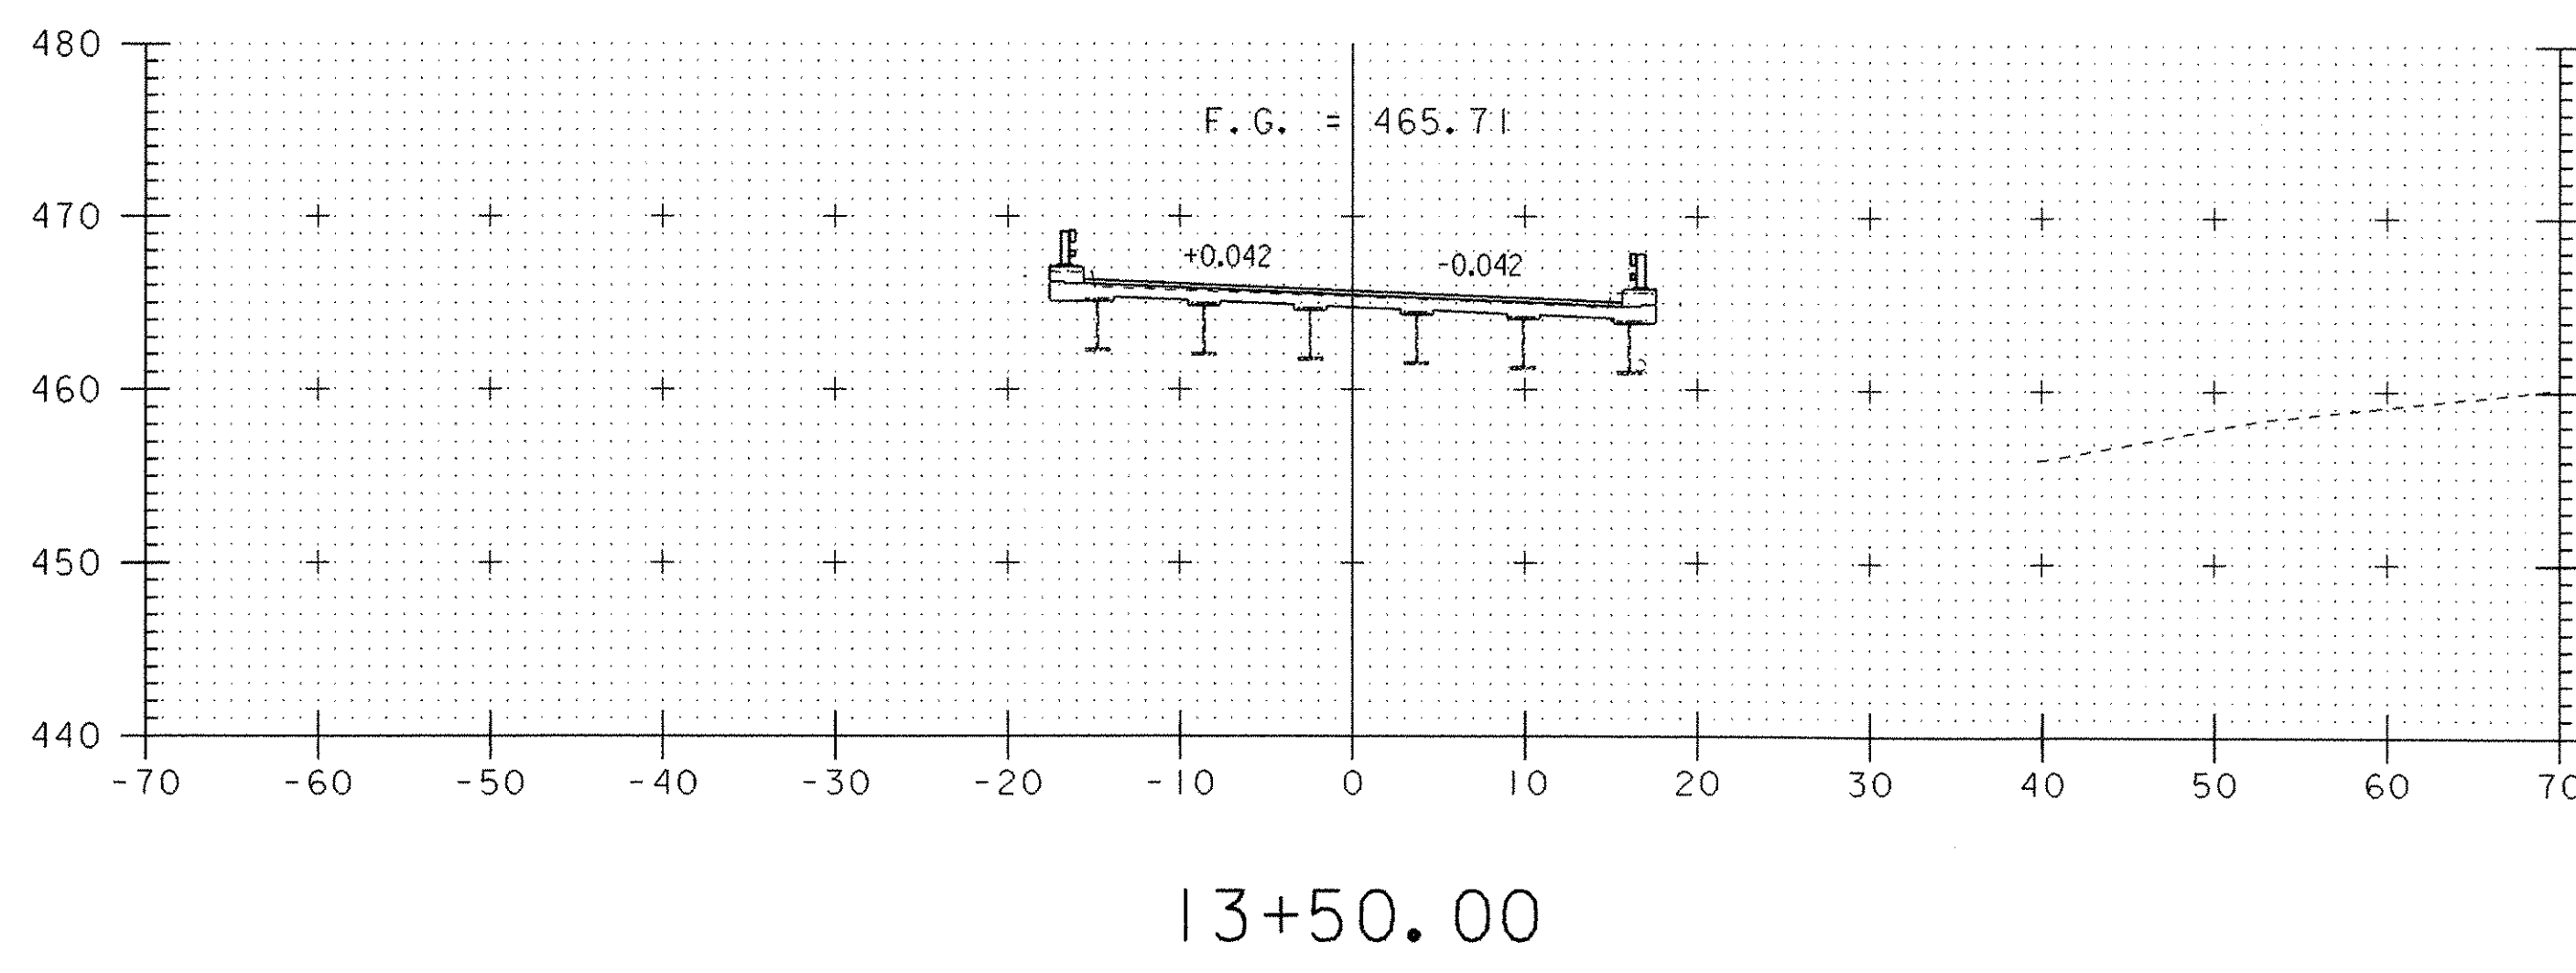


BANKING TRANSITION DETAIL

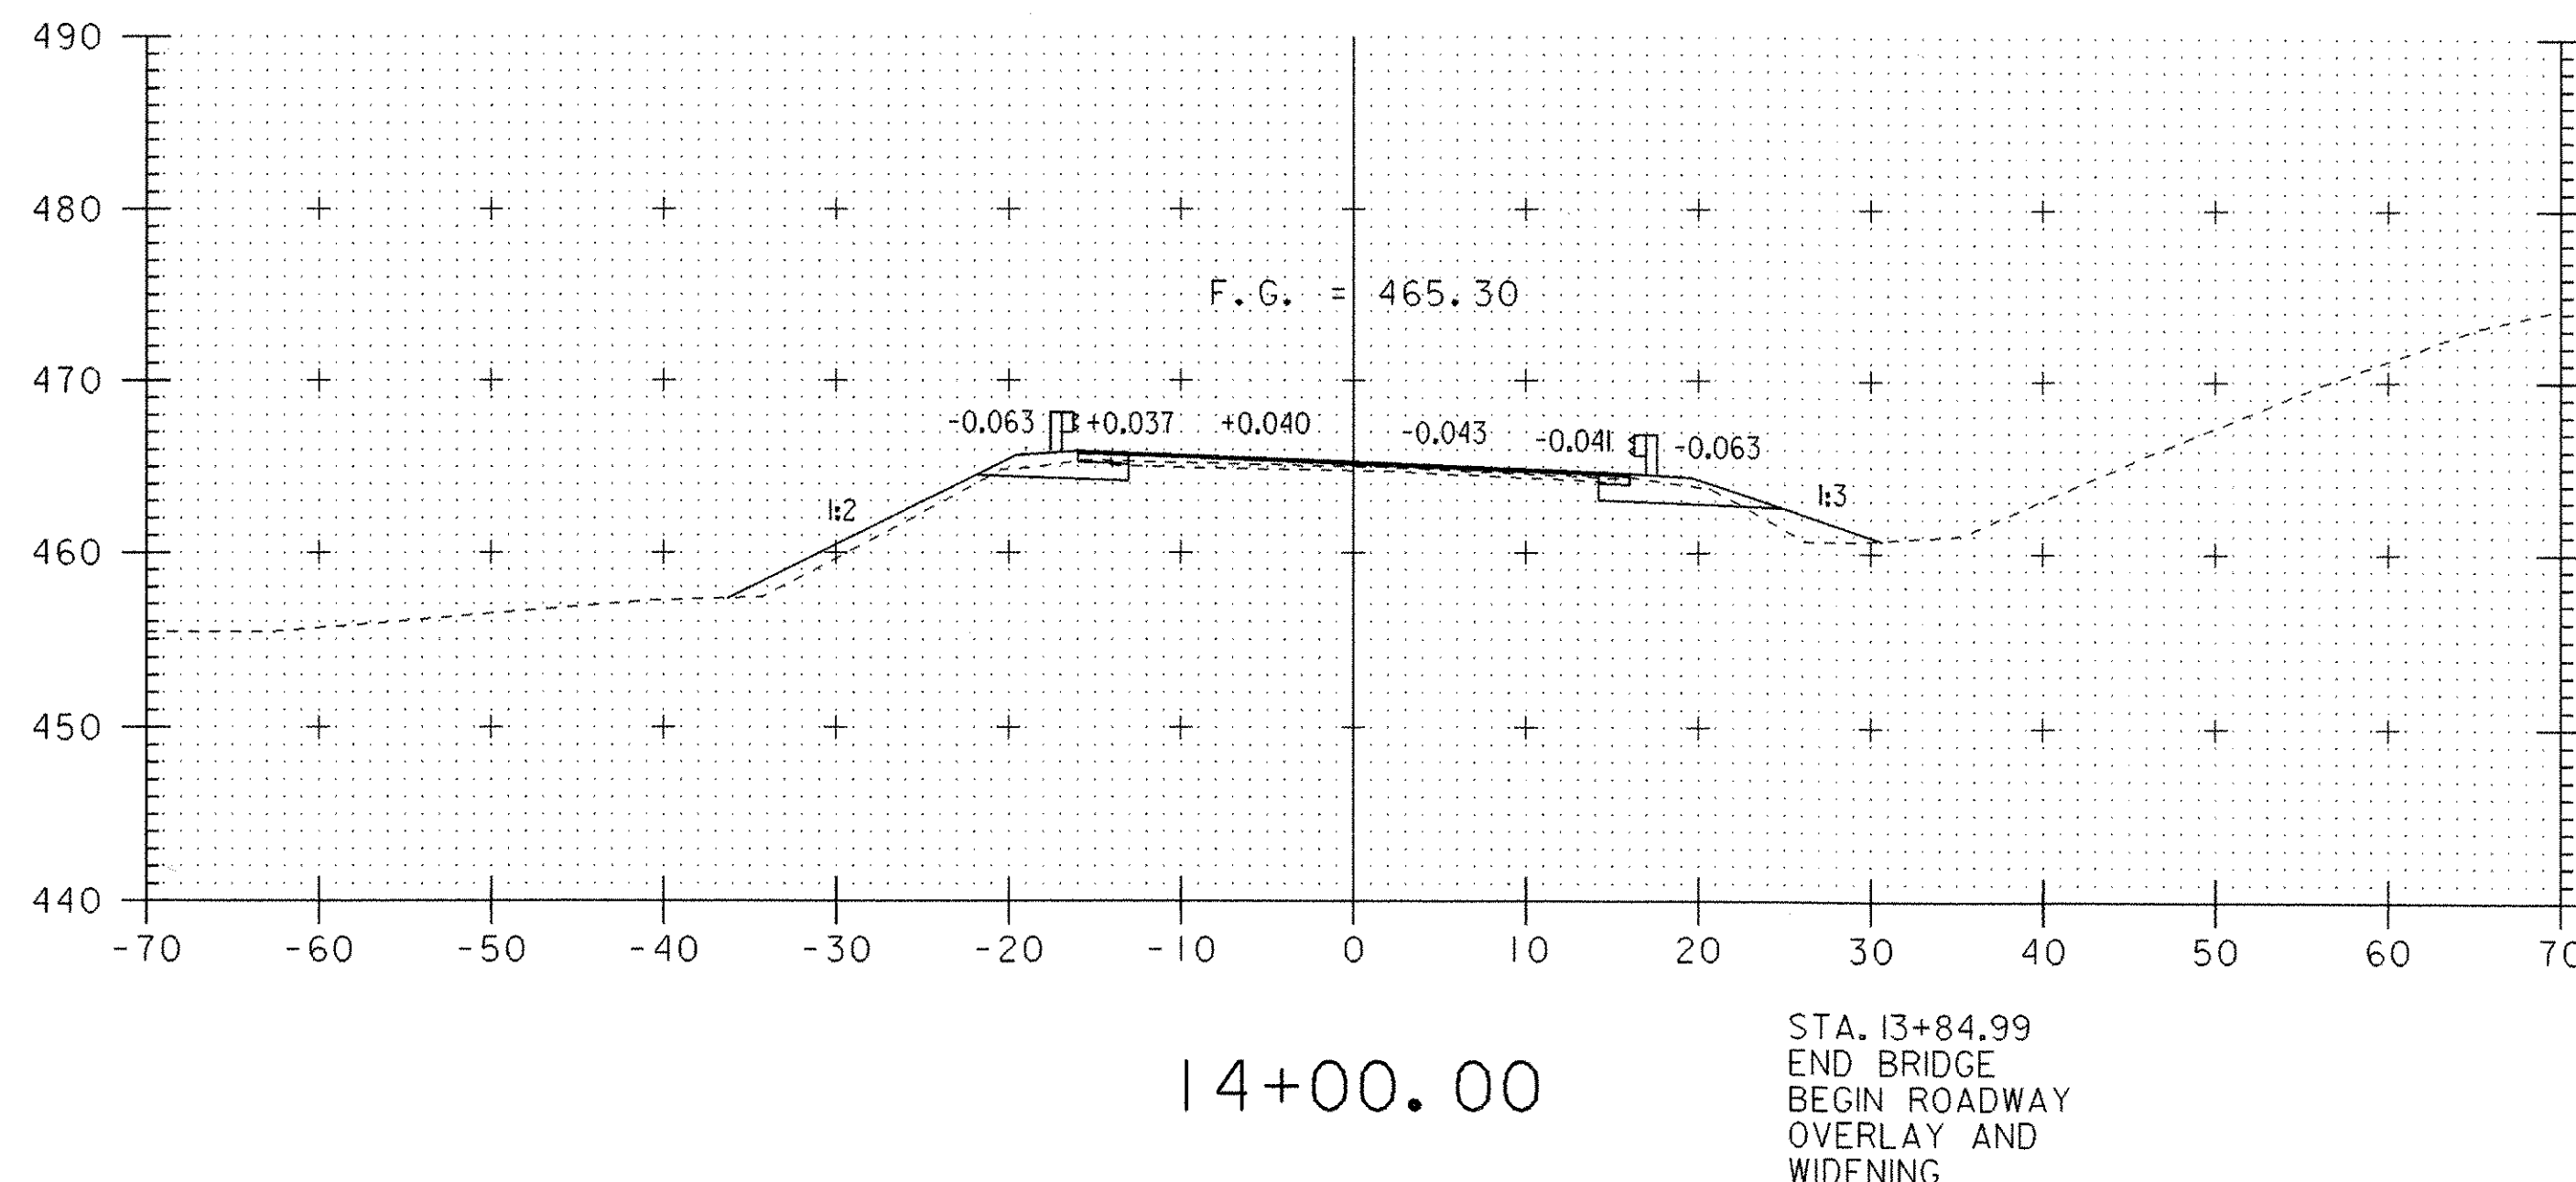

<b>STATE OF VERMONT AGENCY OF TRANSPORTATION</b>	
Town Of <b>MONTGOMERY</b>	Bridge No. <b>21</b>
Highway No.	Log Sta. Surv. Sta.
<b>VT 118 OVER TROUT RIVER</b>	
<b>CROSS SECTIONS</b>	
Designed By <b>D Bryant</b>	Drawn By <b>P Donovan</b>
Checked By <b>R Hebert</b>	Bridge Design Supervisor
Date <b>08/31/01</b>	Date
PROJECT <b>MONTGOMERY</b>	PROJECT NO. <b>BHF 0283(8)S</b>
I.G.C. Info.	<b>ZC316XSI.DGN</b>
Bridge Sheet No.	Sheet <b>38</b> of <b>45</b>

**TYLIN**INTERNATIONAL

DATE: 08/31/01 FILENAME: PFILE\$