
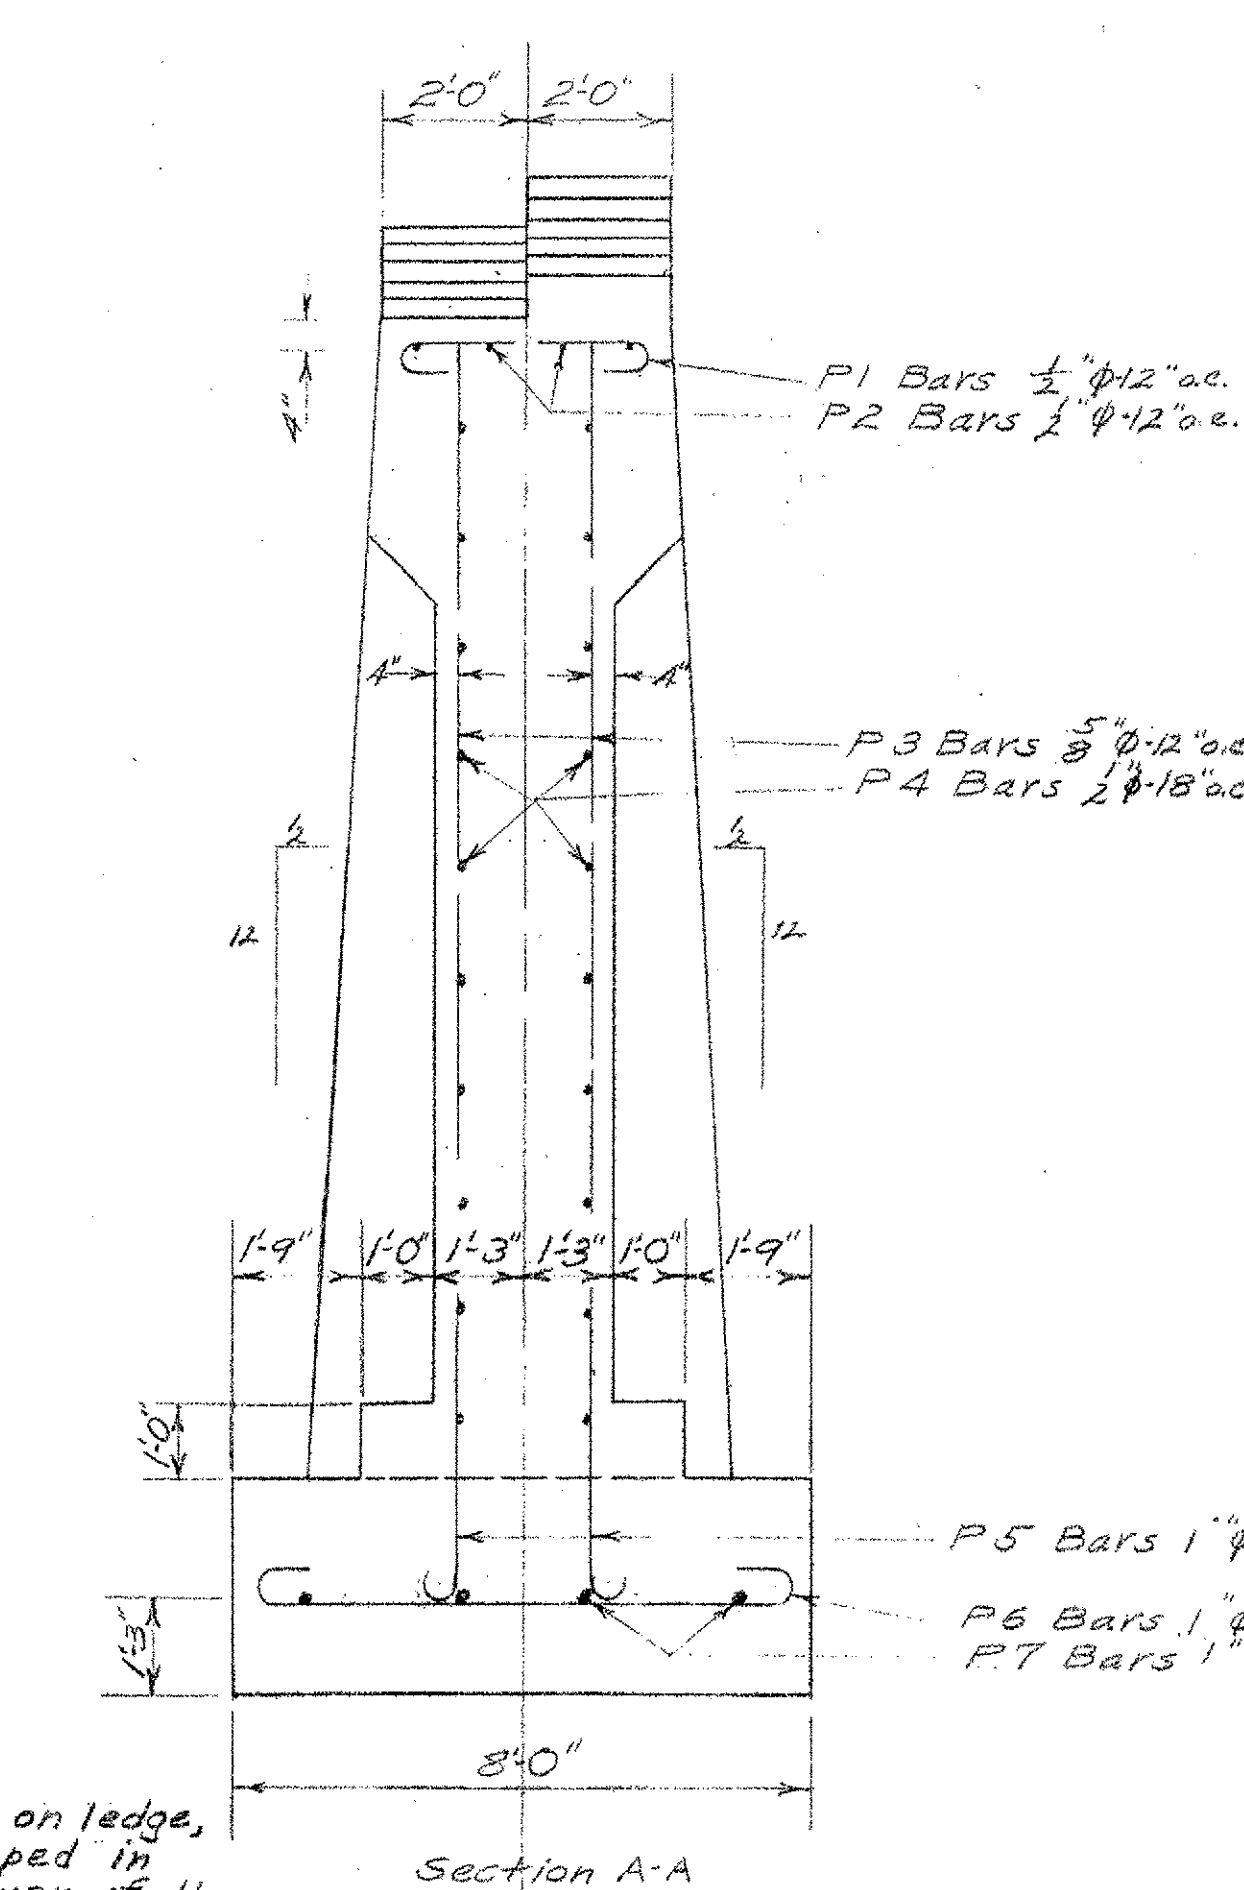


REINFORCING STEEL				
Bar Size	No.	Length	Detail	
P1	1/2" φ	34	4'-9"	
P2	1/2" φ	8	17'-6"	Straight
P3	5/8" φ	92	15'-0"	Straight
P4	1/2" φ	40	17'-1"	Straight
P5	1" φ	46	6'-3"	
P6	1" φ	23	9'-6"	
P7	1" φ	8	24'-7"	
P8	1/2" φ	30	Avg. 16'-6"	Straight, bent in field

For General Notes See Details Abut. #1

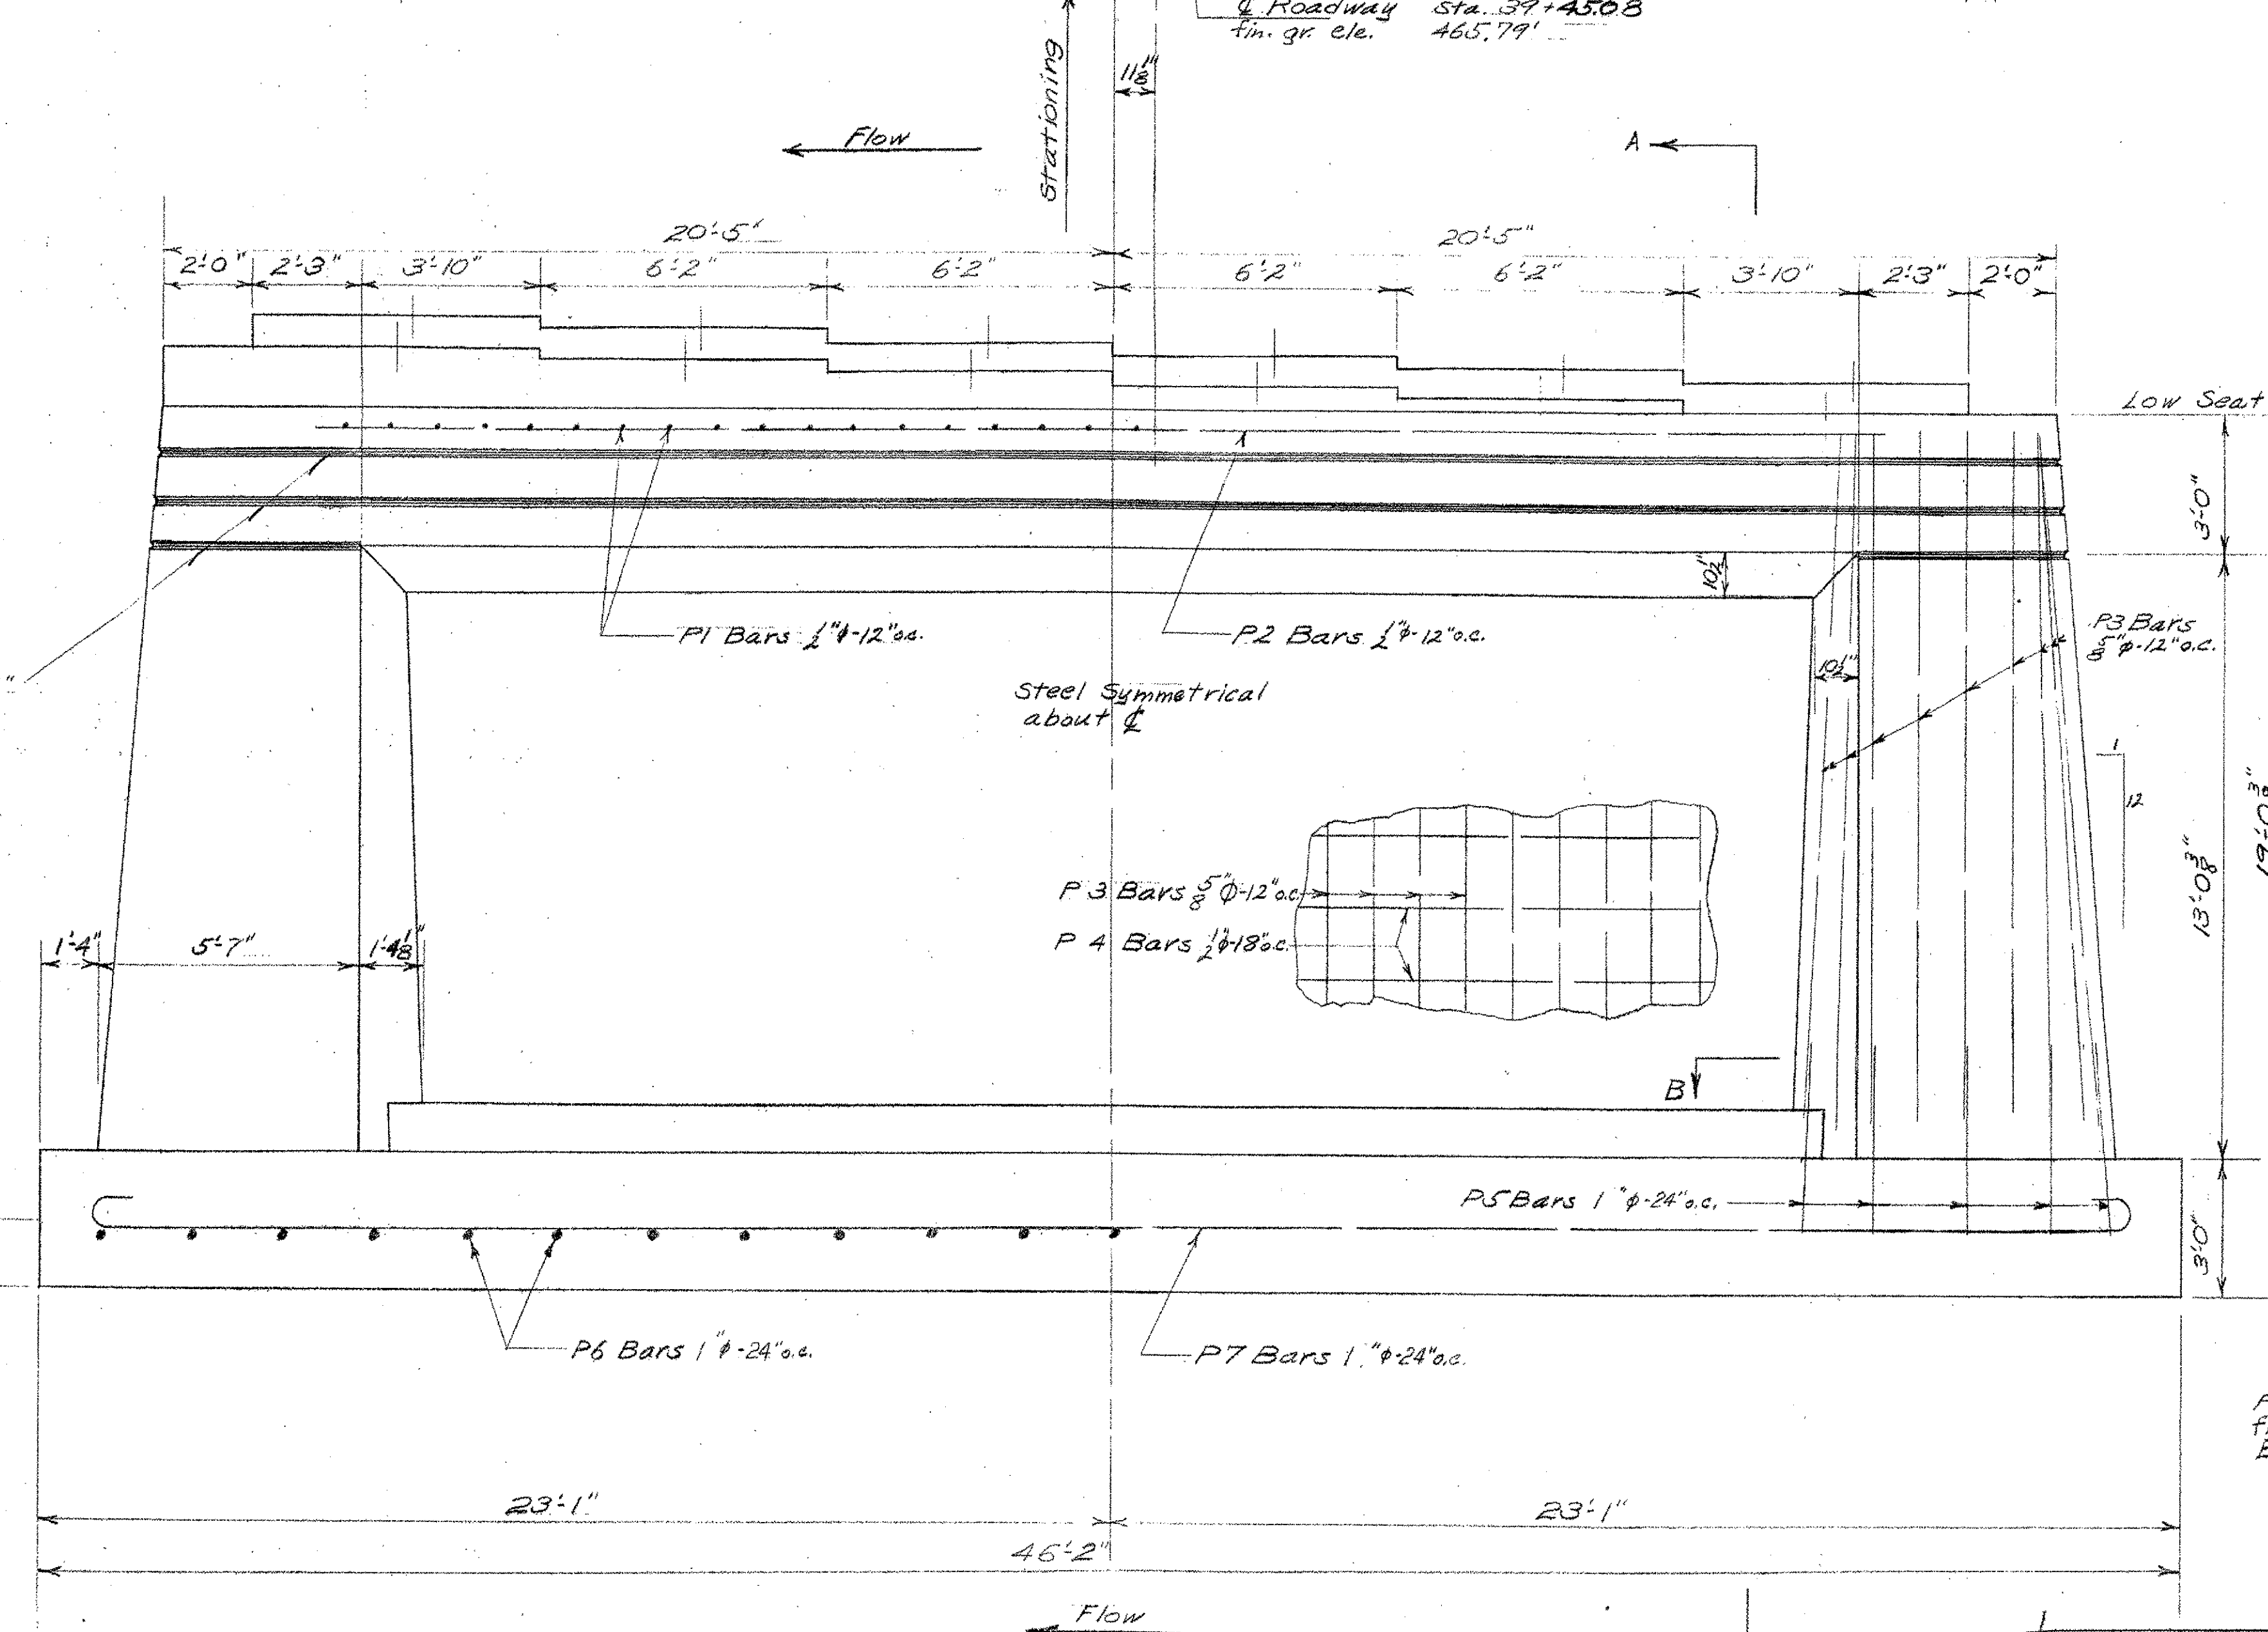

Pier to be founded on ledge, footing may be stepped in field under the direction of the Engineer. Steps to be made level.

REINFORCING STEEL REVISED	
Estimated Quantities	
Structure Excan. (Mod.)	54 CY.
Concrete Class C (Mod.)	130 CY.
Rein. Steel	4,304 lbs

MONTGOMERY
PIER No. 2
BRIDGE No. 19
Scale 3/8" = 1'

REFERENCE SHEET ONLY

MONTGOMERY
BHF 0283(8)S
VT RTE. 118 OVER THE TROUT RIVER
SHEET 43 OF 45
FOR INFORMATION PURPOSES ONLY