


METRIC


METRIC

1. ALL DIMENSIONS ARE IN MILLIMETERS UNLESS OTHERWISE NOTED.  
2. ALL WEIGHTS ARE IN KILOGRAMS.

FED. ROAD DIV. NO.	STATE	FED. AID PROJ. NO.
	VT	

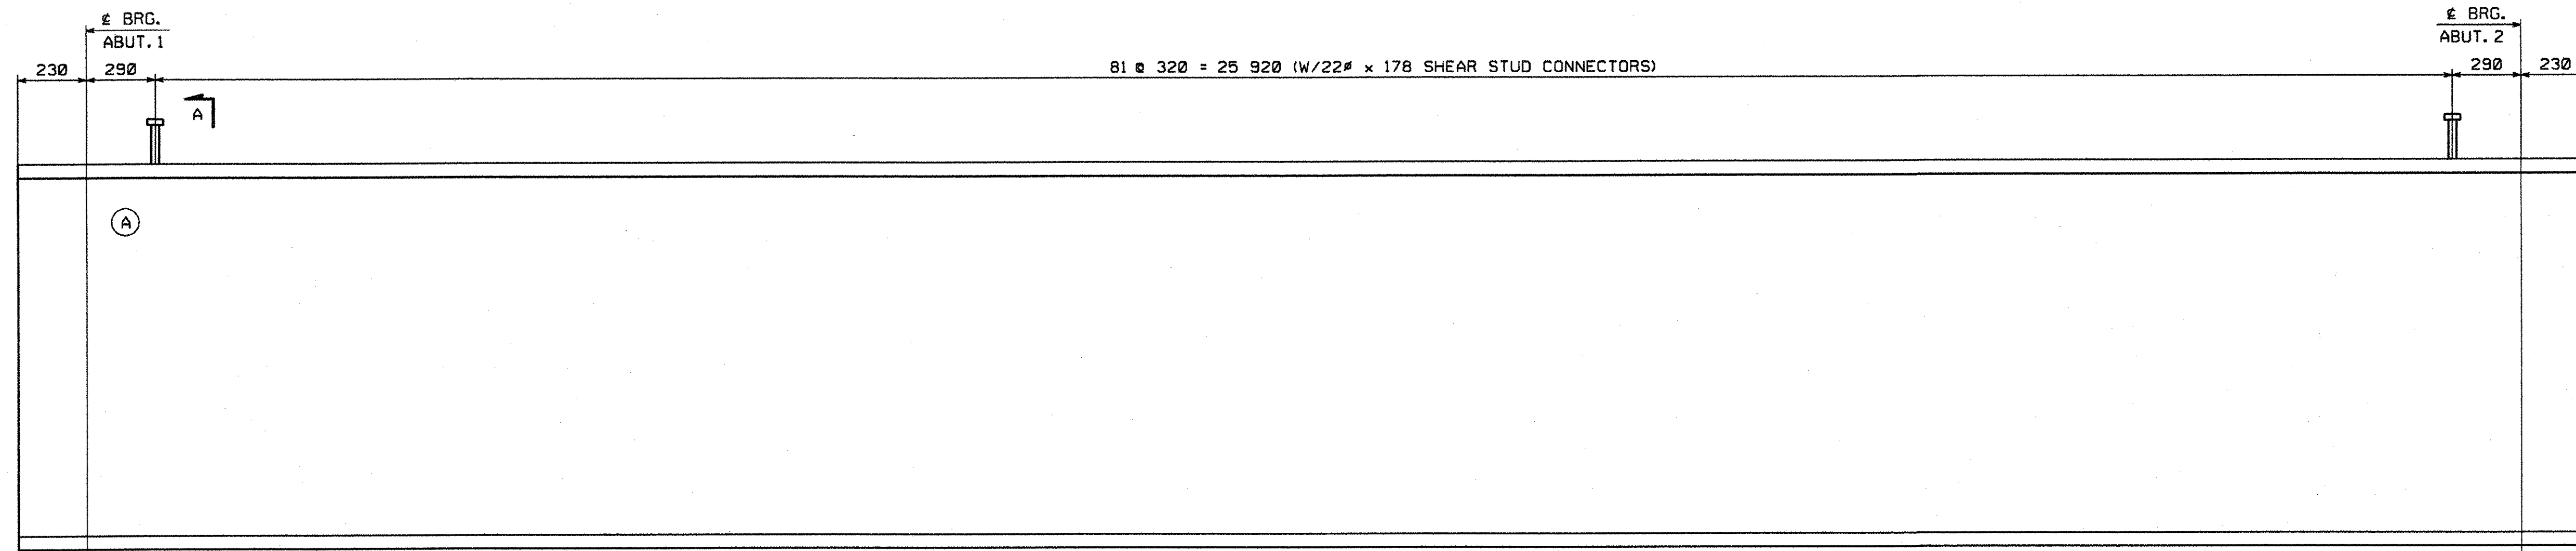

SHEAR STUD CONNECTOR LOCATION LAYOUT

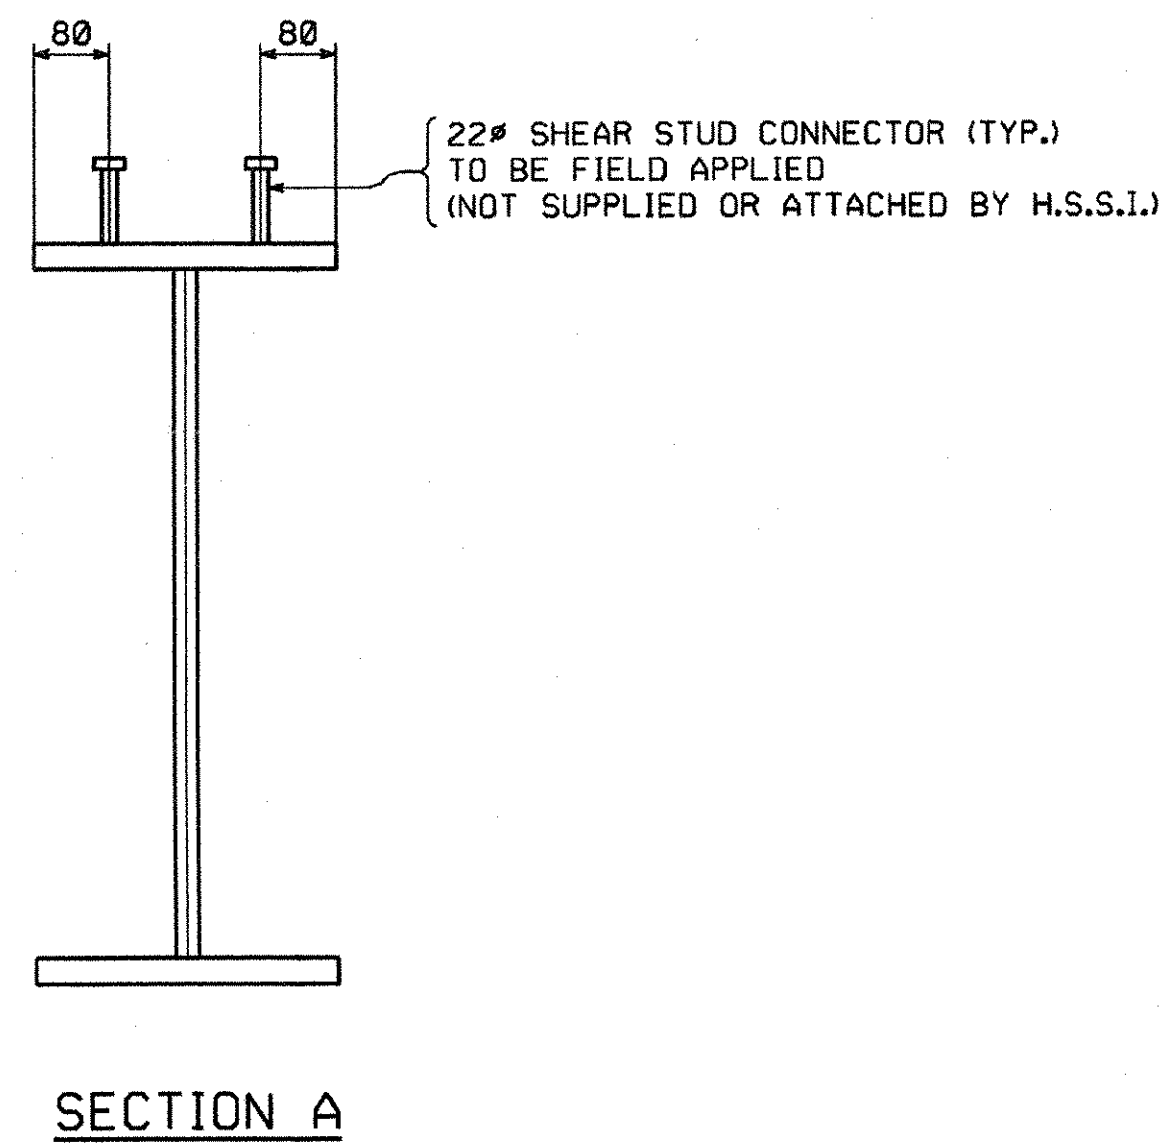


**NOTES:**

FOR NOTES, SEE DRAWING E1.  
WORK THIS DRAWING WITH DRAWING E1.  
Ⓐ INDICATES SUFFIX MARK OF SHIPPING PIECE.

**RECEIVED**  
 CK'D BY: WJK OK'D BY: \_\_\_\_\_  
 APR 27 2006  
 RESUBMIT \_\_\_\_\_ APPROVED   
 BY: RRL DATE: 5/2/06

△			
△			
△			
NO.	REVISION	BY	DATE

**HIGH STEEL STRUCTURES, INC.**  1770 Hempstead Road  
Lancaster, PA 17605-0008  
Phone 717/299-5211  
A Division of High Industries, Inc.

ERECTION FRAMING PLAN - STUD LAYOUTS  
 RTE. NO. TH 35 (BRIDGE NO. 24) OVER PACIFIC BROOK  
 RTE. NO. TH 35 STA. 1+085.800 TO STA. 1+112.300  
 TOWN OF MONTGOMERY  
 FRANKLIN COUNTY, VERMONT  
 STATE OF VERMONT, AGENCY OF TRANSPORTATION

STATE CONTRACT OR REF. NO. PROJECT NO. BRO 1448 (20)  
 CONTRACTOR A.L. ST. ONGE CONTRACTOR, INC.  
 IN CHARGE: BRITIGAN (IH) MADE BY: RC CHK'D BY: MOK DATE: 3/3/06  
 CONTRACT NUMBER: VT-06001-1 DRAWING NUMBER: E2 OF E2

BY: Mkrandel  
PLOTTED: 03/06/06 09:30:11 AM

05/25/06