


METRIC

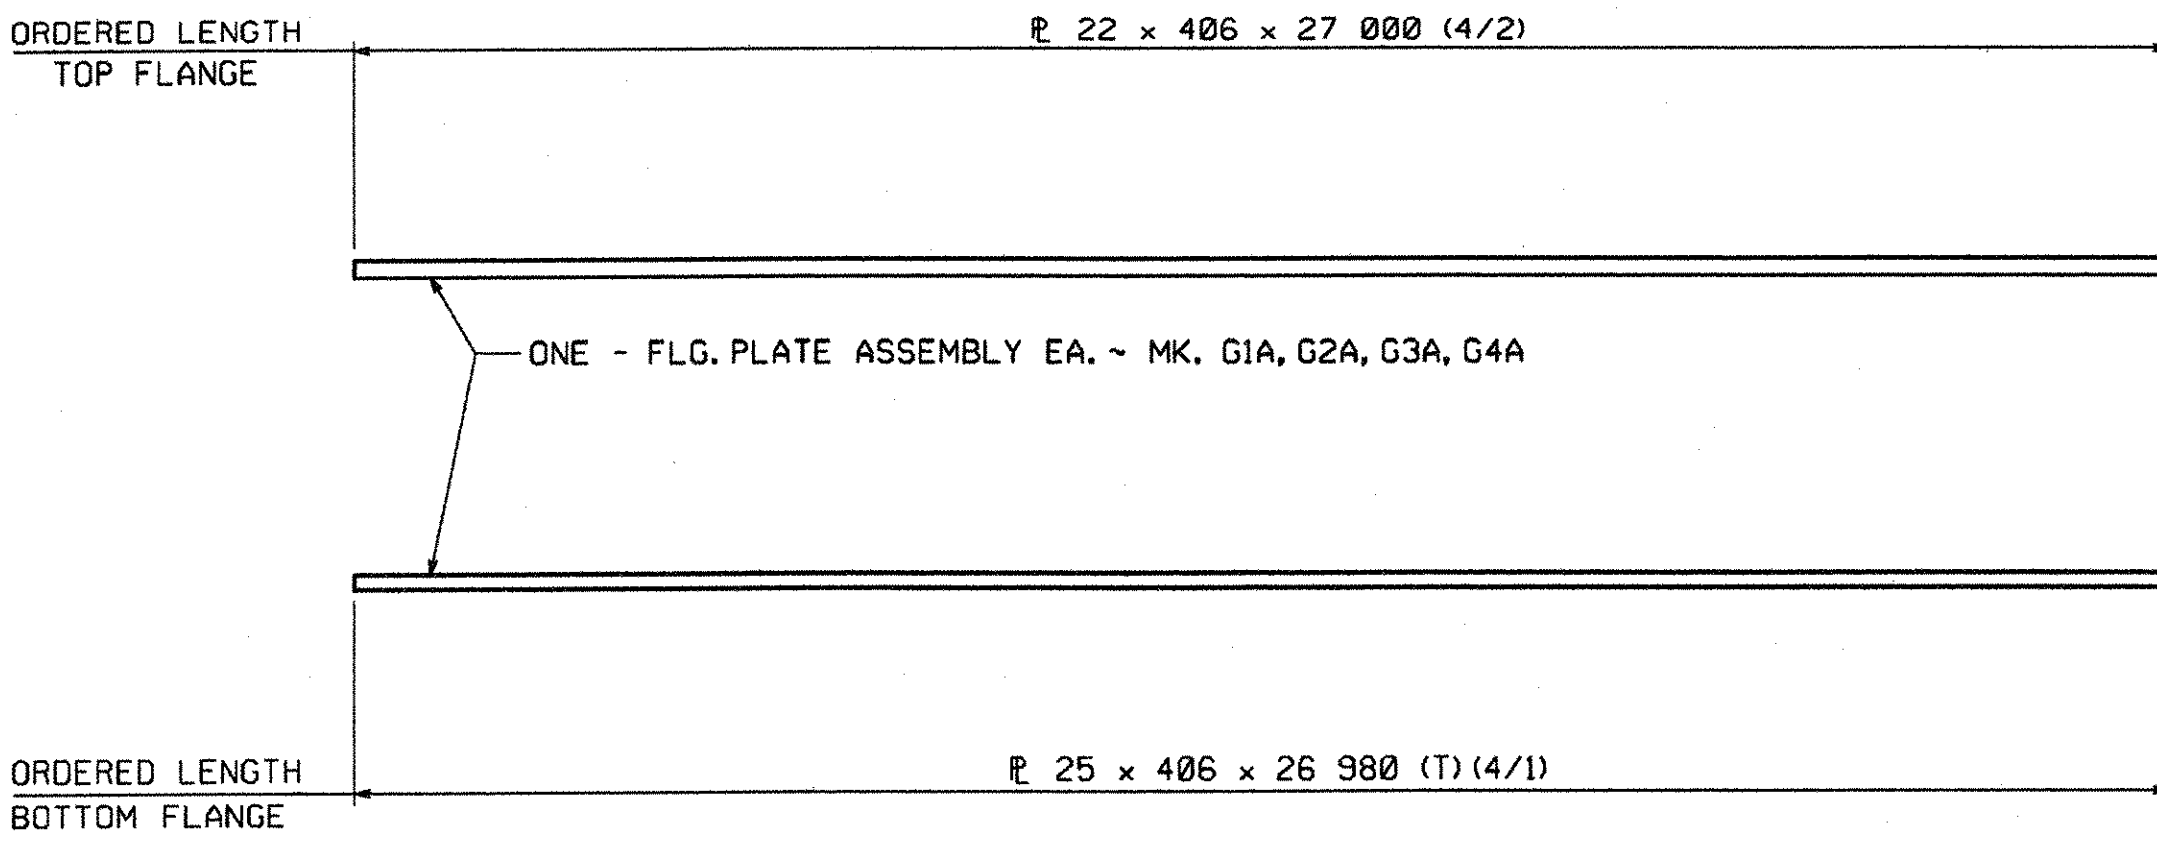

**METRIC** 1. ALL DIMENSIONS ARE IN MILLIMETERS UNLESS OTHERWISE NOTED.  
 2. ALL WEIGHTS ARE IN KILOGRAMS.

FED. ROAD DIV. NO.	STATE	FED. AID PROJ. NO.
	VT	

2 1


**NOTES:**

FOR GENERAL SHOP NOTES, SEE DRAWING GNL.  
 (T) INDICATES PLATES THAT REQUIRE CHARPY V-NOTCH TEST.

**RECEIVED**  
 OK'D BY: WJK OK'D BY: \_\_\_\_\_  
 APR 27 2006  
 RESUBMIT \_\_\_\_\_ APPROVED   
 BY KLU DATE 5/2/06

△			
△			
△			
NO.	REVISION	BY	DATE

1770 Hempstead Road  
 Lancaster, PA 17605-0008  
 Phone 717/299-5211

**HIGH STEEL STRUCTURES, INC.**   
 A Division of High Industries, Inc.

FLANGE SPLICE DETAILS  
 RTE. NO. TH 35 (BRIDGE NO. 24) OVER PACIFIC BROOK  
 RTE. NO. TH 35 STA. 1+085.800 TO STA. 1+112.300  
 TOWN OF MONTGOMERY  
 FRANKLIN COUNTY, VERMONT  
 STATE OF VERMONT, AGENCY OF TRANSPORTATION

STATE CONTRACT OR REF. NO. PROJECT NO. BRO 1448 (20)  
 CONTRACTOR A.L. ST. ONGE CONTRACTOR, INC.  
 IN CHARGE: BRITIGAN (IH) MADE BY: KMA CHK'D BY: SJA DATE: 2/13/06

CONTRACT NUMBER: VT-06001-1 DRAWING NUMBER: FS1 OF FS1

CODE:30

056 35

BY: Mkr-eidel  
 PLOTTED: 03/06/06 08:47:46 AM

60