


METRIC


METRIC

1. ALL DIMENSIONS ARE IN MILLIMETERS UNLESS OTHERWISE NOTED.
2. ALL WEIGHTS ARE IN KILOGRAMS.

FED. ROAD DIV. NO.	STATE	FED. AID PROJ. NO.
	VT	

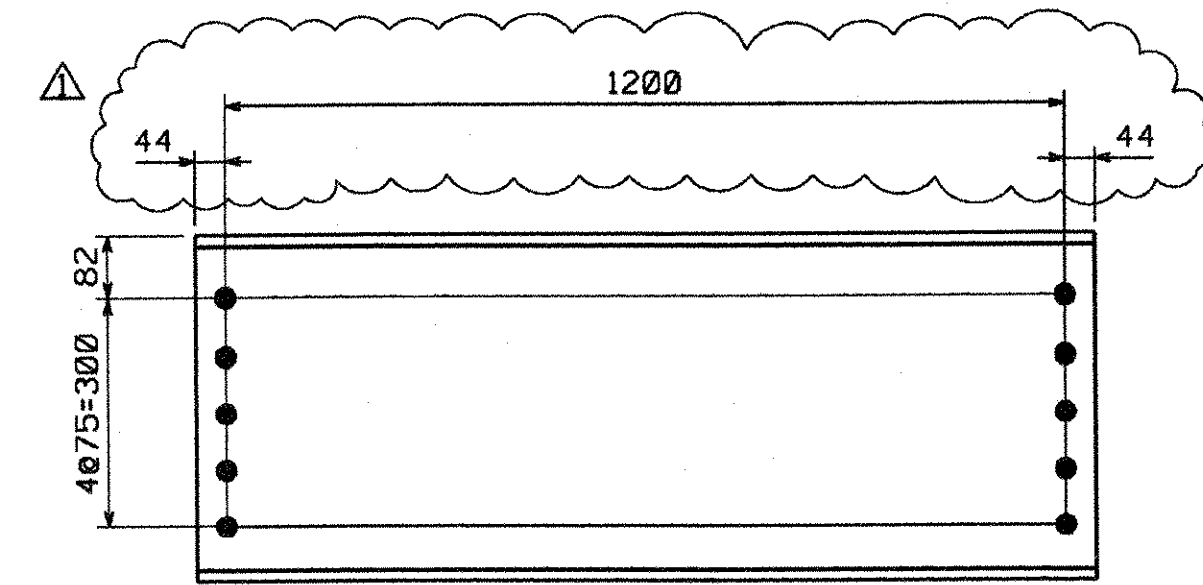

DIAPHRAGM ~ MK. D1

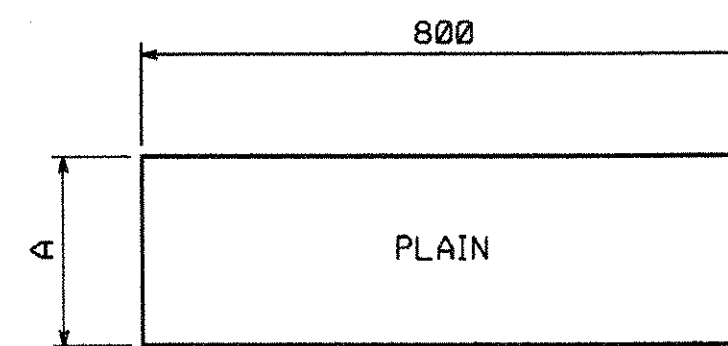

MISC. END PLATE
(CODE: 30)

MARK	A
M1	244
M2	247

BILL OF MATERIAL

SHIP. EA.	QTY	MARK	COMMODITY	DESCRIPTION	LENGTH	SPEC	GRADE	TEST	REMARKS	GRP.	ITEM	SHIP WEIGHT EA.
DIAPHRAGM												
1	12	D1	MC	460 x 63.5	1288	M270M	345W		(MC18 x 42.7)	10	1	81.79
MISC. END PLATES												
1	4	M1	PL	6 x 244	800	M270M	345W			7	3	9.19
1	4	M2	PL	6 x 247	800	M270M	345W			7	3	9.31

TOTAL WEIGHT THIS SHEET: 1055.45 kg



RECEIVED

CK'D BY: WJH OK'D BY: _____
 APR 27 2006
 RESUBMIT: _____ APPROVED:
 BY: JRC DATE: 5/1/06

△			
△	REVISOR	BY	DATE
1	REVISOR	BY	DATE
1	REVISOR	BY	DATE

1770 Hempstead Road
Lancaster, PA 17605-0008
Phone 717/299-5281

HIGH STEEL STRUCTURES, INC.

A Division of High Industries, Inc.

SHOP NOTE

HOLES: 1 5/16"
 BOLTS: NONE
 PAINT: NONE
 FOR GENERAL SHOP NOTES, SEE DWG. G01.

DIAPHRAGM & MISC. END PLATES	D1, M1 & M2
RTE. NO. TH 35 (BRIDGE NO. 24) OVER PACIFIC BROOK	
RTE. NO. TH 35 STA. 1+085.800 TO STA. 1+112.300	
TOWN OF MONTGOMERY	
FRANKLIN COUNTY, VERMONT	
STATE OF VERMONT, AGENCY OF TRANSPORTATION	
STATE CONTRACT OR REF. NO.	PROJECT NO. BRO 1448 (20)
CONTRACTOR	A.L. ST. ONGE CONTRACTOR, INC.
IN CHARGE: BRITIGAN (IH)	MADE BY: RC
CHK'D BY: MGK	DATE: 3/3/06
CONTRACT NUMBER: VT-06001-1	DRAWING NUMBER: 1 OF 5

CODE:56 (U.N.) 30

CONTRACT NUMBER: VT-06001-1 DRAWING NUMBER: 1 OF 5

06133

BY: choffe

PLOTTED: 04/19/06 03:55:26 PM

68