

646.40 DURABLE 100 mm WHITE LINE

BARRE CITY:
STA. 4+010.0 - STA. 4+040.0 RT, DOTTED LINE

646.60 TEMPORARY 100 mm WHITE LINE

BARRE CITY:
STA. 4+010.0 - STA. 4+040.0 RT, DOTTED LINE

646.43 DURABLE 200 mm YELLOW LINE

BARRE CITY:
STA. 3+990.0 - STA. 4+040.0 HATCHED MEDIAN (55.0 m)

646.41 DURABLE 100 mm YELLOW LINE

(ALL LINES WILL INCLUDE C/L BREAKS FOR TOWN HIGHWAYS) S=SOLID, D=DASHED

BARRE CITY:
STA. 3+860.0 - STA. 3+978.0 LT S
STA. 3+918.753 DOUBLE SOLID RT, COLLEGE STREET
STA. 3+955.768 DOUBLE SOLID LT, BOLSTER AVENUE
STA. 3+984.736 DOUBLE SOLID RT, LIBERTY STREET
STA. 3+990.0 - STA. 4+040.0 DOUBLE SOLID LT & RT (MEDIAN TAPER)

646.61 TEMPORARY 100 mm YELLOW LINE

(ALL LINES WILL INCLUDE C/L BREAKS FOR TOWN HIGHWAYS) S=SOLID, D=DASHED

BARRE CITY:
STA. 3+860.0 - STA. 3+978.0 LT S
STA. 3+918.753 DOUBLE SOLID RT, COLLEGE STREET
STA. 3+955.768 DOUBLE SOLID LT, BOLSTER AVENUE
STA. 3+984.736 DOUBLE SOLID RT, LIBERTY STREET
STA. 3+990.0 - STA. 4+040.0 DOUBLE SOLID LT & RT (MEDIAN TAPER)

646.46 DURABLE 600 mm STOP BAR

BARRE CITY:
STA. 3+918.753 RT, COLLEGE STREET
STA. 3+955.768 LT, BOLSTER AVENUE
STA. 3+984.736 RT, LIBERTY STREET

646.66 TEMPORARY 600 mm STOP BAR

BARRE CITY:
STA. 3+918.753 RT, COLLEGE STREET
STA. 3+955.768 LT, BOLSTER AVENUE
STA. 3+984.736 RT, LIBERTY STREET

646.50 DURABLE LETTER OR SYMBOL

BARRE CITY:
STA. 3+918.753 RT, COLLEGE STREET, "S,T,O,P" (4 EA)
STA. 3+955.768 LT, BOLSTER AVENUE, "S,T,O,P" (4 EA)
STA. 3+963.9 RT, "S,I,G,N,A,L" (6 EA)
STA. 3+976.1 RT, "A,H,E,A,D" (5 EA)
STA. 3+984.736 RT, LIBERTY STREET, "S,T,O,P" (4 EA)

646.70 TEMPORARY LETTER OR SYMBOL

BARRE CITY:
STA. 3+918.753 RT, COLLEGE STREET, "S,T,O,P" (8 EA)
STA. 3+955.768 LT, BOLSTER AVENUE, "S,T,O,P" (8 EA)
STA. 3+963.9 RT, "S,I,G,N,A,L" (12 EA)
STA. 3+976.1 RT, "A,H,E,A,D" (10 EA)
STA. 3+984.736 RT, LIBERTY STREET, "S,T,O,P" (8 EA)

646.51 DURABLE CROSSWALK MARKINGS WITH DIAGONAL LINES (MOD.)

BARRE CITY:
STA. 3+878.519 LT, HIGHLAND AVENUE
STA. 3+918.753 RT, COLLEGE STREET
STA. 3+955.768 LT, BOLSTER AVENUE
STA. 3+984.736 RT, LIBERTY STREET

646.71 TEMPORARY CROSSWALK MARKINGS WITH DIAGONAL LINES (MOD.)

BARRE CITY:
STA. 3+878.519 LT, HIGHLAND AVENUE
STA. 3+918.753 RT, COLLEGE STREET
STA. 3+955.768 LT, BOLSTER AVENUE
STA. 3+984.736 RT, LIBERTY STREET

646.81 PAINTED CURB

BARRE CITY:
STA. 3+866.0 - STA. 3+872.0 LT
STA. 3+885.0 - STA. 3+891.0 LT
STA. 3+905.0 - STA. 3+911.0 RT
STA. 3+926.5 - STA. 3+932.5 RT
STA. 3+932.0 - STA. 3+949.5 LT
STA. 3+962.1 - STA. 3+968.1 LT
STA. 3+971.0 - STA. 3+978.0 RT
STA. 3+991.5 - STA. 3+997.5 RT


675.50 REMOVING SIGNS

AS SHOWN - 12

675.60 ERECTING SALVAGED SIGNS

AS SHOWN - 7

ARCHIVED
ON CADD

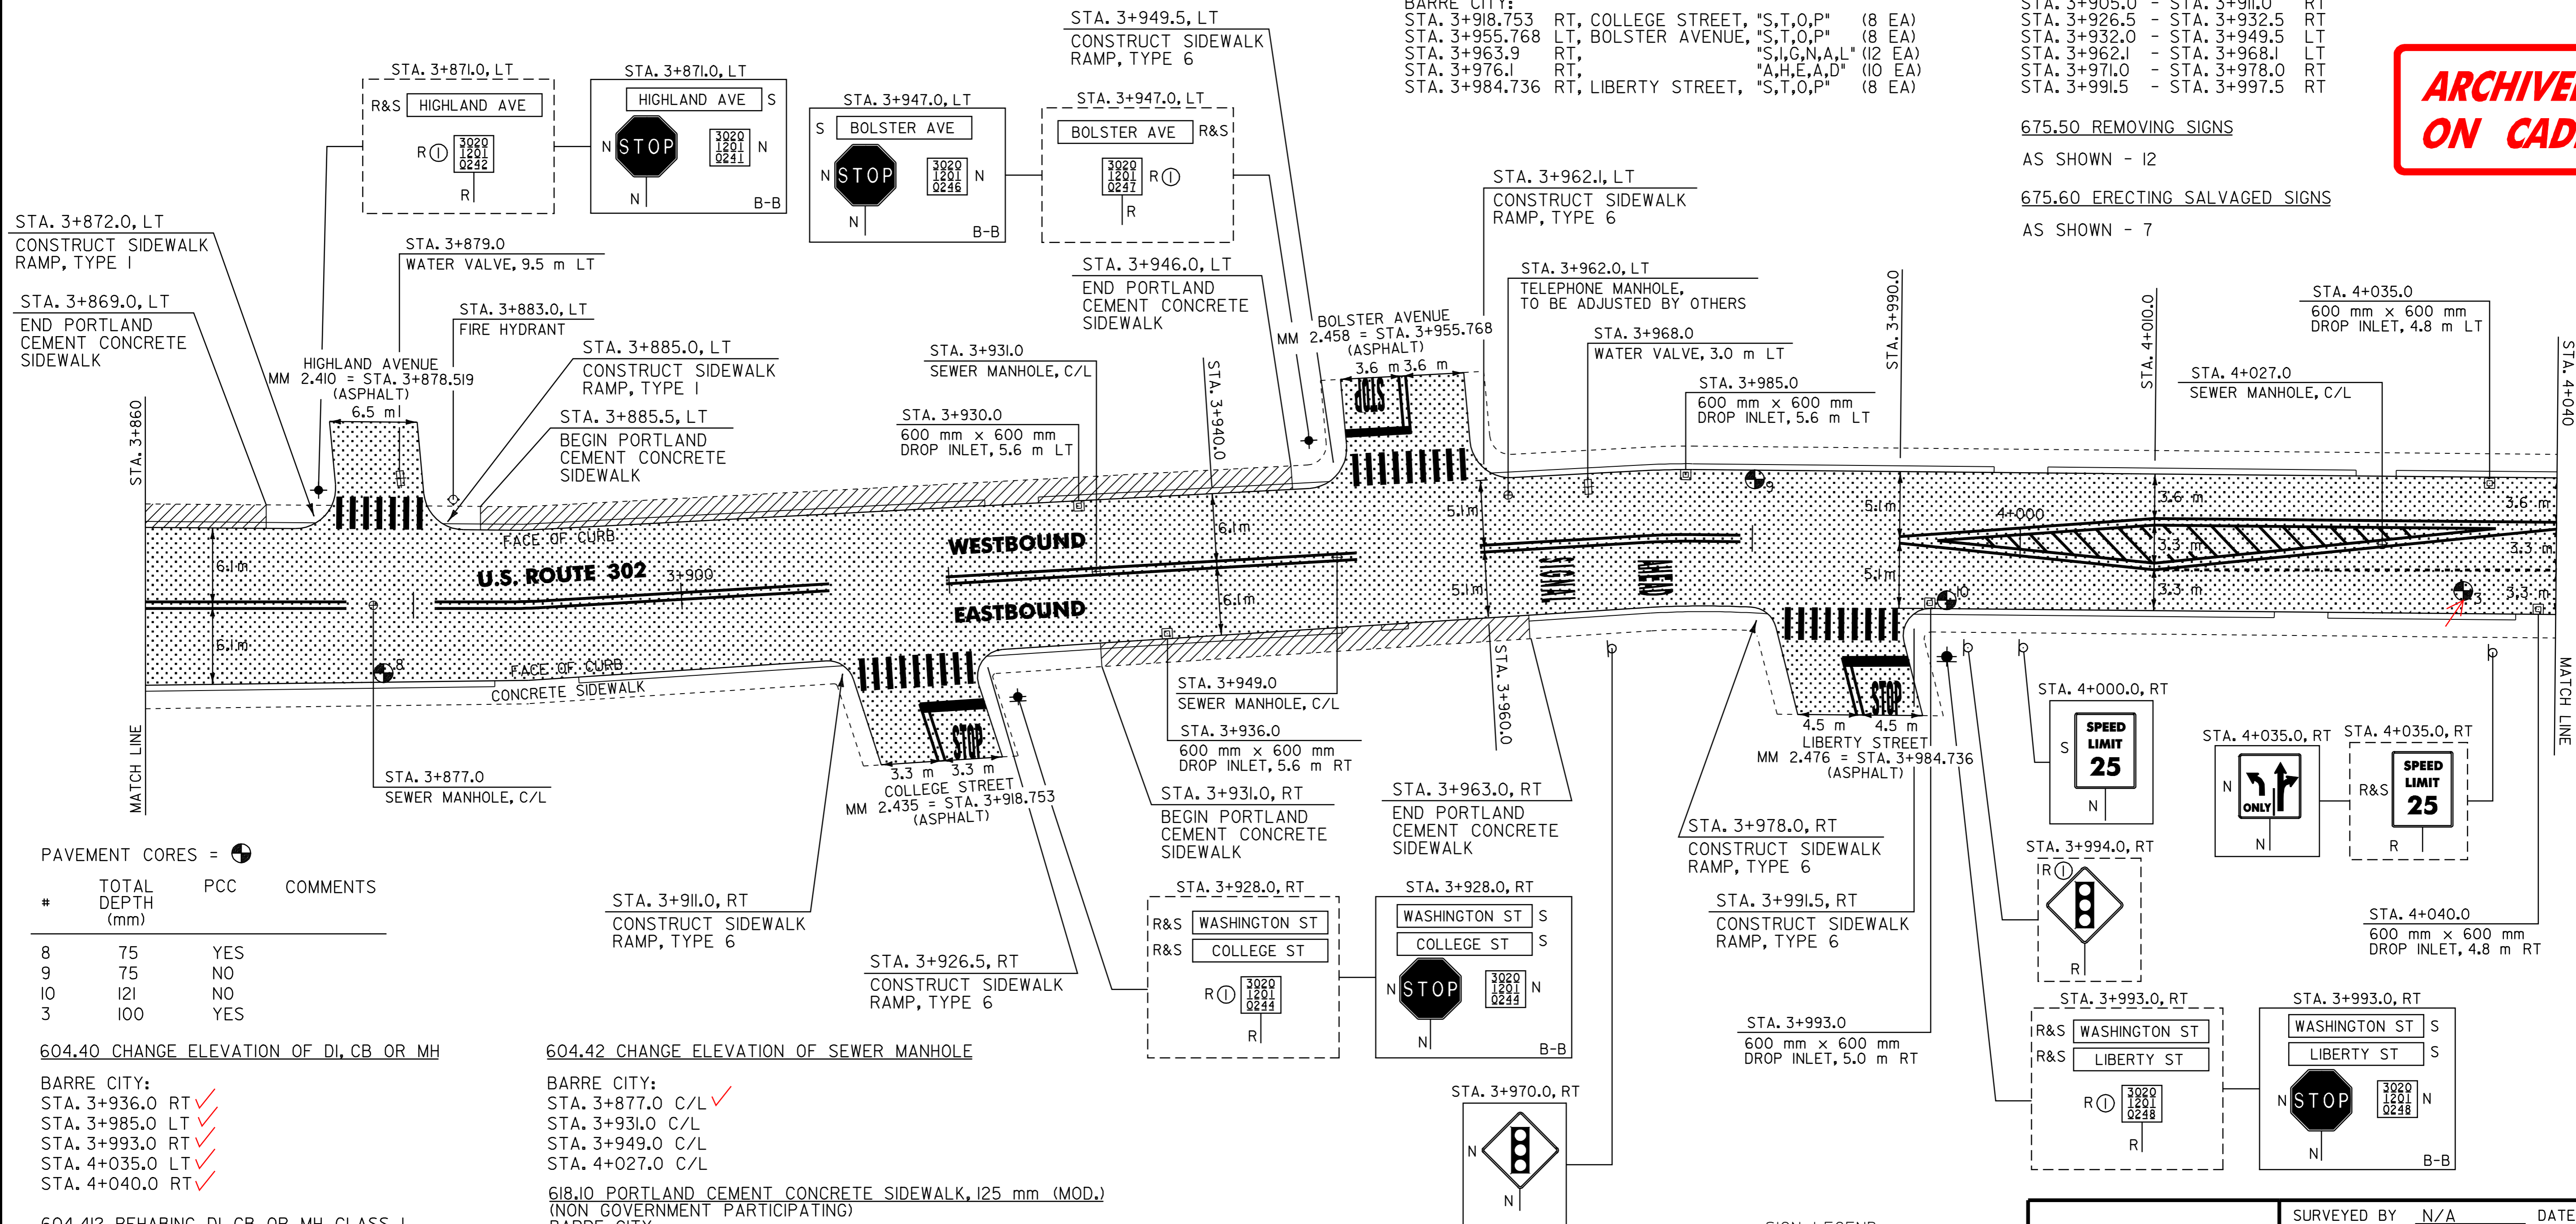

PAVEMENT CORES =

#	TOTAL DEPTH (mm)	PCC	COMMENTS
8	75	YES	
9	75	NO	
10	121	NO	
3	100	YES	

604.40 CHANGE ELEVATION OF DI, CB OR MH

BARRE CITY:
STA. 3+936.0 RT ✓
STA. 3+985.0 LT ✓
STA. 3+993.0 RT ✓
STA. 4+035.0 LT ✓
STA. 4+040.0 RT ✓

604.412 REHABING DI, CB OR MH, CLASS 1

BARRE CITY:
STA. 3+930.0 LT ✓

604.42 CHANGE ELEVATION OF SEWER MANHOLE

BARRE CITY:
STA. 3+877.0 C/L ✓
STA. 3+931.0 C/L
STA. 3+949.0 C/L
STA. 4+027.0 C/L

618.10 PORTLAND CEMENT CONCRETE SIDEWALK, 125 mm (MOD.)

(NON GOVERNMENT PARTICIPATING)
BARRE CITY:
STA. 3+860.0 - STA. 3+869.0 LT
STA. 3+885.5 - STA. 3+946.0 LT
STA. 3+931.0 - STA. 3+963.0 RT

629.20 ADJUST ELEVATION OF VALVE BOX

BARRE CITY:
STA. 3+879.0 LT ✓
STA. 3+968.0 LT ✓

NOTES:

- PAVING LIMIT ON ALL TOWN HIGHWAYS SHALL BE MEASURED 8 m BACK FROM U.S. ROUTE 302 FACE OF CURB UNLESS DENOTED OTHERWISE ON THE PLANS OR AS DIRECTED BY THE RESIDENT ENGINEER.
- SEE SHEET 31 OF 32 FOR SIDEWALK DETAILS.

SIGN LEGEND

R= REMOVE
S= SALVAGE
N= NEW
RET= RETAIN
B-B= BACK TO BACK
EXISTING= _____
NEW= _____
Ⓢ = SIGN TO BE RETURNED TO THE CITY OF BARRE

PAVING PROJECT LAYOUT # 4

SURVEYED BY N/A DATE N/A
 DRAWN BY C.A.K. DATE 2/02
 SQUAD LEADER D.E.G.
 DESIGN FILE NO. /pave/98d086/zd086.dgn
 IPARM FILE zd086p04.1 DATE 25-APR-2006 14
 PROJ. NAME BARRE CITY
 PROJ. NO. ST-STP 2102(I)S
 SHEET 13 OF 32 SHEETS

DATUM

VERTICAL	N/A
HORIZONTAL	N/A