

646.40 DURABLE 100 mm WHITE LINE
(ALL LINES WILL INCLUDE EDGE LINE BREAKS AND RADIUS FOR TOWN HIGHWAYS)

BARRE CITY:
STA. 4+740.0 - STA. 4+760.0 LT & RT

646.60 TEMPORARY 100 mm WHITE LINE
(ALL LINES WILL INCLUDE EDGE LINE BREAKS AND RADIUS FOR TOWN HIGHWAYS)

BARRE CITY:
STA. 4+740.0 - STA. 4+760.0 LT & RT

646.41 DURABLE 100 mm YELLOW LINE
(ALL LINES WILL INCLUDE C/L BREAKS FOR TOWN HIGHWAYS) S=SOLID, D=DASHED

BARRE CITY:
STA. 4+580.0 - STA. 4+760.0 LT S RT S
STA. 4+729.862 DOUBLE SOLID LT, WATERMAN STREET

646.61 TEMPORARY 100 mm YELLOW LINE
(ALL LINES WILL INCLUDE C/L BREAKS FOR TOWN HIGHWAYS) S=SOLID, D=DASHED

BARRE CITY:
STA. 4+580.0 - STA. 4+760.0 LT S RT S
STA. 4+729.862 DOUBLE SOLID LT, WATERMAN STREET

646.46 DURABLE 600 mm STOP BAR

BARRE CITY:
STA. 4+729.862 LT, WATERMAN STREET

646.66 TEMPORARY 600 mm STOP BAR

BARRE CITY:
STA. 4+729.862 LT, WATERMAN STREET

646.50 DURABLE LETTER OR SYMBOL

BARRE CITY:
STA. 4+580.0 LT, 'S,C,H,O,O,L' (6 EA)
STA. 4+729.862 LT, WATERMAN STREET, 'S,T,O,P' (4 EA)

646.70 TEMPORARY LETTER OR SYMBOL

BARRE CITY:
STA. 4+580.0 LT, 'S,C,H,O,O,L' (12 EA)
STA. 4+729.862 LT, WATERMAN STREET, 'S,T,O,P' (8 EA)

646.81 PAINTED CURB


BARRE CITY:
STA. 4+580.0 - STA. 4+583.0 RT

675.50 REMOVING SIGNS

AS SHOWN - 5

675.60 ERECTING SALVAGED SIGNS

AS SHOWN - 2

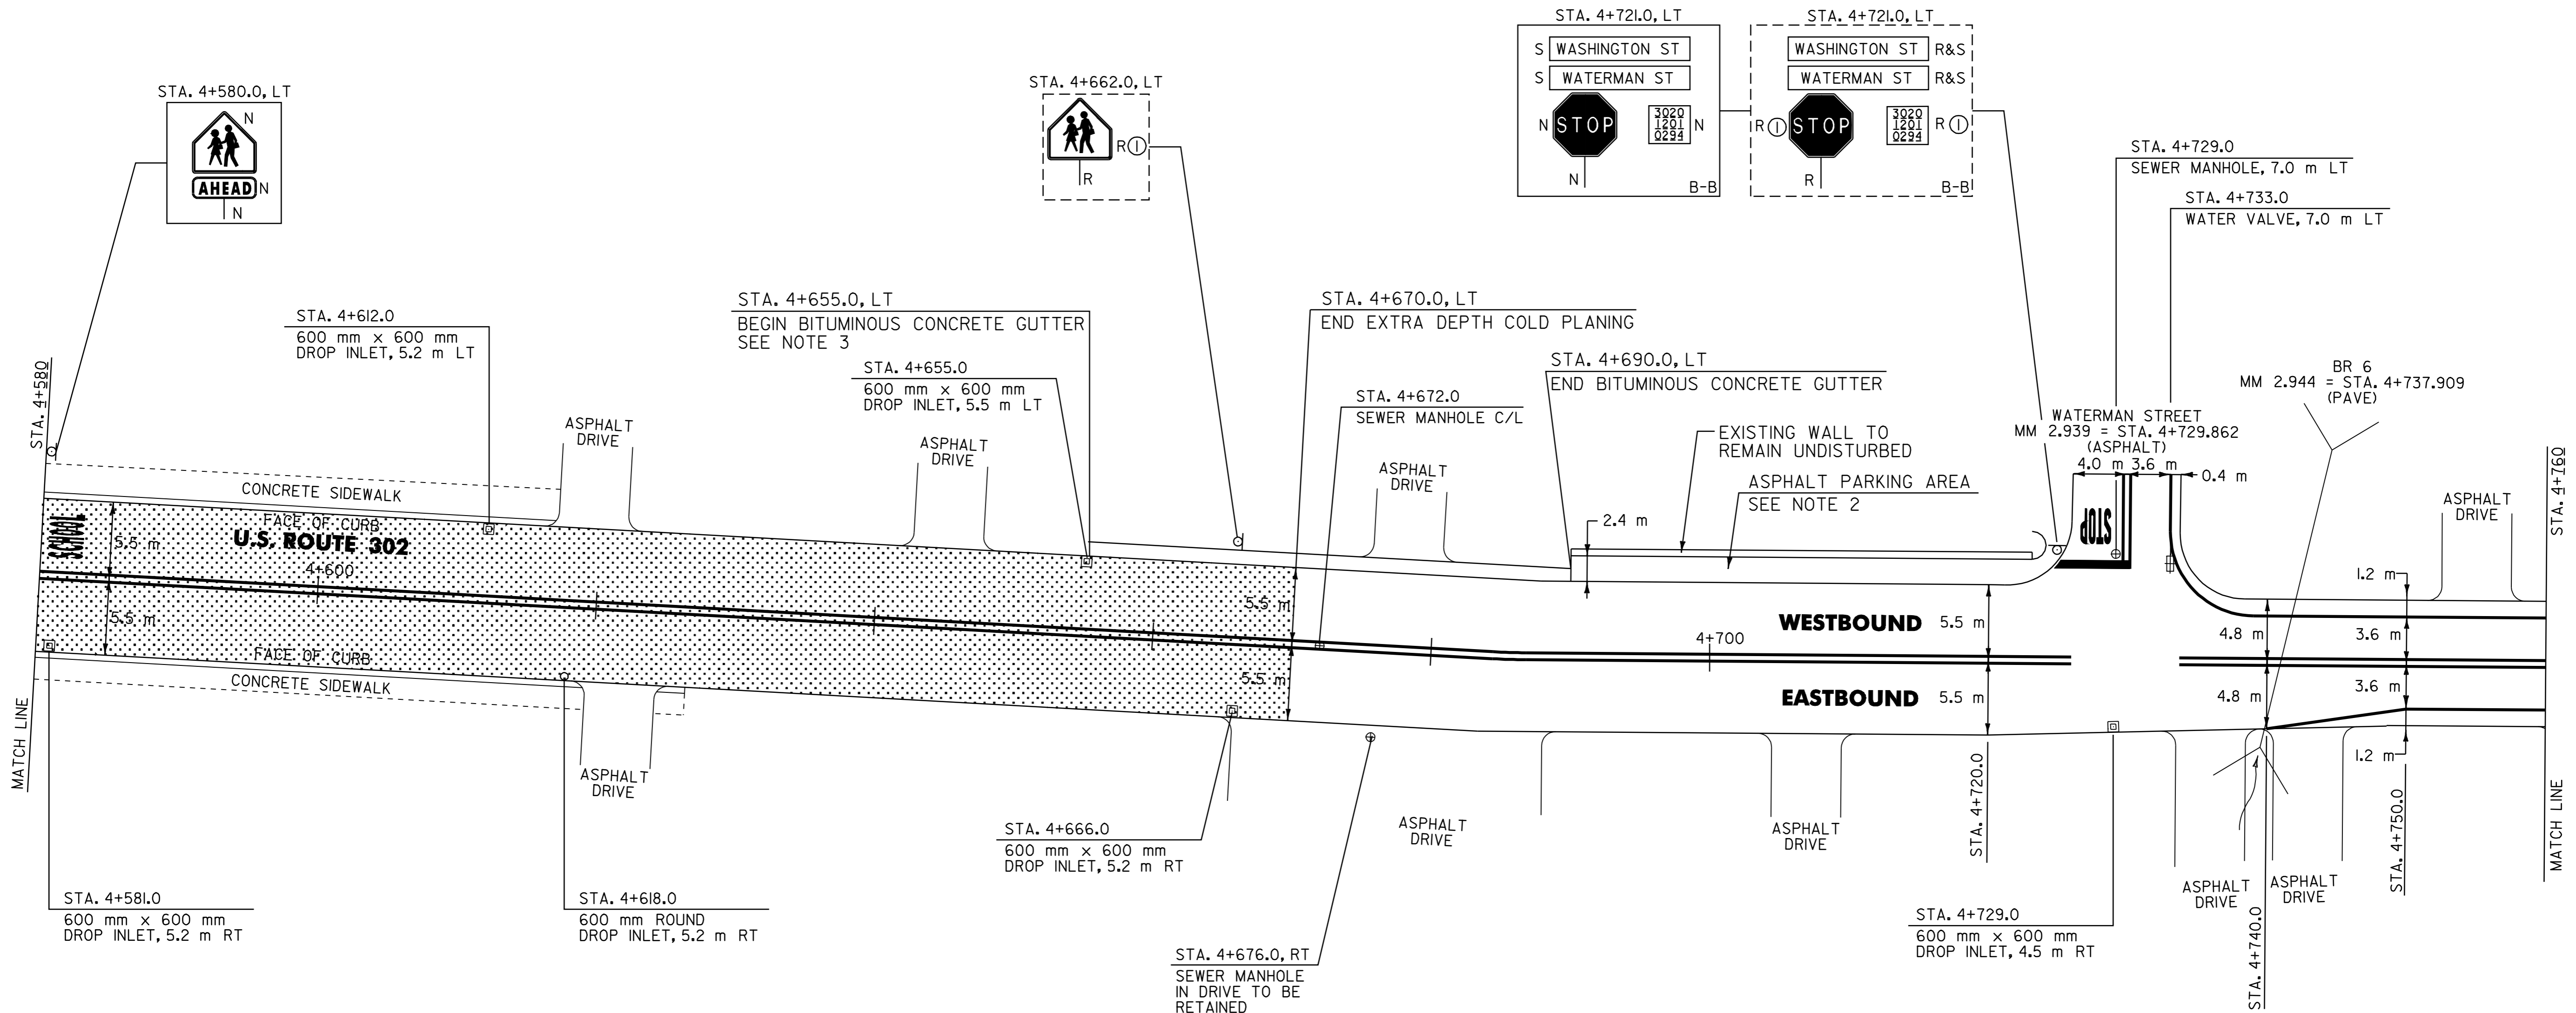

**ARCHIVED
ON CADD**

NOTES:

- PAVING LIMIT ON ALL TOWN HIGHWAYS SHALL BE MEASURED 8 m BACK FROM VT. ROUTE 302 EDGE OF SHOULDER UNLESS DENOTED OTHERWISE ON THE PLANS OR AS DIRECTED BY THE RESIDENT ENGINEER.
- COLD PLANE EXISTING ASPHALT PARKING AREA 40 mm AND PAVE WITH 40 mm TYPE IV. ANY REQUIRED EXCAVATION SHALL BE PERFORMED AS DIRECTED BY THE RESIDENT ENGINEER AND PAID FOR UNDER ITEM 210.10 OR 608.25.
- SEE SHEET 3 OF 32 FOR BITUMINOUS CONCRETE GUTTER DETAIL.

604.40 CHANGE ELEVATION OF DI, CB OR MH

BARRE CITY:
STA. 4+655.0 LT ✓
STA. 4+729.0 RT ✓

604.412 REHABING DI, CB OR MH, CLASS I

BARRE CITY:
STA. 4+581.0 RT ✓
STA. 4+612.0 LT ✓
STA. 4+618.0 RT ✓
STA. 4+666.0 RT ✓

604.42 CHANGE ELEVATION OF SEWER MANHOLE

BARRE CITY:
STA. 4+672.0 C/L ✓
STA. 4+729.0 LT ✓

616.47 BITUMINOUS CONCRETE GUTTERS AND TRAFFIC ISLANDS

BARRE CITY:
STA. 4+655.0 - STA. 4+690.0 LT (9.7 +)

629.20 ADJUST ELEVATION OF VALVE BOX

BARRE CITY:
STA. 4+733.0 LT ✓

SIGN LEGEND

- R= REMOVE
- S= SALVAGE
- N= NEW
- RET= RETAIN
- B-B= BACK TO BACK
- EXISTING= -----
- NEW= _____
- ⊙ = SIGN TO BE RETURNED TO THE CITY OF BARRE

**PAVING
PROJECT
LAYOUT
8**

SURVEYED BY	N/A	DATE	N/A
DRAWN BY	C.A.K.	DATE	2/02
SQUAD LEADER	D.E.G.		
DESIGN FILE NO.	/pave/98d086/zd086.dgn		
IPARM FILE	zd086p08.i	DATE	25-APR-2006 14
PROJ. NAME	BARRE CITY		
PROJ. NO.	ST-STP 2102(I)S		
SHEET 17 OF 32	SHEETS		

DATUM	
VERTICAL	N/A
HORIZONTAL	N/A