


646.40 DURABLE 100 mm WHITE LINE
 (ALL LINES WILL INCLUDE EDGE LINE BREAKS AND RADIUS FOR TOWN HIGHWAYS)
 BARRE CITY:
 STA. 4+760.0 - STA. 4+940.0 LT & RT

646.41 DURABLE 100 mm YELLOW LINE
 (ALL LINES WILL INCLUDE C/L BREAKS FOR TOWN HIGHWAYS) S=SOLID, D=DASHED
 BARRE CITY:
 STA. 4+760.0 - STA. 4+940.0 LT S C RT S

646.60 TEMPORARY 100 mm WHITE LINE
 (ALL LINES WILL INCLUDE EDGE LINE BREAKS AND RADIUS FOR TOWN HIGHWAYS)
 BARRE CITY:
 STA. 4+760.0 - STA. 4+940.0 LT & RT

646.61 TEMPORARY 100 mm YELLOW LINE
 (ALL LINES WILL INCLUDE C/L BREAKS FOR TOWN HIGHWAYS) S=SOLID, D=DASHED
 BARRE CITY:
 STA. 4+760.0 - STA. 4+940.0 LT S C RT S

**ARCHIVED
ON CADD**

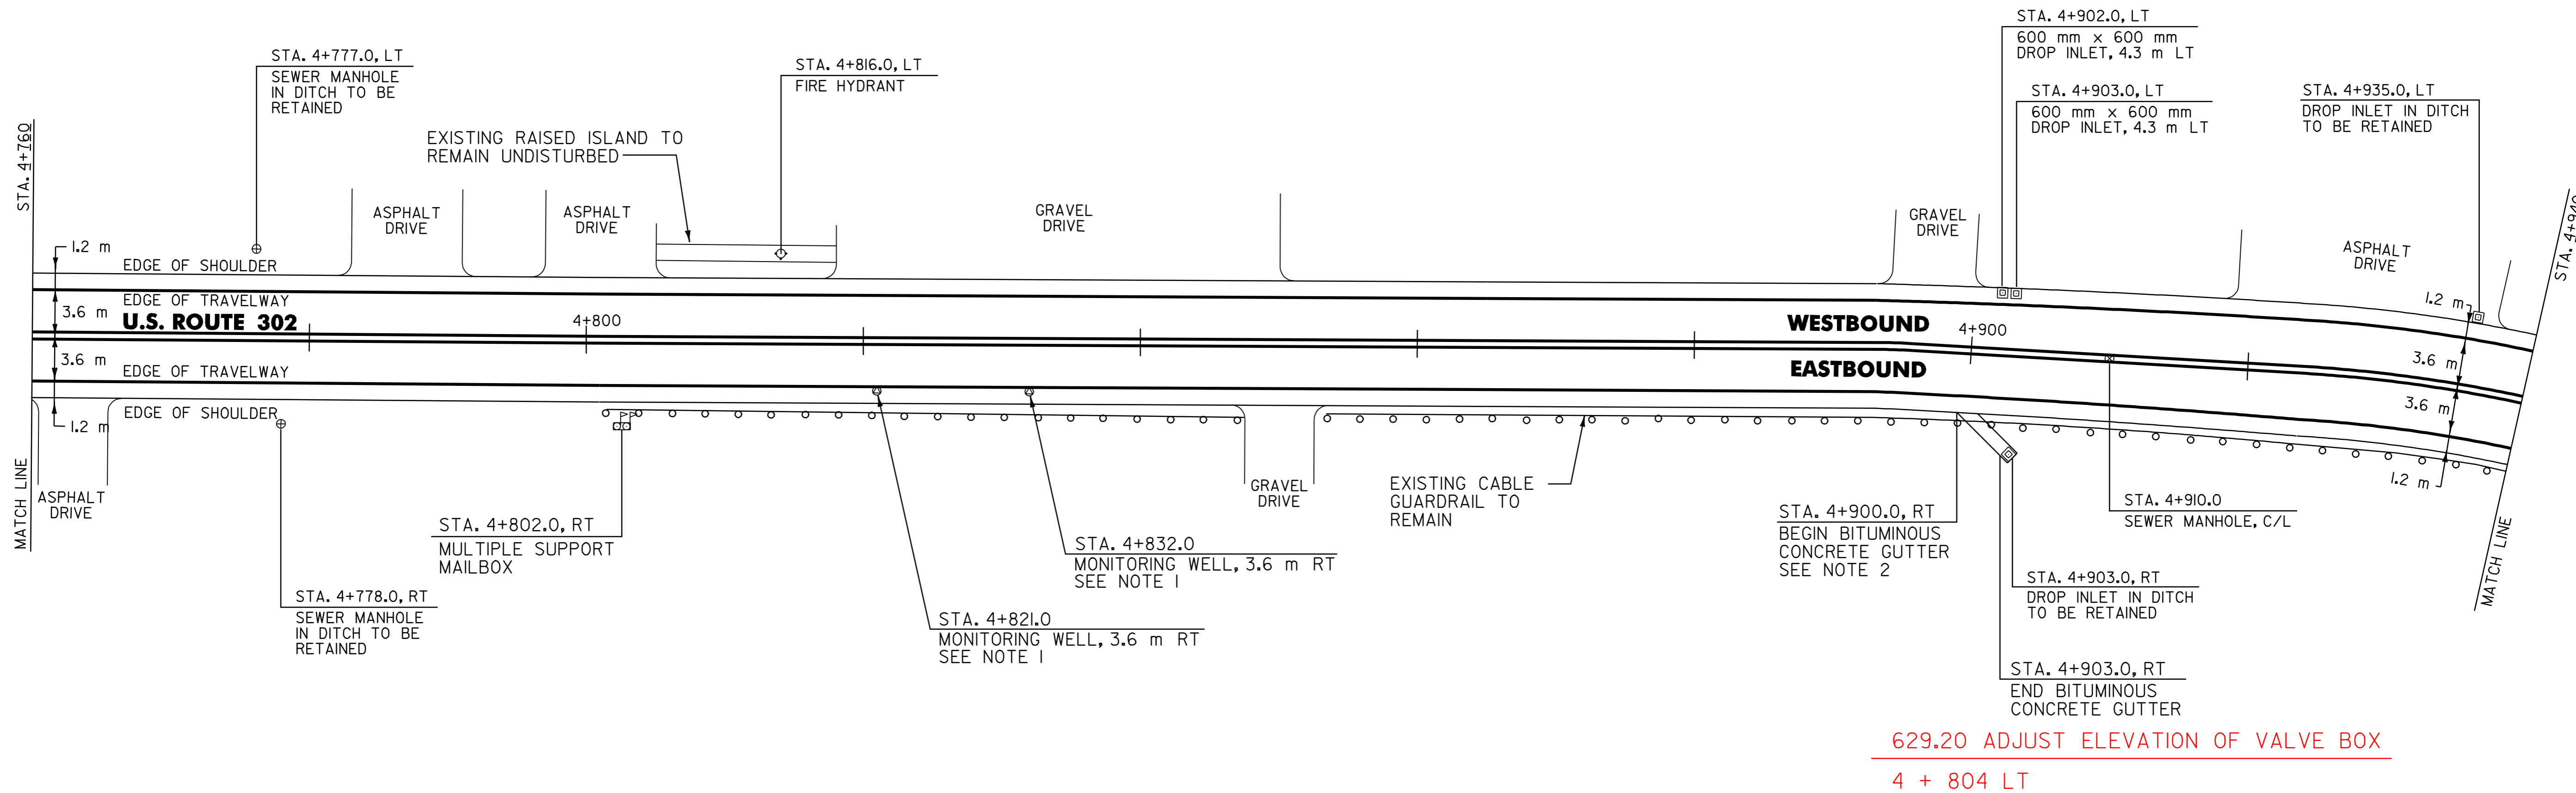

629.20 ADJUST ELEVATION OF VALVE BOX
 4 + 804 LT

- NOTES:
- EXISTING MONITORING WELLS IN PAVEMENT TO REMAIN UNDISTURBED.
 - PLACE 1-40 mm TYPE IV BITUMINOUS CONCRETE PAVEMENT LIFT ON THE EXISTING BITUMINOUS CONCRETE GUTTER. PAYMENT FOR THIS WORK WILL BE UNDER ITEM 616.47 BITUMINOUS CONCRETE GUTTERS AND TRAFFIC ISLANDS.

604.40 CHANGE ELEVATION OF DI, CB OR MH
 BARRE CITY:
 STA. 4+902.0 LT
 STA. 4+903.0 LT

604.42 CHANGE ELEVATION OF SEWER MANHOLE
 BARRE CITY:
 STA. 4+910.0 C/L

616.35 TREATED TIMBER CURB
 BARRE CITY:
 STA. 4+870.0 - STA. 4+900.0 RT (30.0 m)
 STA. 4+905.0 - STA. 4+940.0 RT (35.0 m)

627.12 RELOCATE MAILBOX, MULTIPLE SUPPORT
 BARRE CITY:
 STA. 4+802.0 RT

616.47 BITUMINOUS CONCRETE GUTTERS AND TRAFFIC ISLANDS
 BARRE CITY:
 STA. 4+900.0 - STA. 4+903.0 RT (0.6 m)

621.17 CABLE GUARDRAIL (MOD.)
 BARRE CITY:
 STA. 4+807.1 - STA. 4+837.1 RT (30.0 m)

621.65 ANCHOR FOR CABLE RAIL
 BARRE CITY:
 STA. 4+807.1 RT
 STA. 4+837.1 RT

621.81 REMOVAL AND DISPOSAL OF GUARDRAIL
 BARRE CITY:
 STA. 4+802.0 - STA. 4+846.0 RT (44.0 m)

DATUM	
VERTICAL	N/A
HORIZONTAL	N/A

**PAVING
PROJECT
LAYOUT
9**

SURVEYED BY	N/A	DATE	N/A
DRAWN BY	C.A.K.	DATE	2/02
SQUAD LEADER	D.E.G.		
DESIGN FILE NO.	/pave/98d086/zd086.dgn		
IPARM FILE	zd086p09.1	DATE PLOTTED	25-APR-2006 14
PROJ. NAME	BARRE CITY		
PROJ. NO.	ST-STP 2102(IIS)		
SHEET 18 OF 32	SHEETS		