

621.81 REMOVAL AND DISPOSAL OF GUARDRAIL

BARRE CITY:
STA. 5+248.0 - STA. 5+300.0 RT (52.0 m)

621.20 STEEL BEAM GUARDRAIL WITH 2.4 m POSTS (MOD.)

BARRE CITY:
STA. 5+250.9 - STA. 5+300.0 RT (49.1m)

621.505 MANUFACTURED TERMINAL SECTION (FLARED)

BARRE CITY:
STA. 5+239.5 - STA. 5+250.9 RT

646.40 DURABLE 100 mm WHITE LINE
(ALL LINES WILL INCLUDE EDGE LINE BREAKS AND RADIUS FOR TOWN HIGHWAYS)

BARRE CITY:
STA. 5+120.0 - STA. 5+300.0 LT & RT

646.60 TEMPORARY 100 mm WHITE LINE
(ALL LINES WILL INCLUDE EDGE LINE BREAKS AND RADIUS FOR TOWN HIGHWAYS)


BARRE CITY:
STA. 5+120.0 - STA. 5+300.0 LT & RT

646.41 DURABLE 100 mm YELLOW LINE
(ALL LINES WILL INCLUDE C/L BREAKS FOR TOWN HIGHWAYS) S=SOLID, D=DASHED

BARRE CITY:
STA. 5+120.0 - STA. 5+300.0 LT C RT S - S

646.61 TEMPORARY 100 mm YELLOW LINE
(ALL LINES WILL INCLUDE C/L BREAKS FOR TOWN HIGHWAYS) S=SOLID, D=DASHED

BARRE CITY:
STA. 5+120.0 - STA. 5+300.0 LT C RT S - S

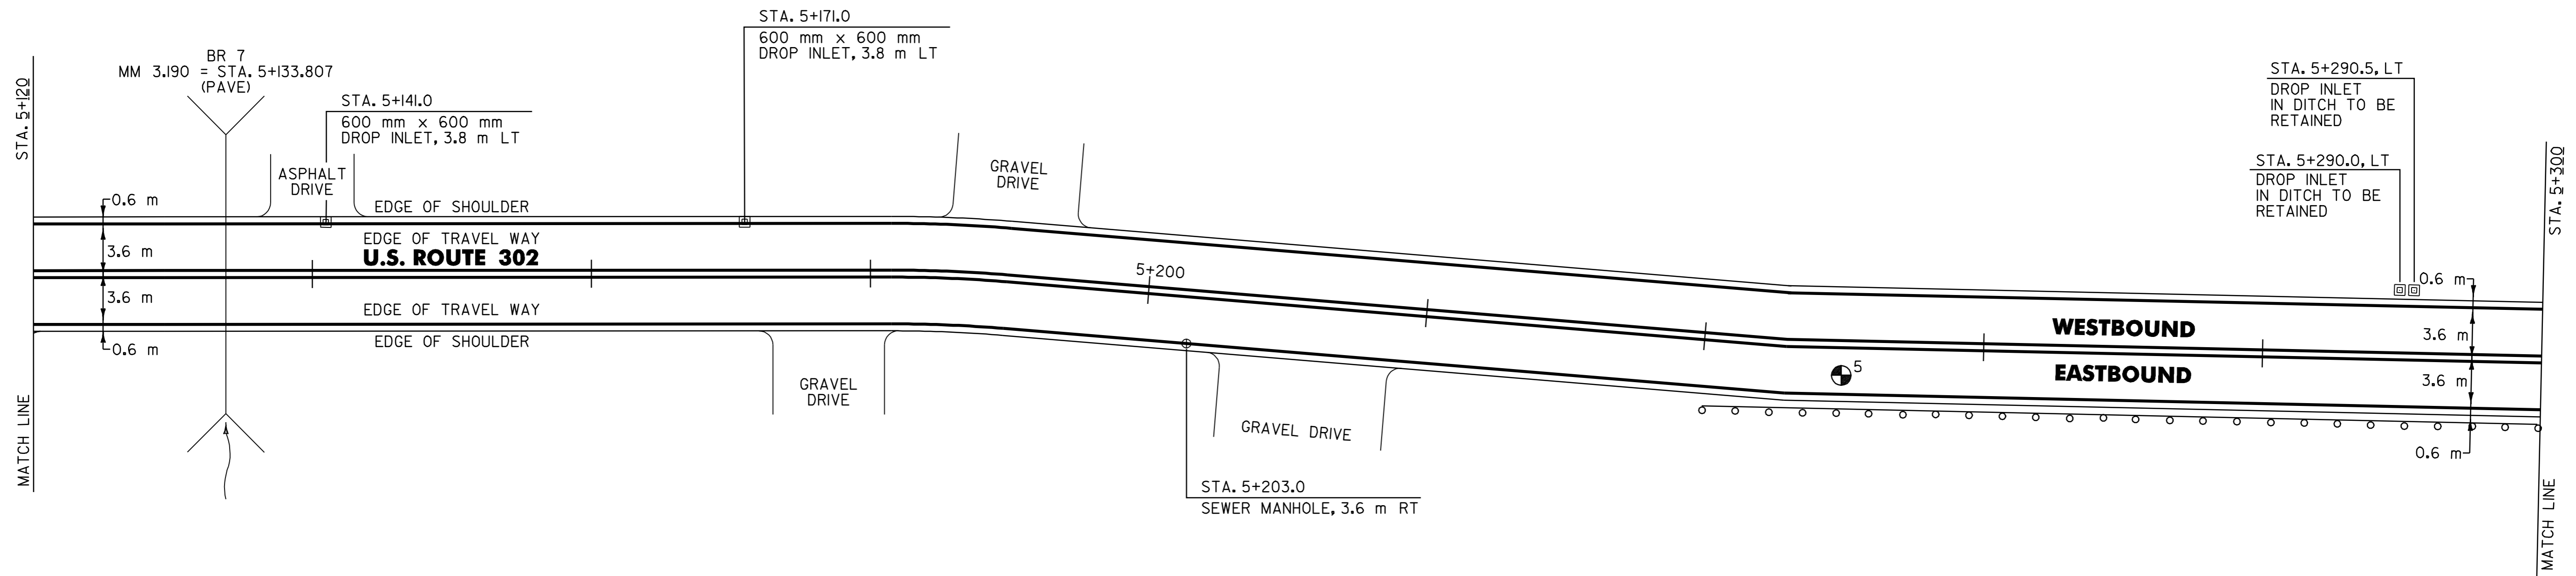

ARCHIVED
ON CADD

PAVEMENT CORES =

#	TOTAL DEPTH (mm)	PCC	COMMENTS
5	140	YES	

604.40 CHANGE ELEVATION OF DI, CB OR MH

BARRE CITY:
STA. 5+141.0 LT

604.41 REHABING DI, CB OR MH, CLASS 1

BARRE CITY:
STA. 5+171.0 LT ✓

604.42 CHANGE ELEVATION OF SEWER MANHOLE

BARRE CITY:
STA. 5+203.0 RT

DATUM	
VERTICAL	N/A
HORIZONTAL	N/A

PAVING
PROJECT
LAYOUT
11

SURVEYED BY	N/A	DATE	N/A
DRAWN BY	C.A.K.	DATE	2/02
SQUAD LEADER	D.E.G.		
DESIGN FILE NO.	/pave/98d086/zd086.dgn		
IPARM FILE	zd086pl1.1	DATE PLOTTED	25-APR-2006 14
PROJ. NAME	BARRE CITY		
PROJ. NO.	ST-STP 2102(I)S		
SHEET	20 OF 32	SHEETS	