


THIS SHEET, 9F1, SUPPLEMENTS SHEET 9  
**FIELD CHANGE SHEET**

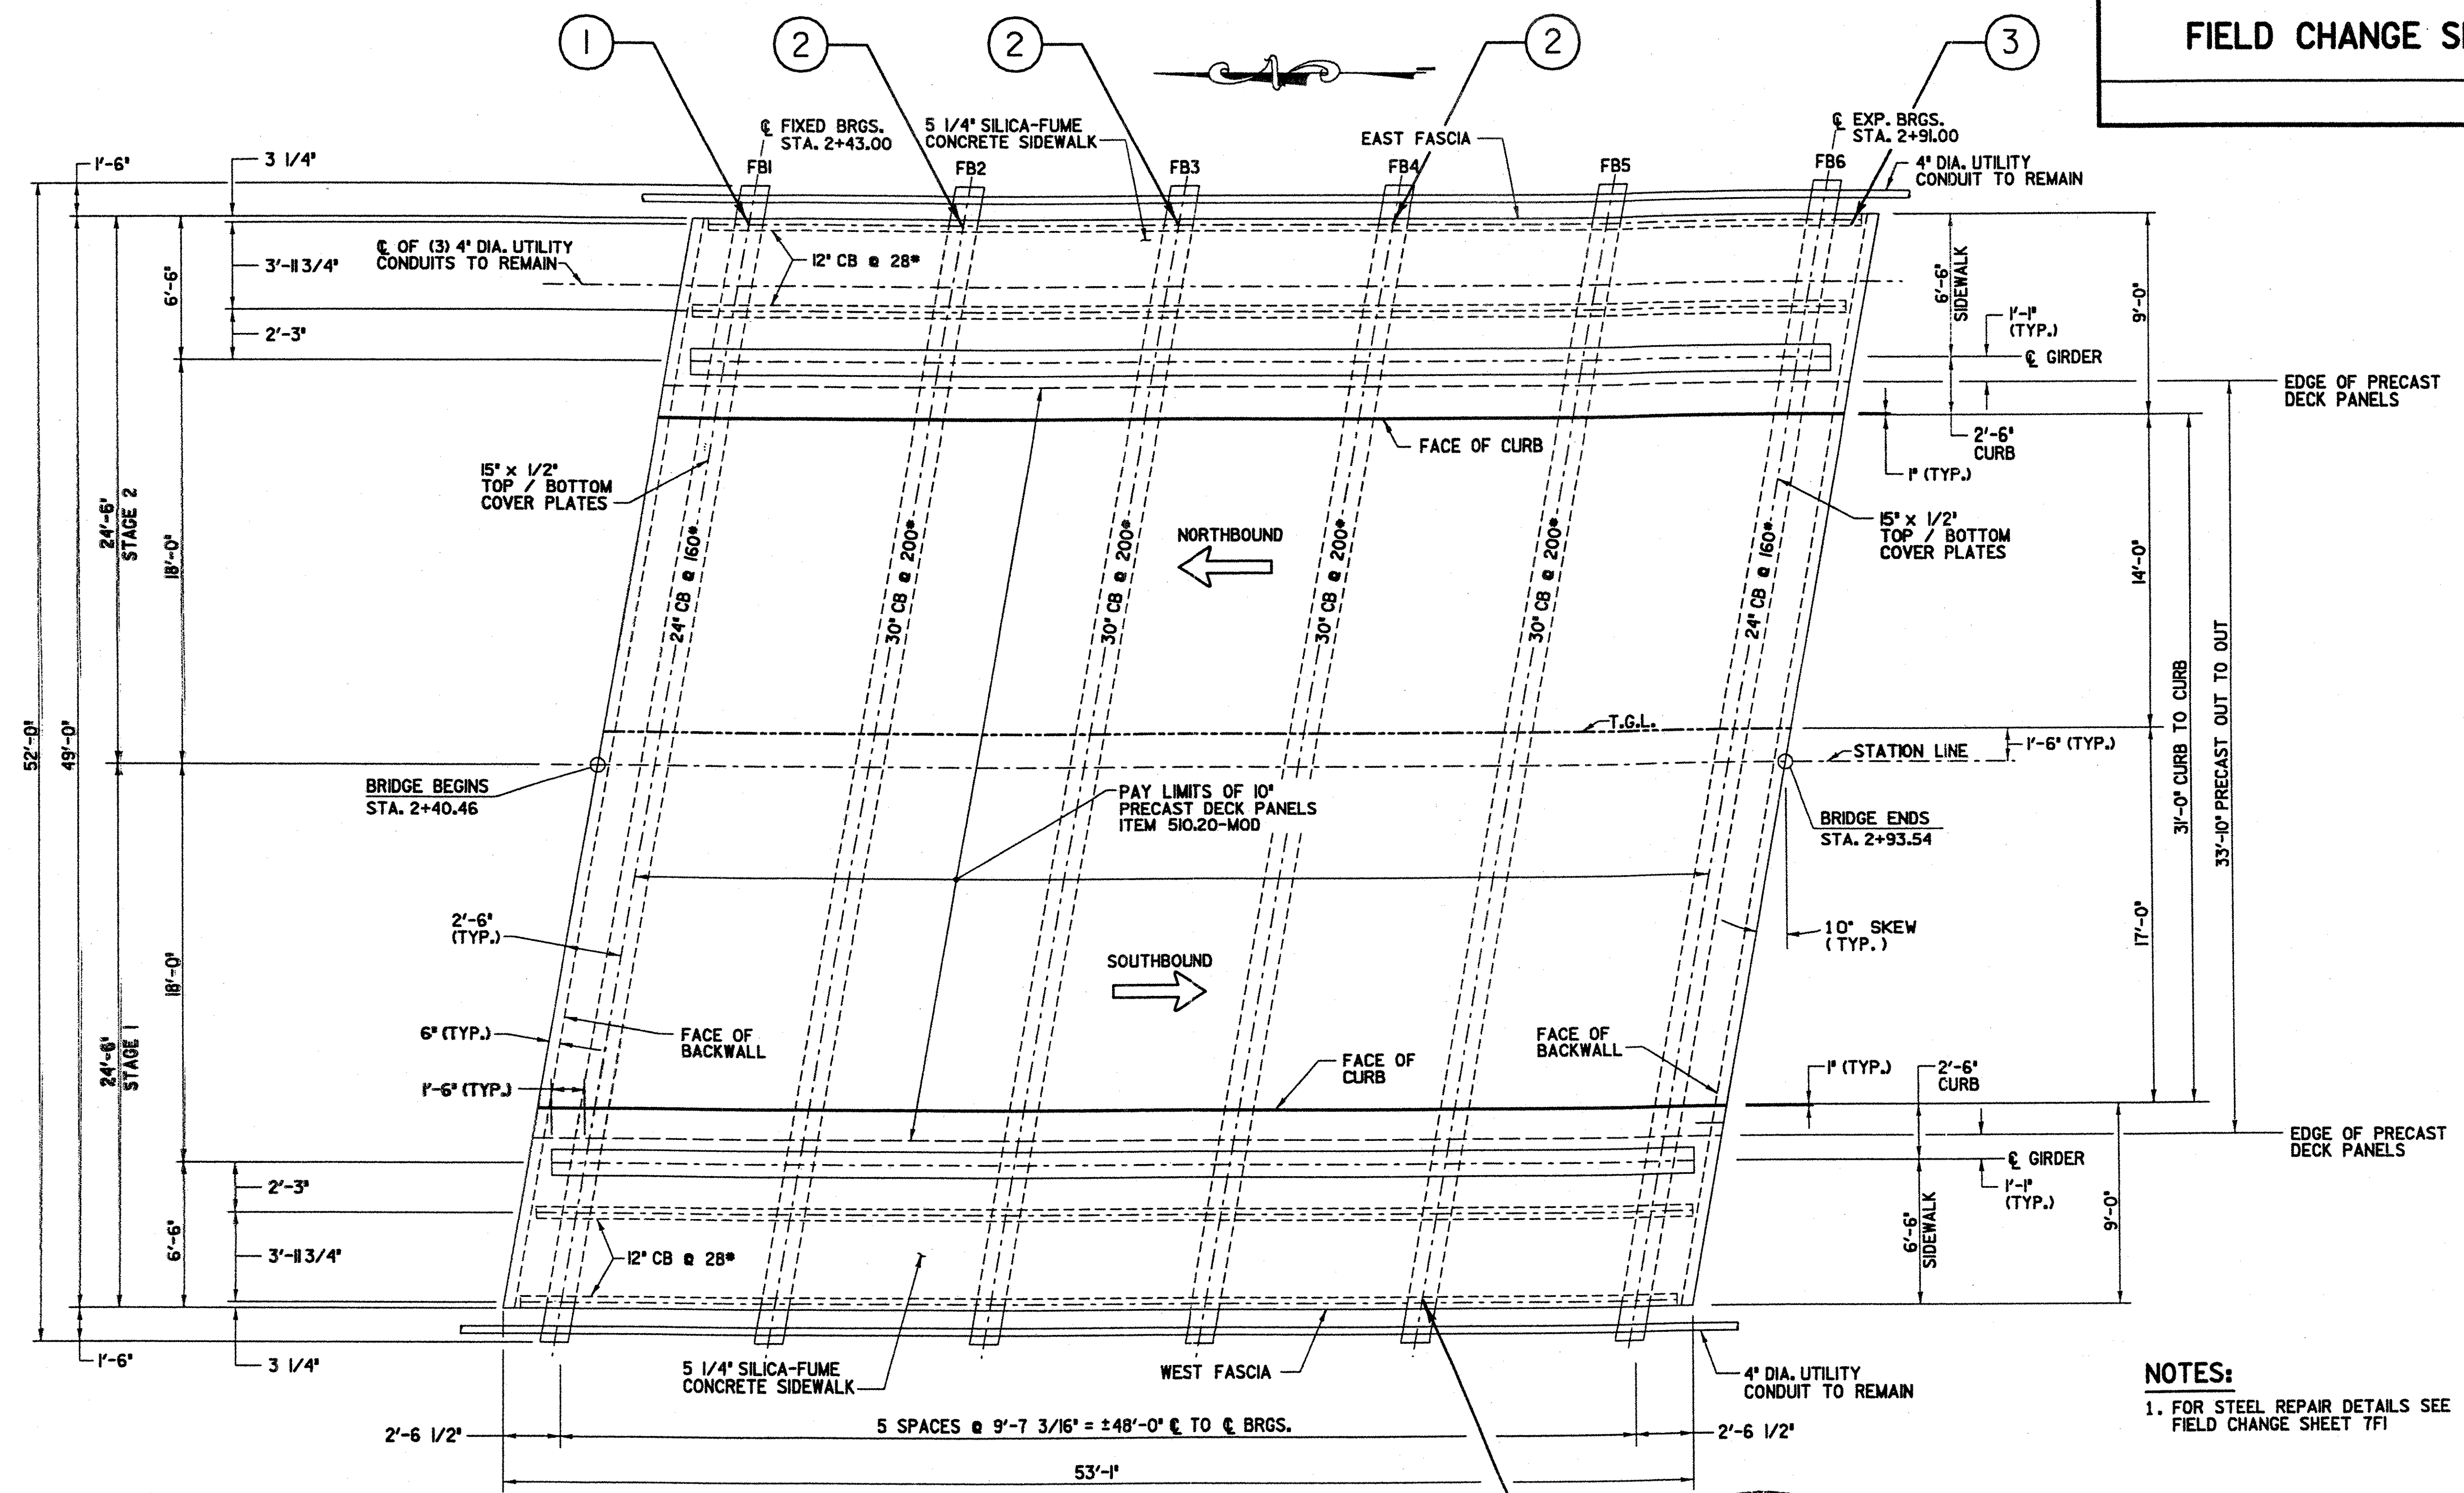

DESIGNED BY J. STEVENS  
 DRAFTED BY J. RIZZO  
 CHECKED BY C. COLLEY  
 J. SIMKULET  
 04/19/99/99008 VST/SPR2.DWG

- LEGEND:**
- ① --- STRINGER WEB REPAIR (INSTALLATION OF BENT PLATES)
  - ② --- STRINGER WEB REPAIR (INSTALLATION OF WEB PLATES)
  - ③ --- STRINGER WEB REPAIR (INSTALLATION OF WEB PLATES)

**PLAN**  
 SCALE: 1/4" = 1'-0"

**NOTES:**  
 1. FOR STEEL REPAIR DETAILS SEE FIELD CHANGE SHEET 7F1



PROJECT NO. TH-9914 BHF 1000 (17)S

BENNINGTON BRIDGE #10 (U.S. ROUTE 7) OVER THE WALLOOMSAC RIVER

**GPI** GREENMAN-PEDERSEN CONSULTING ENGINEERS

55 Monument Ave., Bennington, VT, 05201

DRAWING NO. SR-2 SCALE: AS SHOWN DATE: NOV., 2000 SHEET NO. 9F1 OF 20