
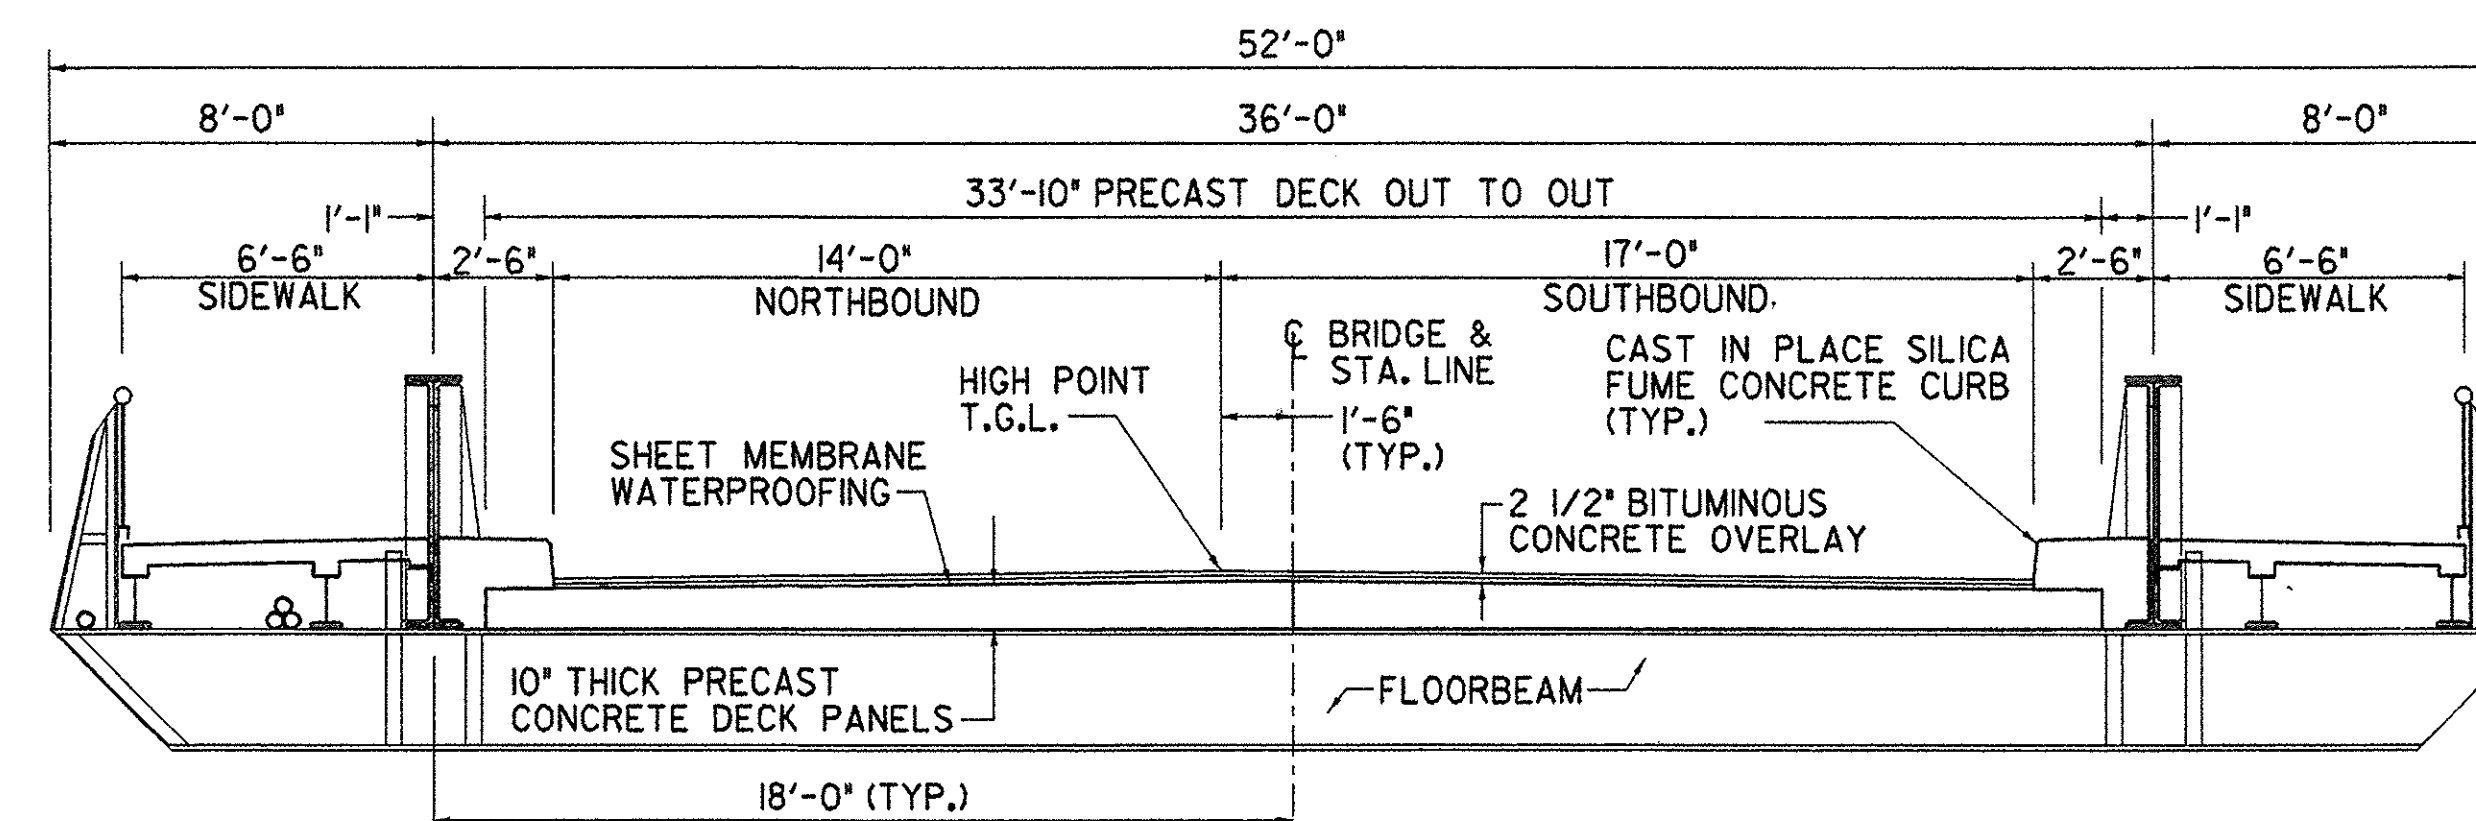
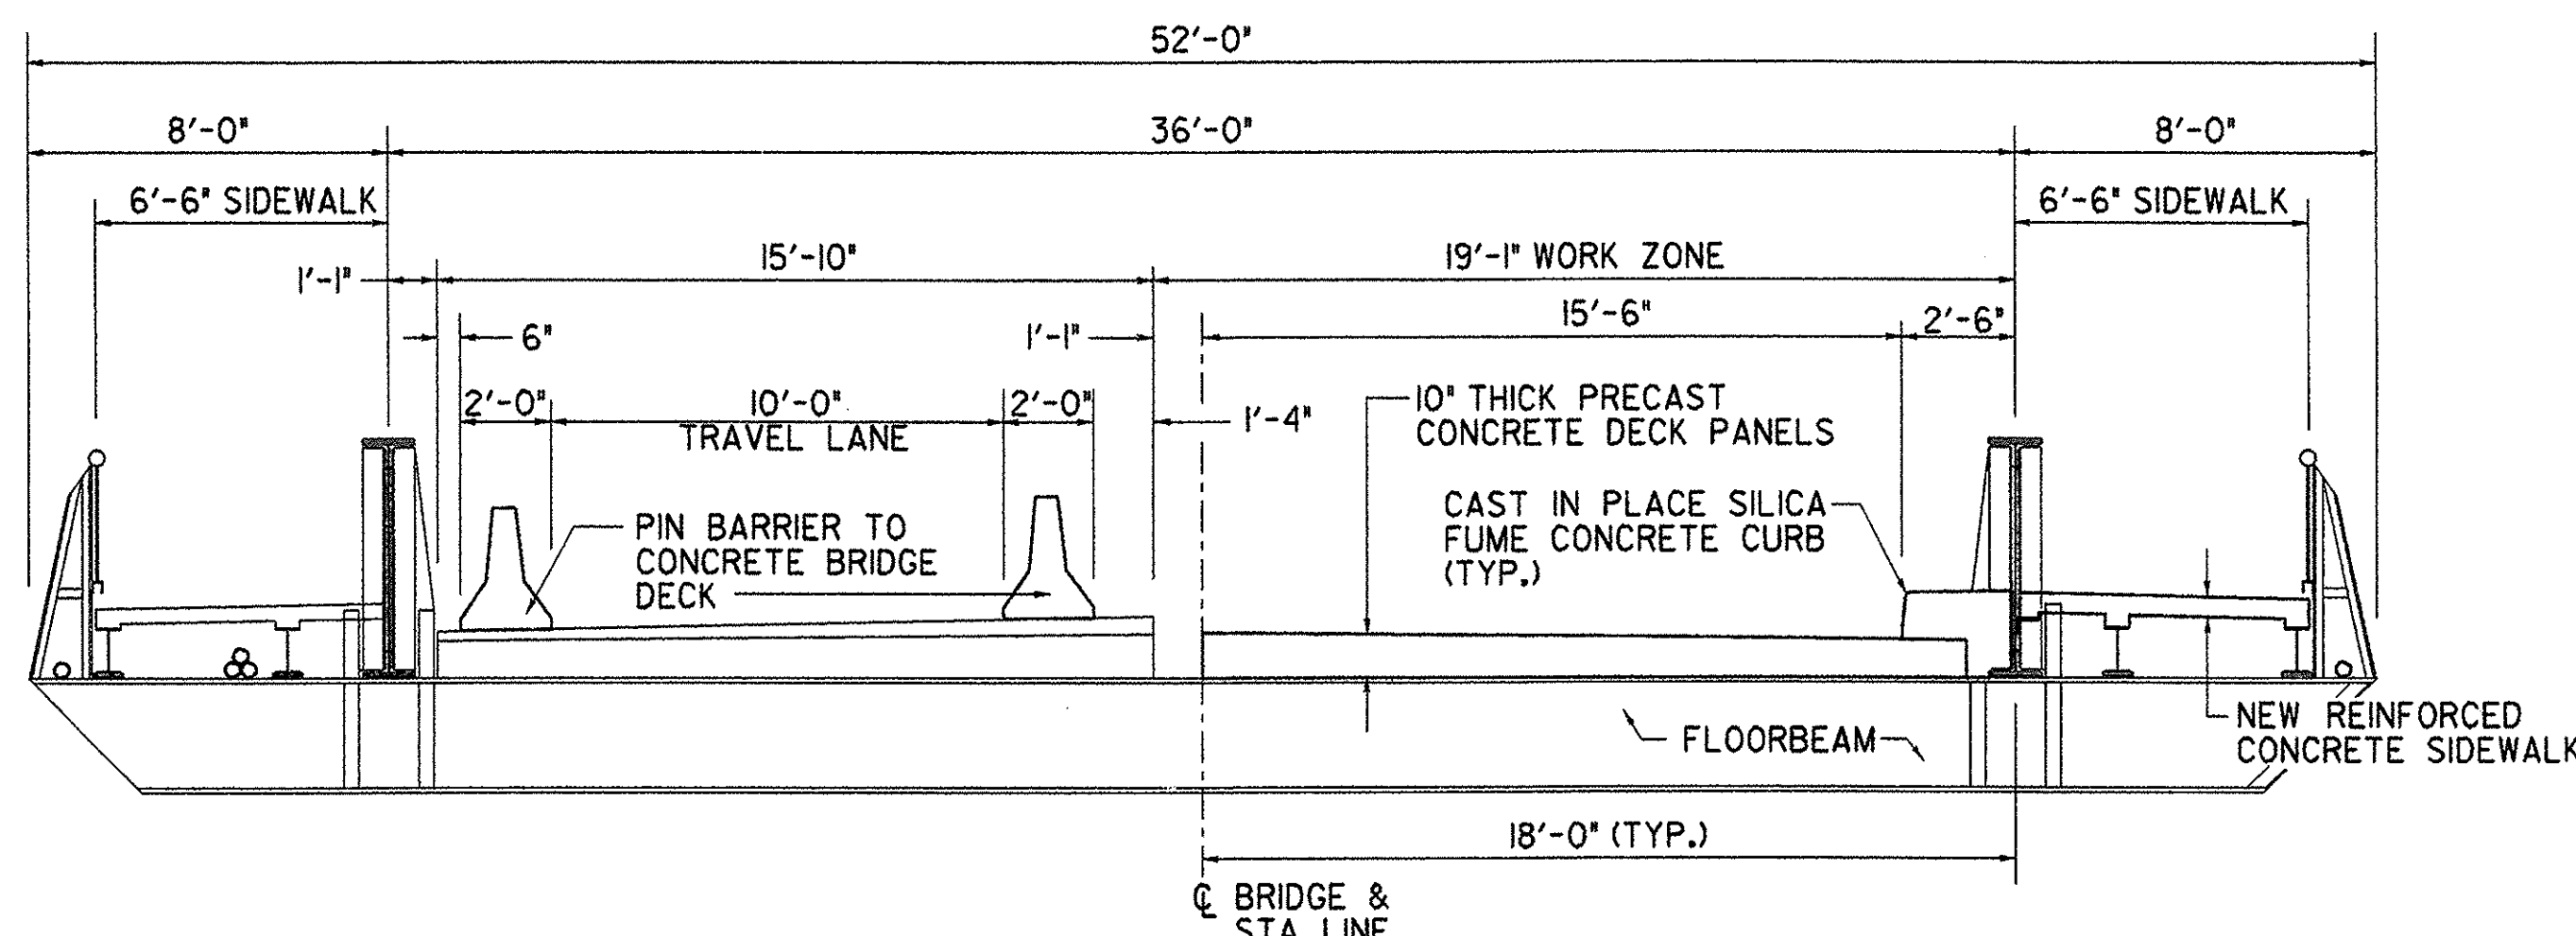
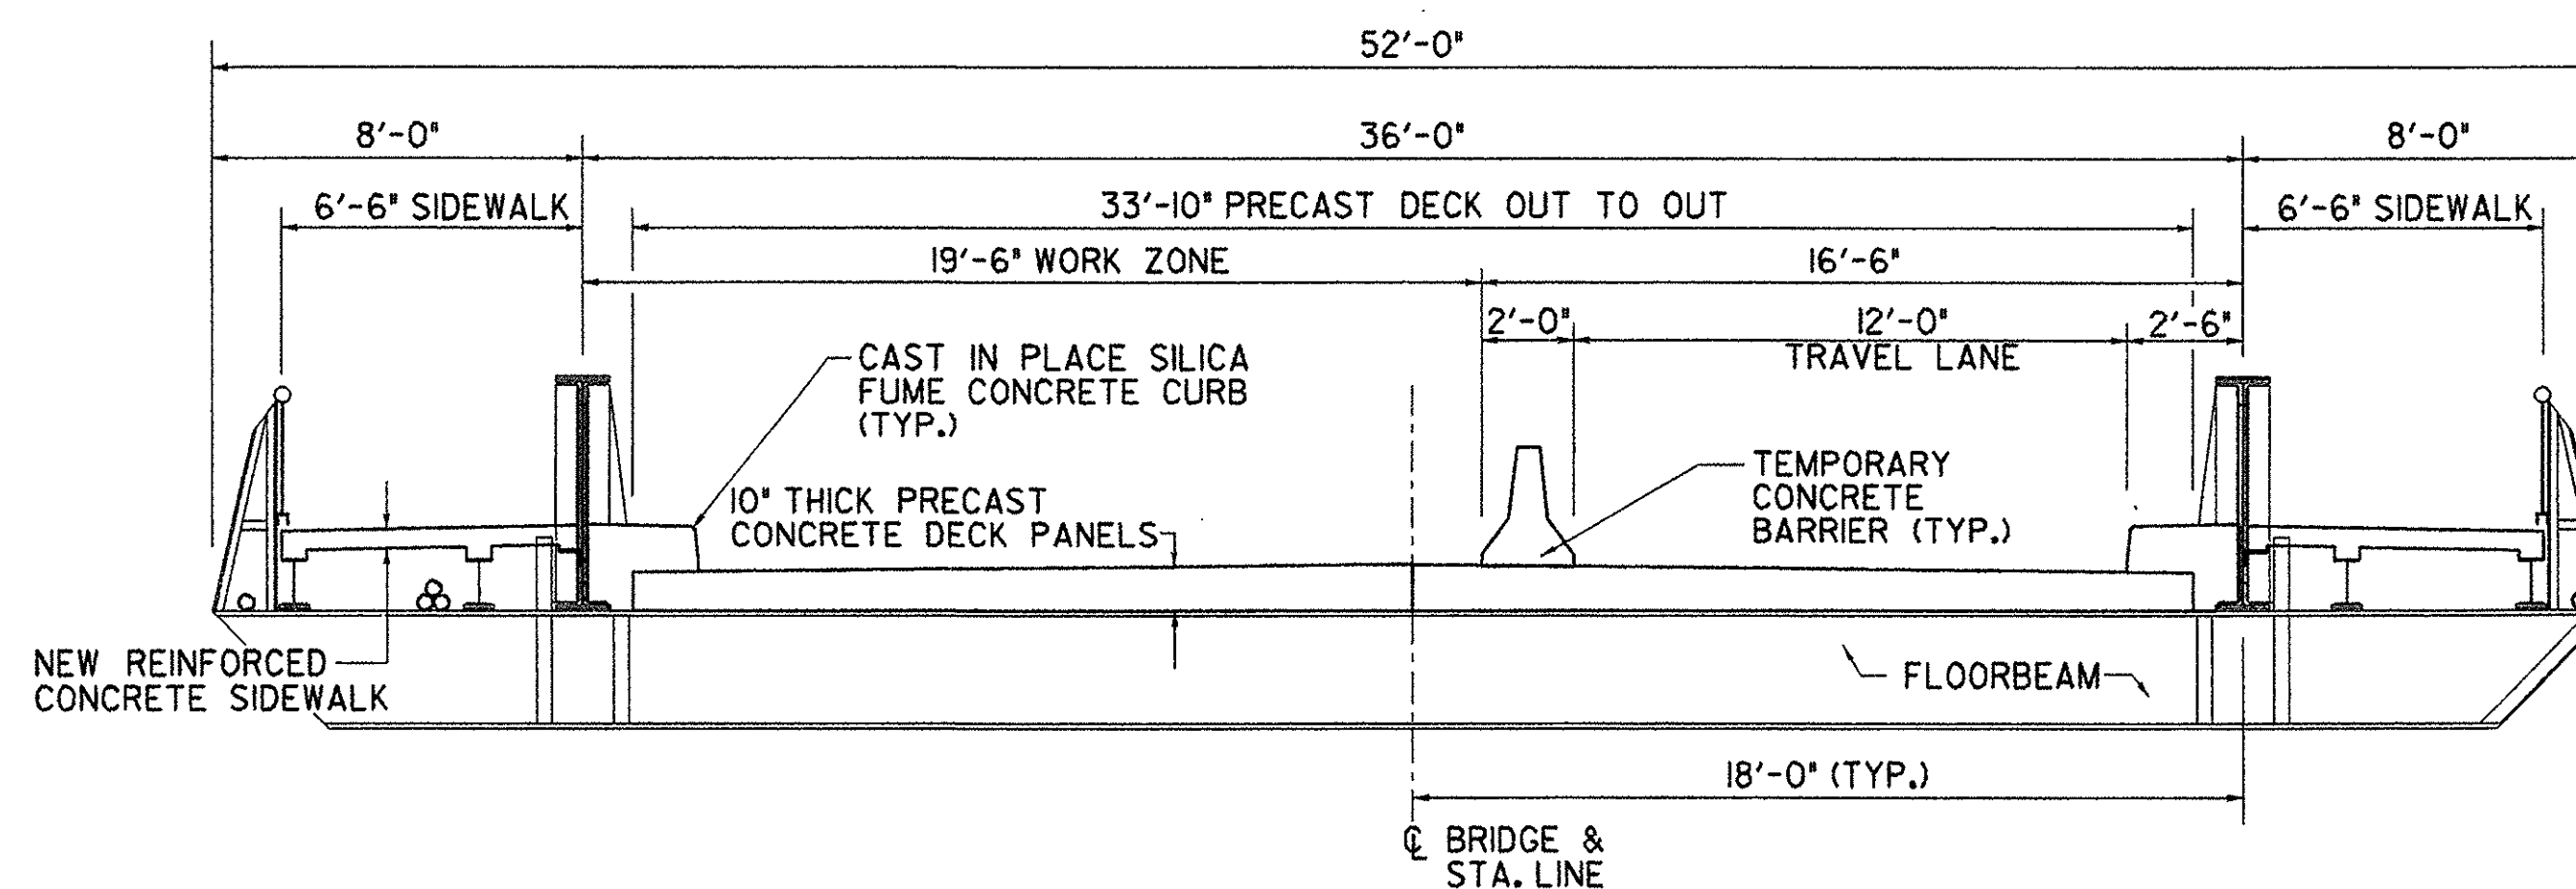


IN CHARGE OF J. STEVENS  
 DESIGNED BY J. RIZZO  
 DRAFTED BY K. COLE  
 CHECKED BY J. SIMKULET  
 04/1999 139008.thy7.mpt1.ben

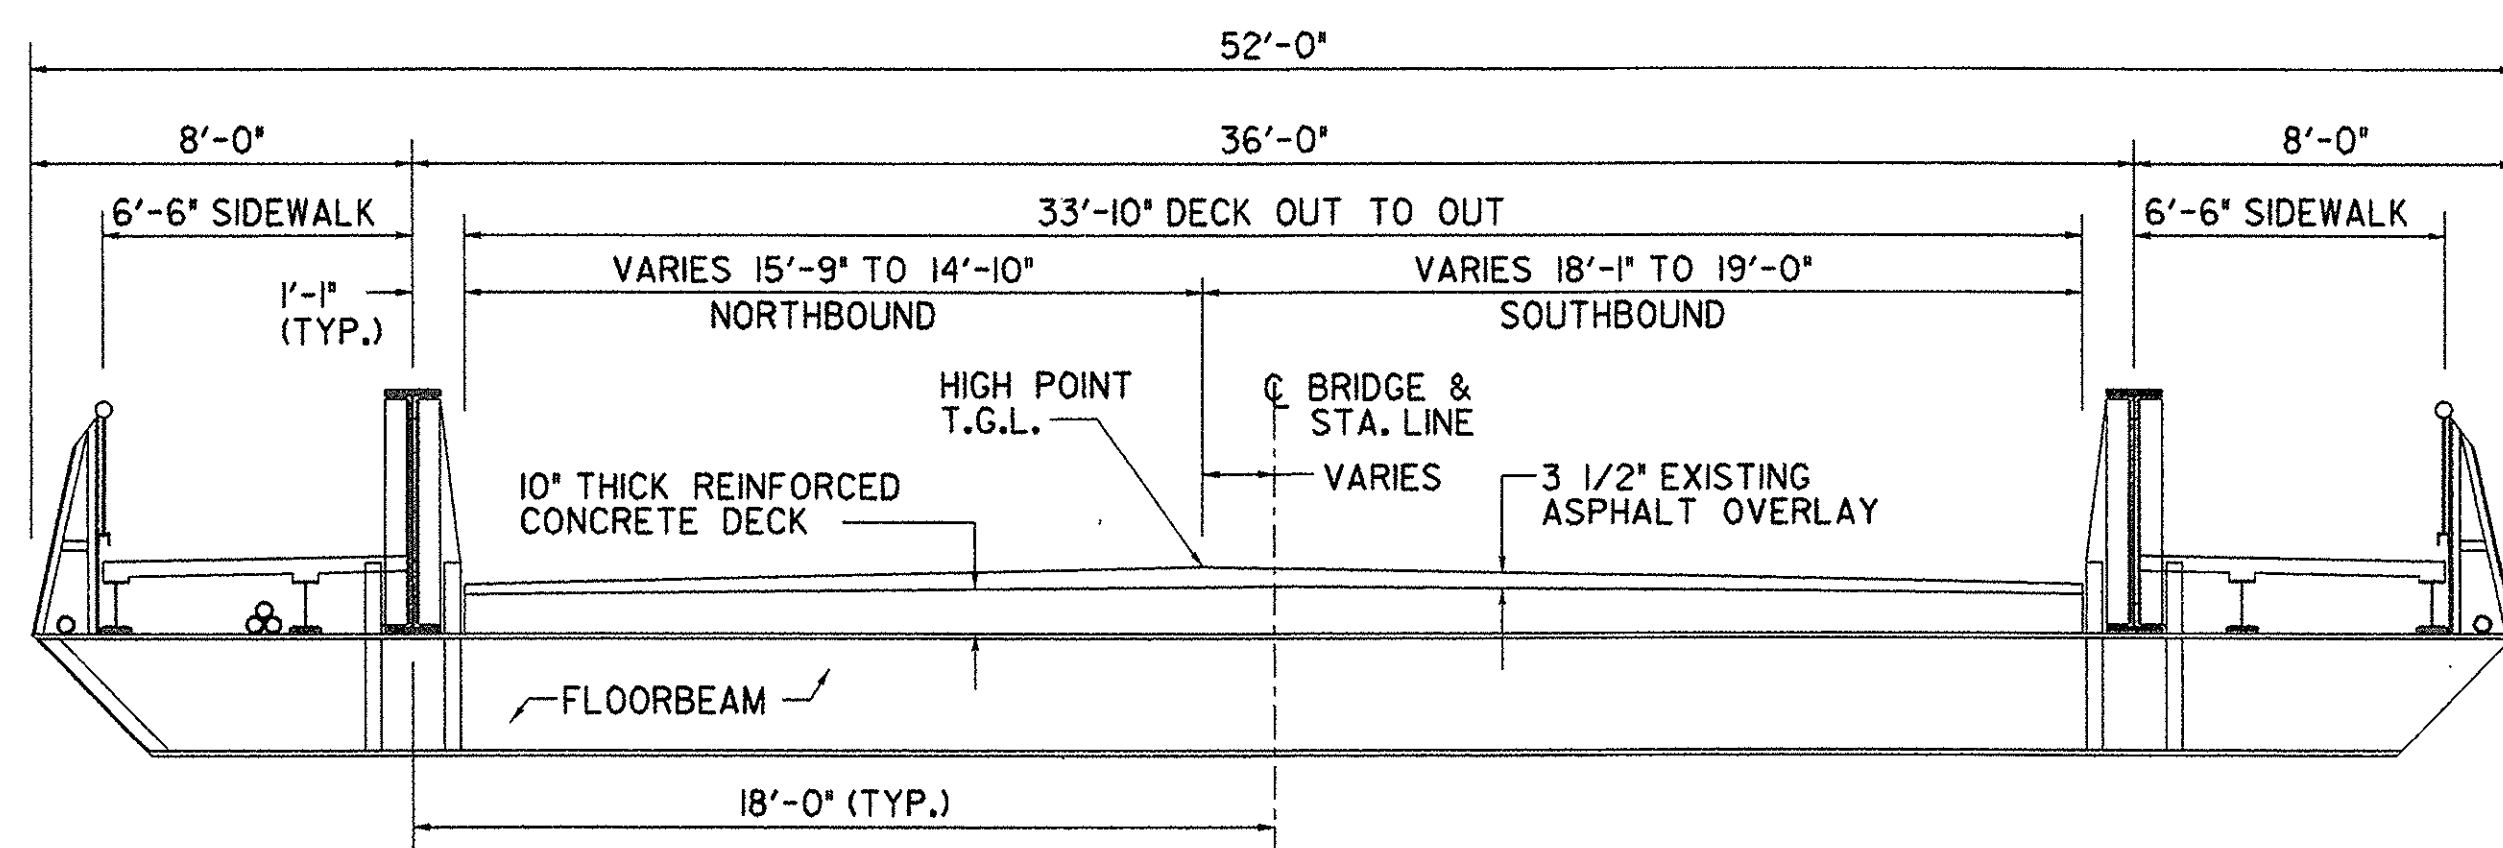

**SEQUENCE OF CONSTRUCTION:**

**STAGE 1**

1. REMOVE THE WEST SIDEWALK AND DECK TO THE LIMITS SHOWN ON THE PLANS.
2. PERFORM BEARING ANCHOR BOLT REPLACEMENTS.
3. SANDBLAST AND PAINT ALL STEEL WITHIN THE WORK ZONE.
4. PERFORM ALL STEEL REPAIRS WITHIN THE WORK ZONE AS NOTED IN THE PLANS AND FIELD DISCOVERED.
5. INSTALL NEW PRECAST DECK PANELS, CAST IN PLACE CURBS AND WEST SIDEWALKS.
6. RE-APPLY PAINT SYSTEM TO THE STEEL REPAIR LOCATIONS.

**STAGE 2**

1. SHIFT TRAFFIC TO THE WEST SIDE.
2. REMOVE THE EAST SIDEWALK AND DECK TO THE LIMITS SHOWN ON THE PLANS.
3. SANDBLAST AND PAINT ALL STEEL WITHIN THE WORK ZONE.
4. PERFORM ALL STEEL REPAIRS WITHIN THE WORK ZONE AS NOTED IN THE PLANS AND FIELD DISCOVERED.
5. INSTALL NEW PRECAST DECK PANELS, CAST IN PLACE CURBS AND EAST SIDEWALKS.
6. RE-APPLY PAINT SYSTEM TO THE STEEL REPAIR LOCATIONS.

**STAGE 3**

1. CLOSE BRIDGE TO ALL TRAFFIC.
2. REMOVE ALL CONCRETE BARRIERS.
3. INSTALL WATERPROOFING MEMBRANE AND ASPHALT WEARING SURFACE.

**NOTES:**

1. FOR STAGE 1 PLAN SEE DWG. MPT-2.
2. FOR STAGE 2 PLAN SEE DWG. MPT-3.
3. FOR STAGE 3 PLAN SEE DWG. MPT-4.

PROJECT NO. THI-9914

BHF 1000 (17)S

<b>Greenman-Pedersen</b> CONSULTING ENGINEERS <b>GPI</b> 55 Monument Ave. Bennington, VT. 05201	BENNINGTON BRIDGE #10 (U.S. ROUTE 7) OVER THE WALLOOMSAC RIVER		
	<b>MAINTENANCE &amp; PROTECTION          OF TRAFFIC DETAILS</b>		
DRAWING NO. MPT-1	SCALE: AS SHOWN	DATE: DEC ., 1999	SHEET NO. 16 OF 20