


646.414 DURABLE 6" WHITE LINE (MOD.) (RETROREFLECTIVITY/INLAID)
 (ALL LINES WILL INCLUDE EDGE LINE BREAKS AND RADIUS FOR TOWN HIGHWAYS)
 WALLINGFORD:
 STA. 355+00.00 - STA. 371+00.00 DASHED LINE C/L
 STA. 355+00.00 - STA. 371+00.00 EDGE LINE RT

646.415 DURABLE 6" YELLOW LINE (MOD.) (RETROREFLECTIVITY/INLAID)
 (ALL LINES WILL INCLUDE C/L BREAKS FOR TOWN HIGHWAYS) S=SOLID, D=DASHED
 WALLINGFORD:
 STA. 355+00.00 - STA. 371+00.00 EDGE LINE LT

646.614 TEMPORARY 6" WHITE LINE (PAINT)
 (ALL LINES WILL INCLUDE EDGE LINE BREAKS AND RADIUS FOR TOWN HIGHWAYS)
 WALLINGFORD:
 STA. 355+00.00 - STA. 371+00.00 DASHED LINE C/L
 STA. 355+00.00 - STA. 371+00.00 EDGE LINE RT

646.615 TEMPORARY 6" YELLOW LINE (PAINT)
 (ALL LINES WILL INCLUDE C/L BREAKS FOR TOWN HIGHWAYS) S=SOLID, D=DASHED
 WALLINGFORD:
 STA. 355+00.00 - STA. 371+00.00 EDGE LINE LT

675.50 REMOVING SIGNS
 AS SHOWN - 2

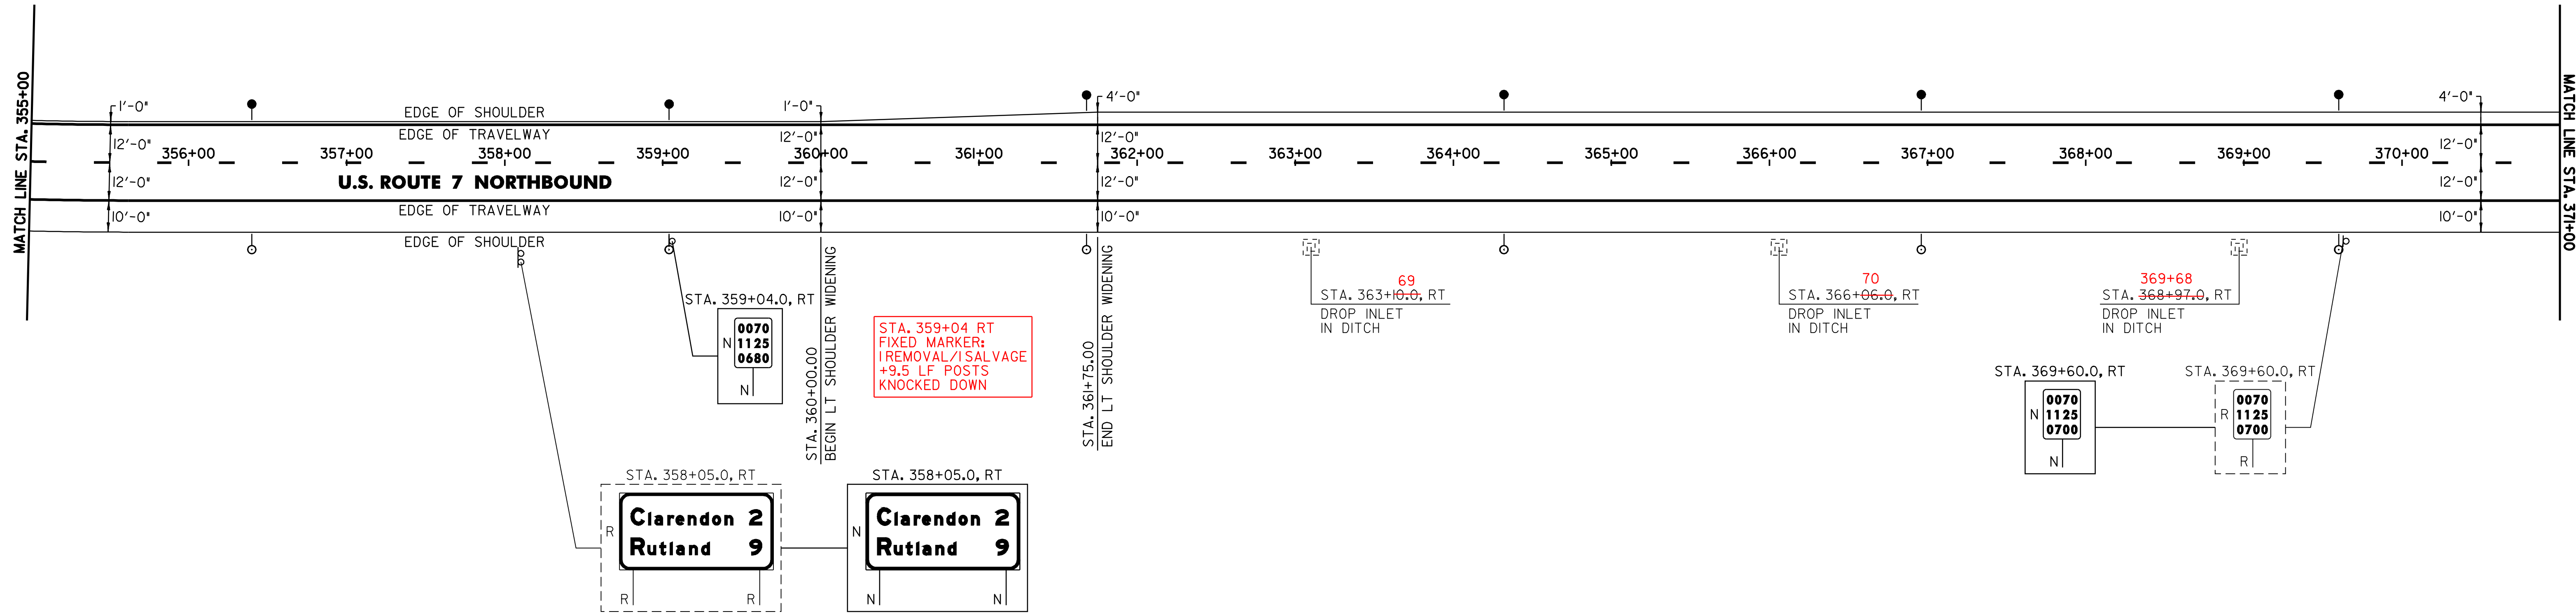

213.10 MILLED RUMBLE STRIPS
 WALLINGFORD:
 STA. 355+00.0 TO STA. 371+00.0 RT (1600 FT)
 STA. 361+75.0 TO STA. 371+00.0 LT (925 FT)
 604.412 REHABING DI, CB OR MH, CLASS I
 WALLINGFORD:
 STA. 363+10.0 RT STA. 363+69 RT
 STA. 366+06.0 RT STA. 366+70 RT
 STA. 368+97.0 RT STA. 369+68 RT

617.610 DELINEATORS WITH STEEL POSTS
 TYPE I WHITE TYPE I AMBER
 WALLINGFORD:
 STA. 356+40.0 RT STA. 356+40.0 LT
 STA. 359+04.0 RT STA. 359+04.0 LT
 STA. 361+68.0 RT STA. 361+68.0 LT
 STA. 364+32.0 RT STA. 364+32.0 LT
 STA. 366+96.0 RT STA. 366+96.0 LT
 STA. 369+60.0 RT STA. 369+60.0 LT

201.31 THINNING AND TRIMMING
 STA. 358+05.0 RT

SIGN LEGEND
 R= REMOVE
 S= SALVAGE
 N= NEW
 RET= RETAIN
 B-B= BACK TO BACK
 EXISTING= -----
 NEW= -----

PROJECT LAYOUT SHEET #3

PROJECT NAME: WALLINGFORD - RUTLAND TOWN
 PROJECT NUMBER: AC NH 2207(1)S
 FILE NAME: p99bl66.dgn
 PROJECT LEADER: D.E.G.
 DESIGNED BY: D.W.E.
 PLOT DATE: 12-MAR-2007 11:28
 DRAWN BY: C.A.K.
 CHECKED BY: D.E.G.
 SHEET 15 OF 95

SEE SHEET 13 OF 96 FOR STATIONING PROBLEM.
 TP 10-28-05