

646.414 DURABLE 6" WHITE LINE (MOD.XRETROREFLECTIVITY/INLAID)

(ALL LINES WILL INCLUDE EDGE LINE BREAKS AND RADIUS FOR TOWN HIGHWAYS)

CLARENDON:
 STA. 11+00.00 - STA. 27+00.00 DASHED LINE C/L
 STA. 11+00.00 - STA. 27+00.00 EDGE LINE RT

646.415 DURABLE 6" YELLOW LINE (MOD.XRETROREFLECTIVITY/INLAID)

(ALL LINES WILL INCLUDE C/L BREAKS FOR TOWN HIGHWAYS) S=SOLID, D=DASHED

CLARENDON:
 STA. 11+00.00 - STA. 27+00.00 EDGE LINE LT

646.614 TEMPORARY 6" WHITE LINE (PAINT)

(ALL LINES WILL INCLUDE EDGE LINE BREAKS AND RADIUS FOR TOWN HIGHWAYS)

CLARENDON:
 STA. 11+00.00 - STA. 27+00.00 DASHED LINE C/L
 STA. 11+00.00 - STA. 27+00.00 EDGE LINE RT


646.615 TEMPORARY 6" YELLOW LINE (PAINT)

(ALL LINES WILL INCLUDE C/L BREAKS FOR TOWN HIGHWAYS) S=SOLID, D=DASHED

CLARENDON:
 STA. 11+00.00 - STA. 27+00.00 EDGE LINE LT

675.50 REMOVING SIGNS

AS SHOWN - I

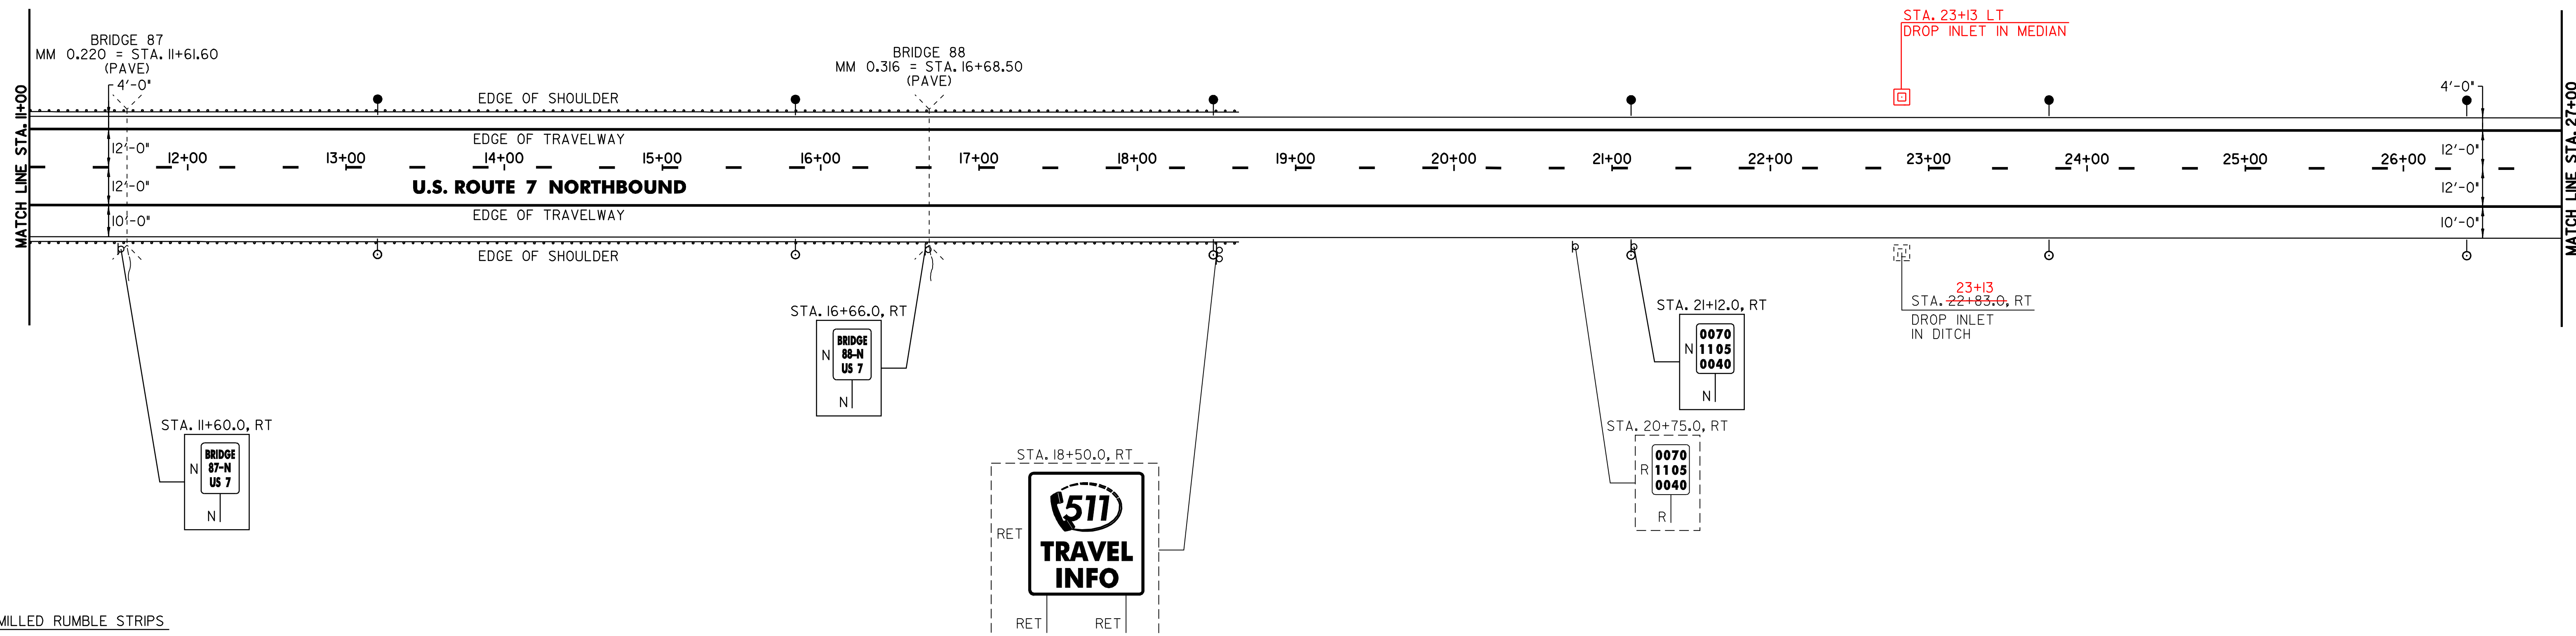

213.10 MILLED RUMBLE STRIPS

CLARENDON:
 STA. 18+42.0 TO STA. 27+00.0 LT (858 FT)
 STA. 11+00.0 TO STA. 27+00.0 RT (1600 FT)

604.412 REHABING DI, CB OR MH, CLASS I

CLARENDON: ~~STA. 22+83.0 RT~~ STA. 23+13 LT
 STA. 23+13 RT

621.20 STEEL BEAM GUARDRAIL (GALVANIZED)

CLARENDON:
 STA. 11+00.0 - STA. 18+52.8 LT (752.8 FT)
 STA. 11+00.0 - STA. 18+54.3 RT (754.3 FT)

621.52 TRAILING END TERMINAL

CLARENDON:
~~STA. 18+52.8 - STA. 18+67.0 LT~~ 18+65 - STA. 18+77 LT
~~STA. 18+54.3 - STA. 18+68.5 RT~~ 18+75 - STA. 18+87 RT

621.80 REMOVAL AND DISPOSAL OF GUARDRAIL

CLARENDON: 77
 STA. 11+00.0 - STA. 18+64.0 LT (764.0 FT)
 STA. 11+00.0 - STA. 18+64.0 RT (764.0 FT)

676.10 DELINEATORS WITH STEEL POSTS

♀ TYPE 1 WHITE ♂ TYPE 1 AMBER

CLARENDON:		
STA. 13+20.0	RT	STA. 13+20.0 LT
STA. 15+84.0	RT	STA. 15+84.0 LT
STA. 18+48.0	RT	STA. 18+48.0 LT
STA. 21+12.0	RT	STA. 21+12.0 LT
STA. 23+76.0	RT	STA. 23+76.0 LT
STA. 26+40.0	RT	STA. 26+40.0 LT

SIGN LEGEND

R= REMOVE
 S= SALVAGE
 N= NEW
 RET= RETAIN
 B-B= BACK TO BACK
 EXISTING= -----
 NEW= -----

PROJECT LAYOUT SHEET #5

PROJECT NAME: WALLINGFORD - RUTLAND TOWN
 PROJECT NUMBER: AC NH 2207(1)S

FILE NAME: p99bl66.dgn
 PROJECT LEADER: D.E.G.
 DESIGNED BY: D.W.E.

PLOT DATE: 12-MAR-2007 11:28
 DRAWN BY: C.A.K.
 CHECKED BY: D.E.G.
 SHEET 17 OF 95