

646.414 DURABLE 6" WHITE LINE (MOD.) (RETROREFLECTIVITY/INLAID)  
 (ALL LINES WILL INCLUDE EDGE LINE BREAKS AND RADIUS FOR TOWN HIGHWAYS)

CLARENDON:  
 STA. 27+00.00 - STA. 43+00.00 DASHED LINE C/L  
 STA. 27+00.00 - STA. 43+00.00 EDGE LINE RT  
 STA. 33+25.00 - STA. 36+40.00 DOTTED LANE LINE LT  
 STA. 36+40.00 - STA. 38+69.00 SOLID LANE LINE LT

646.415 DURABLE 6" YELLOW LINE (MOD.) (RETROREFLECTIVITY/INLAID)  
 (ALL LINES WILL INCLUDE C/L BREAKS FOR TOWN HIGHWAYS) S=SOLID, D=DASHED

CLARENDON:  
 STA. 27+00.00 - STA. 43+00.00 EDGE LINE LT  
 STA. 38+86.08 DOUBLE SOLID LT, VT ROUTE 7B

646.46 DURABLE 24" STOP BAR (THERMOPLASTIC)

CLARENDON:  
 STA. 38+86.08 LT, VT ROUTE 7B  
 STA. 38+86.08 LT, VT ROUTE 7B

646.66 TEMPORARY 24" STOP BAR (PAINT)

CLARENDON:  
 STA. 38+86.08 LT, VT ROUTE 7B  
 STA. 38+86.08 LT, VT ROUTE 7B

646.614 TEMPORARY 6" WHITE LINE (PAINT)  
 (ALL LINES WILL INCLUDE EDGE LINE BREAKS AND RADIUS FOR TOWN HIGHWAYS)

CLARENDON:  
 STA. 27+00.00 - STA. 43+00.00 DASHED LINE C/L  
 STA. 27+00.00 - STA. 43+00.00 EDGE LINE RT  
 STA. 33+25.00 - STA. 36+40.00 DOTTED LANE LINE LT  
 STA. 36+40.00 - STA. 38+69.00 SOLID LANE LINE LT

646.615 TEMPORARY 6" YELLOW LINE (PAINT)  
 (ALL LINES WILL INCLUDE C/L BREAKS FOR TOWN HIGHWAYS) S=SOLID, D=DASHED

CLARENDON:  
 STA. 27+00.00 - STA. 43+00.00 EDGE LINE LT  
 STA. 38+86.08 DOUBLE SOLID LT, VT ROUTE 7B

646.50 DURABLE LETTER OR SYMBOL (THERMOPLASTIC)


CLARENDON:  
 STA. 36+44.2 LT, "O,N,L,Y" (4 EA)  
 STA. 36+88.3 LT, ARROW (1 EA)  
 STA. 37+32.4 LT, "O,N,L,Y" (4 EA)  
 STA. 37+76.5 LT, ARROW (1 EA)  
 STA. 38+20.6 LT, "O,N,L,Y" (4 EA)  
 STA. 38+64.7 LT, ARROW (1 EA)  
 STA. 38+86.08 LT, VT. ROUTE 7B, "S,T,O,P" (8 EA)

646.70 TEMPORARY LETTER OR SYMBOL (PAINT)

CLARENDON:  
 STA. 36+88.3 LT, ARROW (2 EA)  
 STA. 38+64.7 LT, ARROW (2 EA)  
 STA. 38+86.08 LT, VT. ROUTE 7B, "S,T,O,P" (16 EA)

675.50 REMOVING SIGNS

AS SHOWN - 12

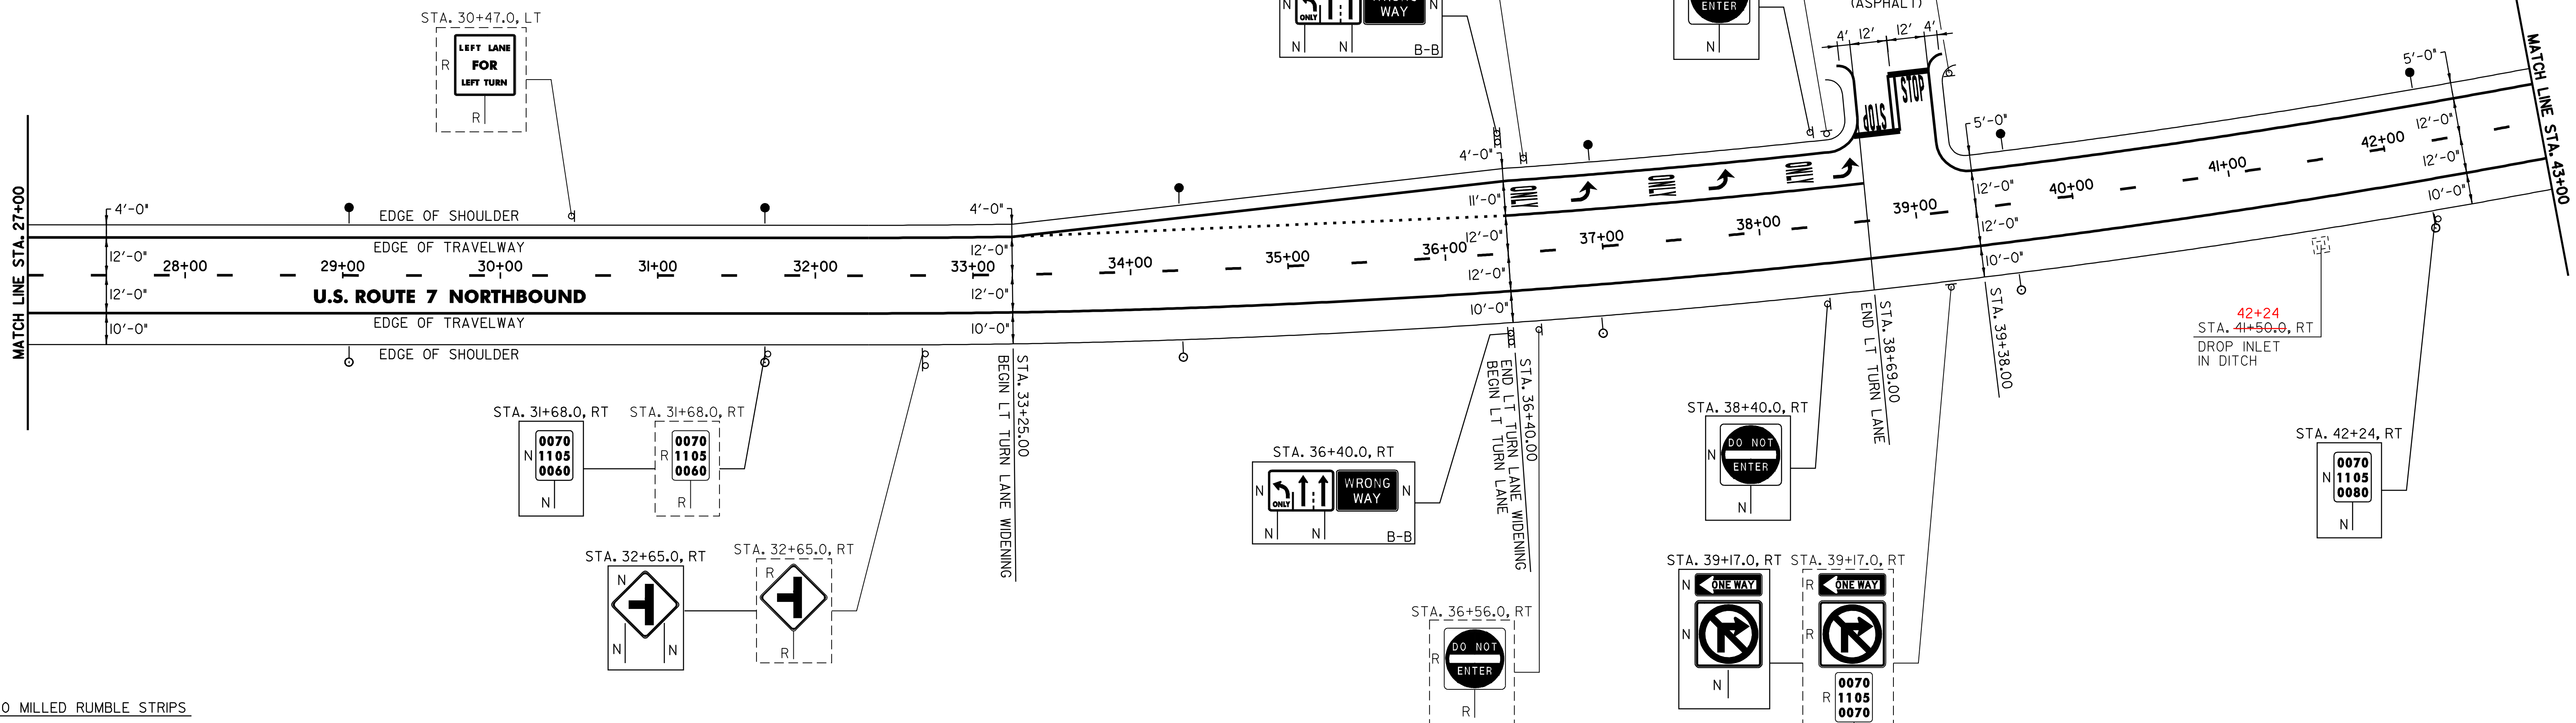

213.10 MILLED RUMBLE STRIPS

CLARENDON:  
 STA. 27+00.0 TO STA. 33+25.0 LT (625 FT)  
 STA. 27+00.0 TO STA. 43+00.0 RT (1600 FT)  
 STA. 39+62.0 TO STA. 43+00.0 LT (338 FT)

604.412 REHABING DI, CB OR MH, CLASS I

CLARENDON:  
 STA. 41+50.0 RT

676.10 DELINEATORS WITH STEEL POSTS

○ TYPE I WHITE      ● TYPE I AMBER

CLARENDON:  
 STA. 29+04.0 RT      STA. 29+04.0 LT  
 STA. 31+68.0 RT      STA. 31+68.0 LT  
 STA. 34+32.0 RT      STA. 34+32.0 LT  
 STA. 36+96.0 RT      STA. 36+96.0 LT  
 STA. 39+60.0 RT      STA. 39+60.0 LT  
 STA. 42+24.0 RT      STA. 42+24.0 LT

SIGN LEGEND  
 R= REMOVE  
 S= SALVAGE  
 N= NEW  
 RET= RETAIN  
 B-B= BACK TO BACK  
 EXISTING= \_\_\_\_\_  
 NEW= \_\_\_\_\_

**PROJECT LAYOUT SHEET #6**

PROJECT NAME: WALLINGFORD - RUTLAND TOWN  
 PROJECT NUMBER: AC NH 2207(1)S  
 FILE NAME: p99bl66.dgn  
 PROJECT LEADER: D.E.G.  
 DESIGNED BY: D.W.E.  
 PLOT DATE: 12-MAR-2007 11:28  
 DRAWN BY: C.A.K.  
 CHECKED BY: D.E.G.  
 SHEET 18 OF 95