

646.414 DURABLE 6" WHITE LINE (MOD.) (RETROREFLECTIVITY/INLAID)
 (ALL LINES WILL INCLUDE EDGE LINE BREAKS AND RADIUS FOR TOWN HIGHWAYS)
 CLARENDON:
 STA. 43+00.00 - STA. 59+00.00 EDGE LINE RT
 STA. 43+00.00 - STA. 59+00.00 DASHED LINE C/L
 STA. 55+20.00 - STA. 58+60.00 DOTTED LANE LINE RT
 STA. 58+60.00 - STA. 59+00.00 SOLID LANE LINE RT


646.415 DURABLE 6" YELLOW LINE (MOD.) (RETROREFLECTIVITY/INLAID)
 (ALL LINES WILL INCLUDE C/L BREAKS FOR TOWN HIGHWAYS) S=SOLID, D=DASHED
 CLARENDON:
 STA. 43+00.00 - STA. 59+00.00 LT EDGE LINE

646.50 DURABLE LETTER OR SYMBOL (THERMOPLASTIC)
 CLARENDON:
 STA. 58+64.2 RT, *O,N,L,Y* (4 EA)

646.614 TEMPORARY 6" WHITE LINE (PAINT)
 (ALL LINES WILL INCLUDE EDGE LINE BREAKS AND RADIUS FOR TOWN HIGHWAYS)
 CLARENDON:
 STA. 43+00.00 - STA. 59+00.00 EDGE LINE RT
 STA. 43+00.00 - STA. 59+00.00 DASHED LINE C/L
 STA. 55+20.00 - STA. 58+60.00 DOTTED LANE LINE RT
 STA. 58+60.00 - STA. 59+00.00 SOLID LANE LINE RT

646.615 TEMPORARY 6" YELLOW LINE (PAINT)
 (ALL LINES WILL INCLUDE C/L BREAKS FOR TOWN HIGHWAYS) S=SOLID, D=DASHED
 CLARENDON:
 STA. 43+00.00 - STA. 59+00.00 LT EDGE LINE

675.50 REMOVING SIGNS
 AS SHOWN - 6

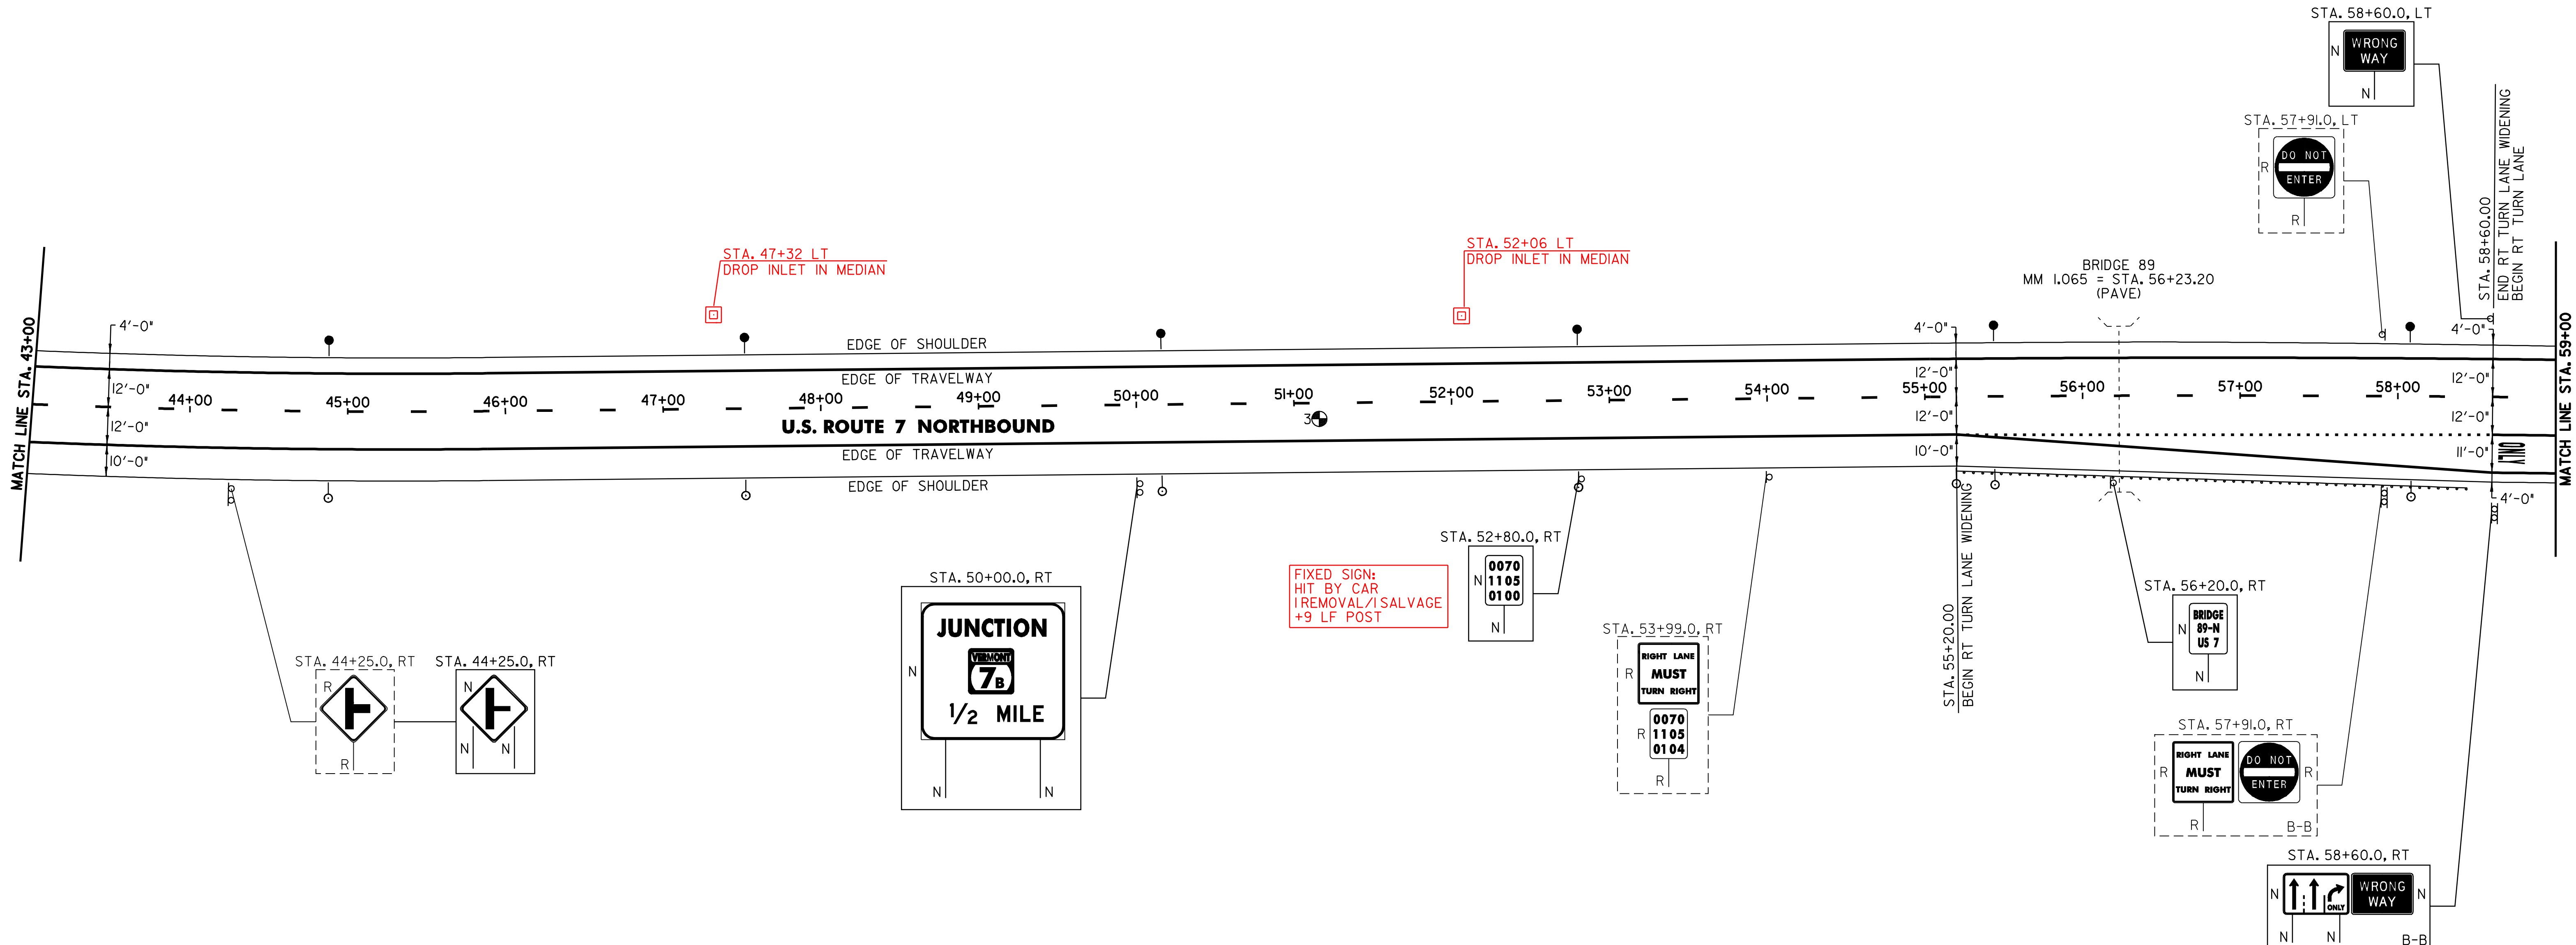

213.10 MILLED RUMBLE STRIPS

CLARENDON:
 STA. 43+00.0 TO STA. 59+00.0 LT (1600 FT)
 STA. 43+00.0 TO STA. 55+20.0 RT (920 FT)

621.20 STEEL BEAM GUARDRAIL (GALVANIZED)

CLARENDON:
~~STA. 55+57.0 - STA. 58+32.0 RT (275.0 FT)~~
~~STA. 56+37 - STA. 59+26 RT (287.5 FT)~~
 621.505 MANUFACTURED TERMINAL SECTION (FLARED)

CLARENDON:
~~STA. 55+99.5 - STA. 55+57.0 RT~~
~~STA. 55+99 - STA. 56+37 RT~~
 621.52 TRAILING END TERMINAL

CLARENDON:
 STA. 58+32.0 - STA. 58+46.2 RT
 STA. 59+26 - STA. 59+38 RT

621.80 REMOVAL AND DISPOSAL OF GUARDRAIL

CLARENDON:
~~STA. 55+20.0 - STA. 58+44.0 RT (324.0 FT)~~
~~STA. 55+99 - STA. 59+38 RT (337.5 FT)~~
 676.10 DELINEATORS WITH STEEL POSTS

♀ TYPE I WHITE ♂ TYPE I AMBER
 CLARENDON:
 STA. 44+88.0 RT STA. 44+88.0 LT
 STA. 47+52.0 RT STA. 47+52.0 LT
 STA. 50+16.0 RT STA. 50+16.0 LT
 STA. 52+80.0 RT STA. 52+80.0 LT
 STA. 55+19.5 RT STA. 55+44.0 LT
 STA. 55+44.0 RT STA. 58+08.0 LT
 STA. 58+08.0 RT

604.412 REHABING DI, CB, OR MH CLASS I

STA. 47+32 LT
 STA. 52+06 LT

SIGN LEGEND
 R= REMOVE
 S= SALVAGE
 N= NEW
 RET= RETAIN
 B-B= BACK TO BACK
 EXISTING= -----
 NEW= -----

PAVEMENT CORES = ●

#	TOTAL DEPTH (INCH)	PCC	COMMENTS
3	1.625	NO	

PROJECT LAYOUT SHEET #7

PROJECT NAME: WALLINGFORD - RUTLAND TOWN
 PROJECT NUMBER: AC NH 2207(1)S

FILE NAME: p99bl66.dgn PLOT DATE: 12-MAR-2007 11:28
 PROJECT LEADER: D.E.G. DRAWN BY: C.A.K.
 DESIGNED BY: D.W.E. CHECKED BY: D.E.G.
 SHEET 19 OF 95