

646.414 DURABLE 6" WHITE LINE (MOD.)(RETROREFLECTIVITY/INLAID)
 (ALL LINES WILL INCLUDE EDGE LINE BREAKS AND RADIUS FOR TOWN HIGHWAYS)

CLARENDON:
 STA. 107+00.00 - STA. 123+00.00 DASHED LINE C/L
 STA. 107+00.00 - STA. 123+00.00 EDGE LINE RT
 STA. 121+67.00 - STA. 123+00.00 DOTTED LANE LINE RT

646.415 DURABLE 6" YELLOW LINE (MOD.)(RETROREFLECTIVITY/INLAID)
 (ALL LINES WILL INCLUDE C/L BREAKS FOR TOWN HIGHWAYS) S=SOLID, D=DASHED

CLARENDON:
 STA. 107+00.00 - STA. 123+00.00 EDGE LINE LT


646.614 TEMPORARY 6" WHITE LINE (PAINT)
 (ALL LINES WILL INCLUDE EDGE LINE BREAKS AND RADIUS FOR TOWN HIGHWAYS)

CLARENDON:
 STA. 107+00.00 - STA. 123+00.00 DASHED LINE C/L
 STA. 107+00.00 - STA. 123+00.00 EDGE LINE RT
 STA. 121+67.00 - STA. 123+00.00 DOTTED LANE LINE RT

646.615 TEMPORARY 6" YELLOW LINE (PAINT)
 (ALL LINES WILL INCLUDE C/L BREAKS FOR TOWN HIGHWAYS) S=SOLID, D=DASHED

CLARENDON:
 STA. 107+00.00 - STA. 123+00.00 EDGE LINE LT

675.50 REMOVING SIGNS
 AS SHOWN - 2

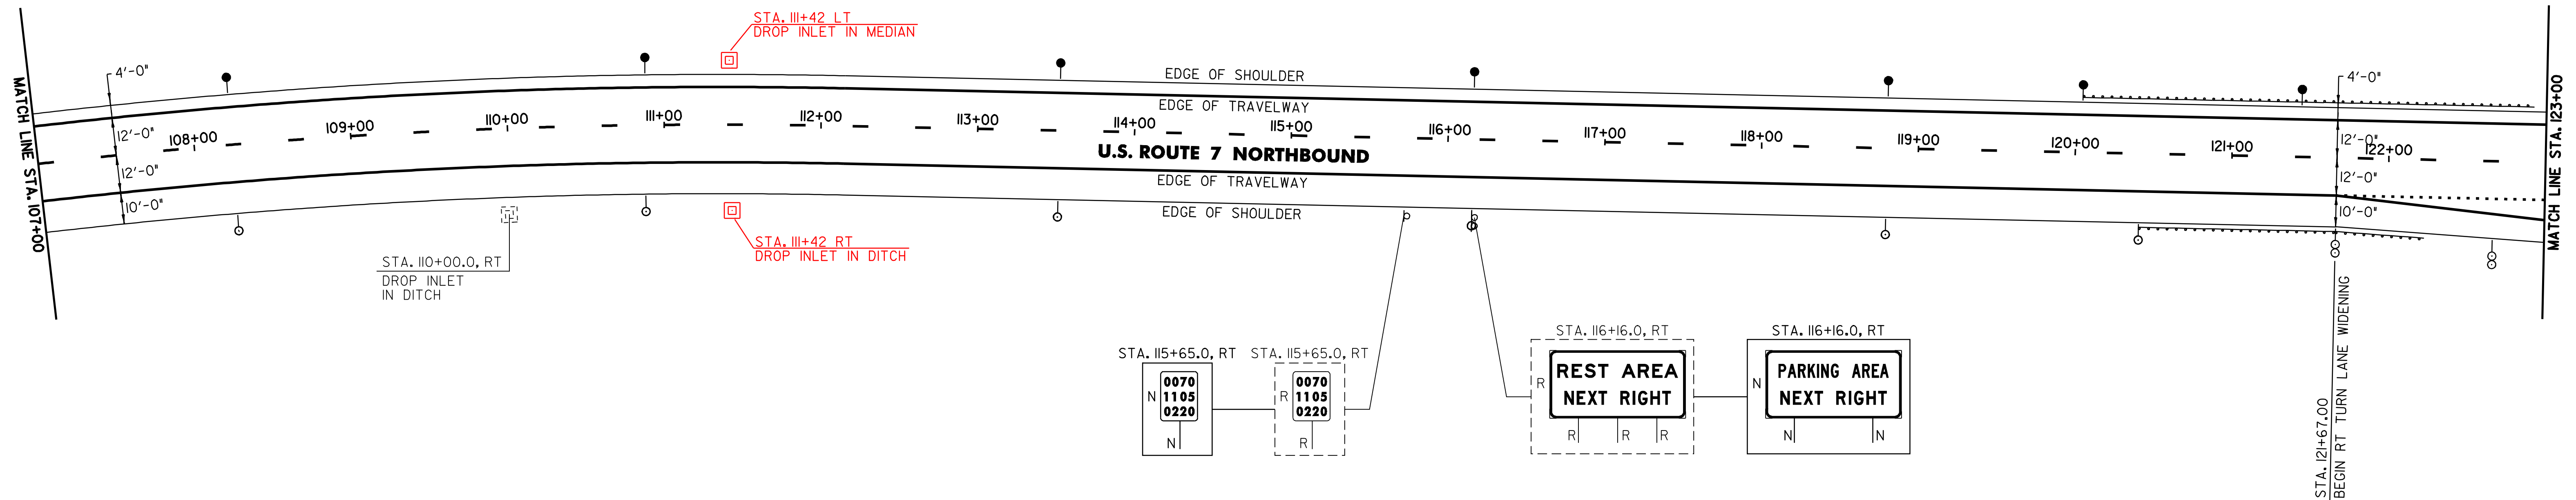

213.10 MILLED RUMBLE STRIPS

CLARENDON:
 STA. 107+00.0 - STA. 120+04.0 LT (1304 FT)
 STA. 107+00.0 - STA. 121+67.0 RT (1467 FT)
 STA. 122+69.0 - STA. 123+00.0 LT (31 FT)

604.412 REHABING DI, CB OR MH, CLASS I

CLARENDON: STA. 110+00.0 RT
 STA. 110+00.0 RT

621.20 STEEL BEAM GUARDRAIL (GALVANIZED)

CLARENDON:
 STA. 120+41.8 - STA. 122+79.3 LT (237.5 FT)
 STA. 120+78.8 - STA. 122+16.3 RT (137.5 FT)
 STA. 120+90 - STA. 122+125 (125 FT)

621.505 MANUFACTURED TERMINAL SECTION (FLARED)

CLARENDON: STA. 120+04.3 - STA. 120+41.8 LT
 STA. 120+41.3 - STA. 120+78.8 RT

621.52 TRAILING END TERMINAL

CLARENDON:
 STA. 122+16.3 - STA. 122+30.5 RT
 STA. 122+79.3 - STA. 122+93.5 LT

621.80 REMOVAL AND DISPOSAL OF GUARDRAIL

CLARENDON:
 STA. 120+07.0 - STA. 122+89.0 LT (282.0 FT)
 STA. 120+47.0 - STA. 122+23.0 RT (176.0 FT)

676.10 DELINEATORS WITH STEEL POSTS

○ TYPE I WHITE	● TYPE I AMBER	○ TYPE II WHITE
CLARENDON: STA. 108+24.0 RT STA. 110+88.0 RT STA. 113+52.0 RT STA. 116+16.0 RT STA. 118+80.0 RT STA. 120+41.3 RT	CLARENDON: STA. 108+24.0 LT STA. 110+88.0 LT STA. 113+52.0 LT STA. 116+16.0 LT STA. 118+80.0 LT STA. 120+04.3 LT STA. 121+44.0 LT	CLARENDON: STA. 121+67.0 RT STA. 122+67.0 RT

SIGN LEGEND

R= REMOVE
 S= SALVAGE
 N= NEW
 RET= RETAIN
 B-B= BACK TO BACK
 EXISTING= -----
 NEW= -----

PROJECT LAYOUT SHEET #11

PROJECT NAME: WALLINGFORD - RUTLAND TOWN
 PROJECT NUMBER: AC NH 2207(1)S

FILE NAME: p99bl66.dgn
 PROJECT LEADER: D.E.G.
 DESIGNED BY: D.W.E.

PLOT DATE: 12-MAR-2007 11:28
 DRAWN BY: C.A.K.
 CHECKED BY: D.E.G.
 SHEET 23 OF 95