

646.414 DURABLE 6" WHITE LINE (MOD.)(RETROREFLECTIVITY/INLAID)
 (ALL LINES WILL INCLUDE EDGE LINE BREAKS AND RADIUS FOR TOWN HIGHWAYS)
 CLARENDON:
 STA. 123+00.00 - STA. 139+00.00 DASHED LINE C/L
 STA. 123+00.00 - STA. 124+87.00 DOTTED LANE LINE RT
 STA. 123+00.00 - STA. 125+50.00 EDGE LINE RT
 STA. 124+87.00 - STA. 125+50.00 SOLID LANE LINE RT
 STA. 131+84.00 - STA. 139+00.00 EDGE LINE RT
 STA. 133+21.00 - STA. 135+23.00 DASHED LANE LINE RT

646.614 TEMPORARY 6" WHITE LINE (PAINT)
 (ALL LINES WILL INCLUDE EDGE LINE BREAKS AND RADIUS FOR TOWN HIGHWAYS)
 CLARENDON:
 STA. 123+00.00 - STA. 139+00.00 DASHED LINE C/L
 STA. 123+00.00 - STA. 124+87.00 DOTTED LANE LINE RT
 STA. 123+00.00 - STA. 125+50.00 EDGE LINE RT
 STA. 124+87.00 - STA. 125+50.00 SOLID LANE LINE RT
 STA. 131+84.00 - STA. 139+00.00 EDGE LINE RT
 STA. 133+21.00 - STA. 135+23.00 DASHED LANE LINE RT





675.50 REMOVING SIGNS
 AS SHOWN - 4

646.415 DURABLE 6" YELLOW LINE (MOD.)(RETROREFLECTIVITY/INLAID)
 (ALL LINES WILL INCLUDE C/L BREAKS FOR TOWN HIGHWAYS) S=SOLID, D=DASHED
 CLARENDON:
 STA. 123+00.00 - STA. 139+00.00 EDGE LINE LT


646.615 TEMPORARY 6" YELLOW LINE (PAINT)
 (ALL LINES WILL INCLUDE C/L BREAKS FOR TOWN HIGHWAYS) S=SOLID, D=DASHED
 CLARENDON:
 STA. 123+00.00 - STA. 139+00.00 EDGE LINE LT

646.44 DURABLE 12" WHITE LINE (MOD.)(RETROREFLECTIVITY/INLAID)
 CLARENDON:
 STA. 124+87.00 - STA. 125+50.00 SOLID LANE LINE RT
 STA. 131+84.00 - STA. 133+21.00 SOLID LANE LINE RT

646.64 TEMPORARY 12" WHITE LINE (PAINT)
 CLARENDON:
 STA. 124+87.00 - STA. 125+50.00 SOLID LANE LINE RT
 STA. 131+84.00 - STA. 133+21.00 SOLID LANE LINE RT

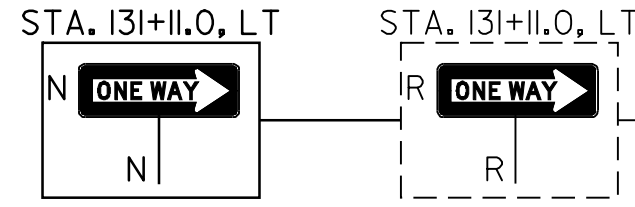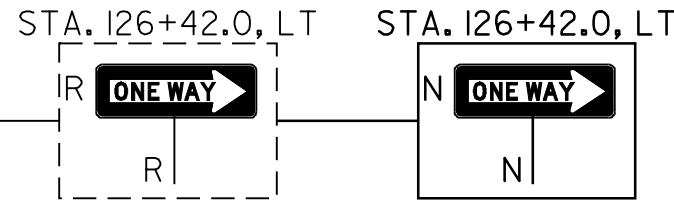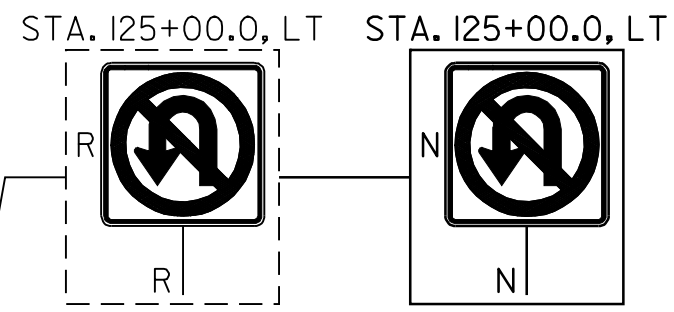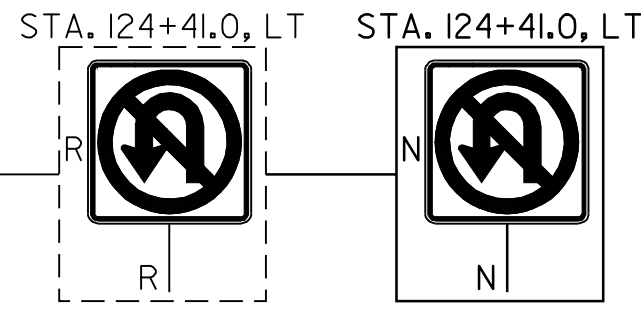

SEE SHEET 39 OF 95 FOR REST AREA
 SIGNING AND STRIPING DETAILS

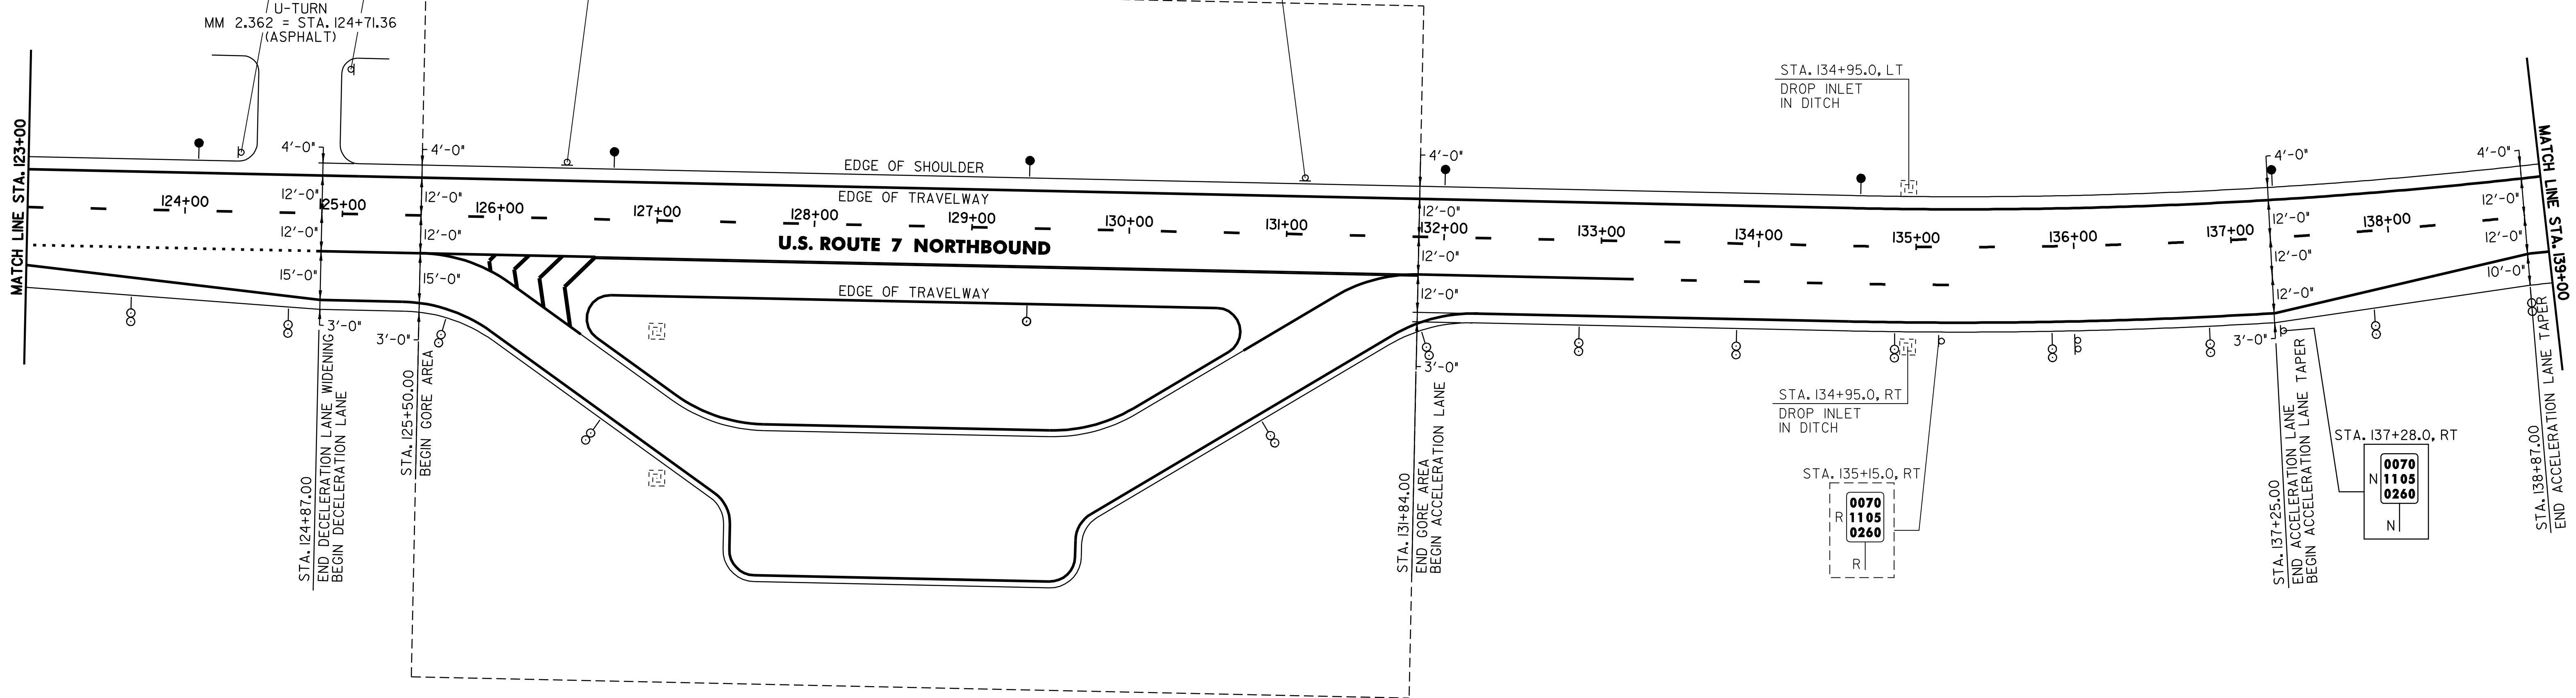

676.10 DELINEATORS WITH STEEL POSTS

○ TYPE I WHITE	● TYPE I AMBER	○ TYPE II WHITE
CLARENDON: STA. 129+36.0 RT	STA. 124+08.0 LT STA. 126+72.0 LT STA. 129+36.0 LT STA. 132+00.0 LT STA. 134+64.0 LT STA. 137+28.0 LT	STA. 123+67.0 RT STA. 124+67.0 RT STA. 125+67.0 RT STA. 126+67.0 RT STA. 130+87.0 RT STA. 131+87.0 RT STA. 132+87.0 RT STA. 133+87.0 RT STA. 134+87.0 RT STA. 135+87.0 RT STA. 136+87.0 RT STA. 137+87.0 RT STA. 138+87.0 RT

213.10 MILLED RUMBLE STRIPS

CLARENDON:
 STA. 123+00.0 TO STA. 123+98.0 LT (198 FT)
 STA. 125+44.0 TO STA. 139+00.0 LT (1356 FT)
 STA. 126+62.0 TO STA. 130+62.0 RT (400 FT)
 STA. 138+87.0 TO STA. 139+00.0 RT (13 FT)

604.412 REHABING DI, CB OR MH, CLASS I

CLARENDON:
 STA. 134+95.0 LT 134+50 LT
 STA. 134+95.0 RT 134+50 RT

SIGN LEGEND

R=	REMOVE
S=	SALVAGE
N=	NEW
RET=	RETAIN
B-B=	BACK TO BACK
EXISTING=	-----
NEW=	-----

PROJECT LAYOUT SHEET #12	PROJECT NAME: WALLINGFORD - RUTLAND TOWN	PLOT DATE: 12-MAR-2007 11:28
	PROJECT NUMBER: AC NH 2207(1)S	DRAWN BY: C.A.K.
	FILE NAME: p99bl66.dgn	CHECKED BY: D.E.G.
	DESIGNED BY: D.W.E.	SHEET 24 OF 95