

646.414 DURABLE 6" WHITE LINE (MOD.)(RETROREFLECTIVITY/INLAID)
 (ALL LINES WILL INCLUDE EDGE LINE BREAKS AND RADIUS FOR TOWN HIGHWAYS)
 CLARENDON:
 STA. 155+00.00 - STA. 170+00.00 DASHED LINE C/L
 STA. 155+00.00 - STA. 170+00.00 EDGE LINE RT

646.415 DURABLE 6" YELLOW LINE (MOD.)(RETROREFLECTIVITY/INLAID)
 (ALL LINES WILL INCLUDE C/L BREAKS FOR TOWN HIGHWAYS) S=SOLID, D=DASHED
 CLARENDON:
 STA. 155+00.00 - STA. 170+00.00 EDGE LINE LT


646.50 DURABLE LETTER OR SYMBOL (THERMOPLASTIC)
 CLARENDON:
 STA. 167+99.0 LT, "S,I,G,N,A,L" (6 EA)
 STA. 167+99.0 RT, "S,I,G,N,A,L" (6 EA)
 STA. 168+31.0 LT, "A,H,E,A,D" (5 EA)
 STA. 168+31.0 RT, "A,H,E,A,D" (5 EA)

646.614 TEMPORARY 6" WHITE LINE (PAINT)
 (ALL LINES WILL INCLUDE EDGE LINE BREAKS AND RADIUS FOR TOWN HIGHWAYS)
 CLARENDON:
 STA. 155+00.00 - STA. 170+00.00 DASHED LINE C/L
 STA. 155+00.00 - STA. 170+00.00 EDGE LINE RT

646.615 TEMPORARY 6" YELLOW LINE (PAINT)
 (ALL LINES WILL INCLUDE C/L BREAKS FOR TOWN HIGHWAYS) S=SOLID, D=DASHED
 CLARENDON:
 STA. 155+00.00 - STA. 170+00.00 EDGE LINE LT

646.70 TEMPORARY LETTER OR SYMBOL (PAINT)
 CLARENDON:
 STA. 167+99.0 LT, "S,I,G,N,A,L" (12 EA)
 STA. 167+99.0 RT, "S,I,G,N,A,L" (12 EA)
 STA. 168+31.0 LT, "A,H,E,A,D" (10 EA)
 STA. 168+31.0 RT, "A,H,E,A,D" (10 EA)

675.50 REMOVING SIGNS
 AS SHOWN - I

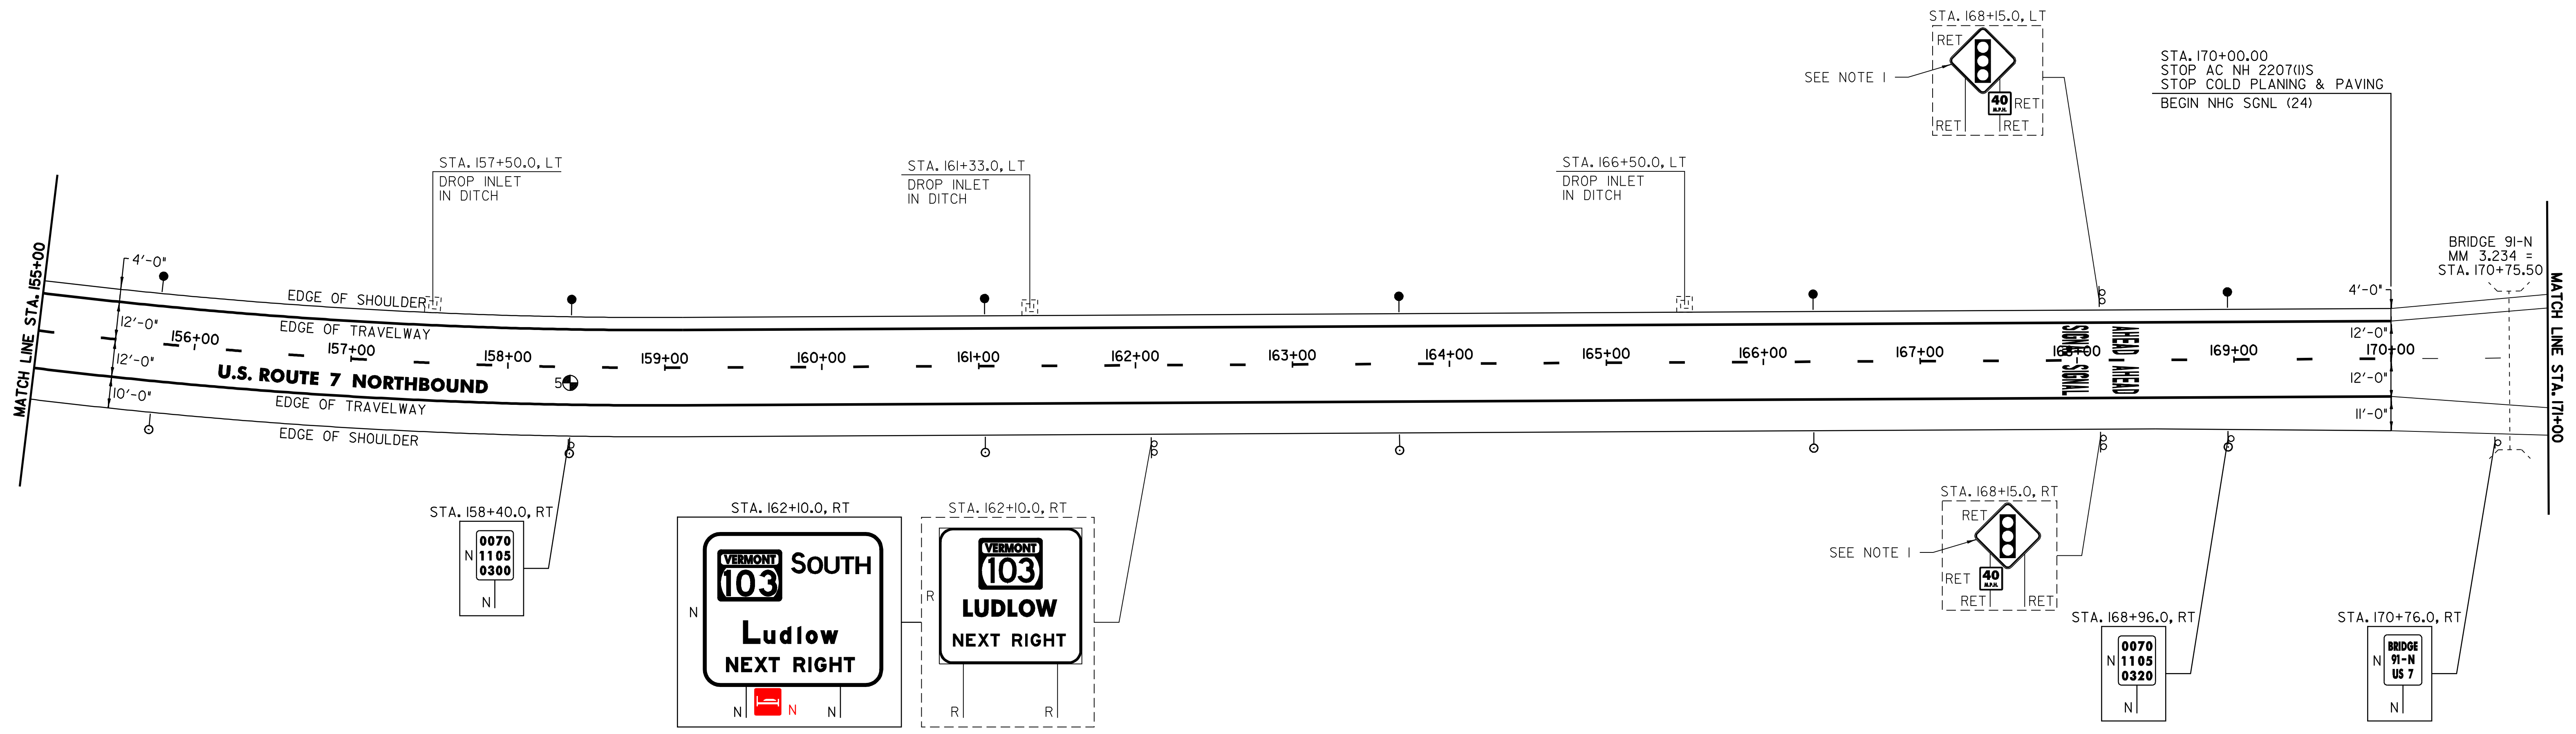

213.10 MILLED RUMBLE STRIPS

CLARENDON:
 STA. 155+00.0 TO STA. 170+00.0 LT (1500 FT)
 STA. 155+00.0 TO STA. 170+00.0 RT (1500 FT)

604.412 REHABING DI, CB OR MH, CLASS I

CLARENDON:
 STA. 157+50.0 LT 157+24 LT
 STA. 161+33.0 LT
 STA. 166+50.0 LT

676.10 DELINEATORS WITH STEEL POSTS

♀ TYPE I WHITE ● TYPE I AMBER

CLARENDON:
 STA. 155+76.0 RT STA. 155+76.0 LT
 STA. 158+40.0 RT STA. 158+40.0 LT
 STA. 161+04.0 RT STA. 161+04.0 LT
 STA. 163+68.0 RT STA. 163+68.0 LT
 STA. 166+32.0 RT STA. 166+32.0 LT
 STA. 168+96.0 RT STA. 168+96.0 LT

NOTE:

I. THE EXISTING SIGNAL AHEAD SIGNS SHALL BE INSTALLED UNDER THE NHG SGNL(24) PROJECT.

SIGN LEGEND

R= REMOVE
 S= SALVAGE
 N= NEW
 RET= RETAIN
 B-B= BACK TO BACK
 EXISTING= -----
 NEW= -----

PROJECT LAYOUT SHEET #14

PROJECT NAME: WALLINGFORD - RUTLAND TOWN
 PROJECT NUMBER: AC NH 2207(1)S
 FILE NAME: p99bl66.dgn
 PROJECT LEADER: D.E.G.
 DESIGNED BY: D.W.E.
 PLOT DATE: 12-MAR-2007 11:29
 DRAWN BY: C.A.K.
 CHECKED BY: D.E.G.
 SHEET 26 OF 95

| PAVEMENT CORES = ● | | |
|--------------------|--------------------|--------------|
| # | TOTAL DEPTH (INCH) | PCC COMMENTS |
| 5 | 1.625 | NO |