

646.414 DURABLE 6" WHITE LINE (MOD.) (RETROREFLECTIVITY/INLAID)
 (ALL LINES WILL INCLUDE EDGE LINE BREAKS AND RADIUS FOR TOWN HIGHWAYS)

CLARENDON:
 STA. 177+50.00 - STA. 187+00.00 DASHED LINE C/L
 STA. 177+50.00 - STA. 187+00.00 EDGE LINE RT
 STA. 182+00.00 - STA. 182+96.50 DASHED LANE LINE RT

646.415 DURABLE 6" YELLOW LINE (MOD.) (RETROREFLECTIVITY/INLAID)
 (ALL LINES WILL INCLUDE C/L BREAKS FOR TOWN HIGHWAYS) S=SOLID, D=DASHED

CLARENDON:
 STA. 177+50.00 - STA. 187+00.00 EDGE LINE LT

646.614 TEMPORARY 6" WHITE LINE (PAINT)
 (ALL LINES WILL INCLUDE EDGE LINE BREAKS AND RADIUS FOR TOWN HIGHWAYS)

CLARENDON:
 STA. 177+50.00 - STA. 187+00.00 DASHED LINE C/L
 STA. 177+50.00 - STA. 187+00.00 EDGE LINE RT
 STA. 182+00.00 - STA. 182+96.50 DASHED LANE LINE RT

646.615 TEMPORARY 6" YELLOW LINE (PAINT)
 (ALL LINES WILL INCLUDE C/L BREAKS FOR TOWN HIGHWAYS) S=SOLID, D=DASHED

CLARENDON:
 STA. 177+50.00 - STA. 187+00.00 EDGE LINE LT

646.44 DURABLE 12" WHITE LINE (MOD.) (RETROREFLECTIVITY/INLAID)

CLARENDON:
 STA. 179+04.0 - STA. 180+23.0 GORE AREA RT
 STA. 180+23.0 - STA. 182+00.0 SOLID LANE LINE RT

646.64 TEMPORARY 12" WHITE LINE (PAINT)

CLARENDON:
 STA. 179+04.0 - STA. 180+23.0 GORE AREA RT
 STA. 180+23.0 - STA. 182+00.0 SOLID LANE LINE RT

646.50 DURABLE LETTER OR SYMBOL (THERMOPLASTIC)


CLARENDON:
 STA. 179+04.4 RT, YIELD LINE (5 EA)

646.70 TEMPORARY LETTER OR SYMBOL (PAINT)

CLARENDON:
 STA. 179+04.4 RT, YIELD LINE (10 EA)

675.50 REMOVING SIGNS

AS SHOWN - 10

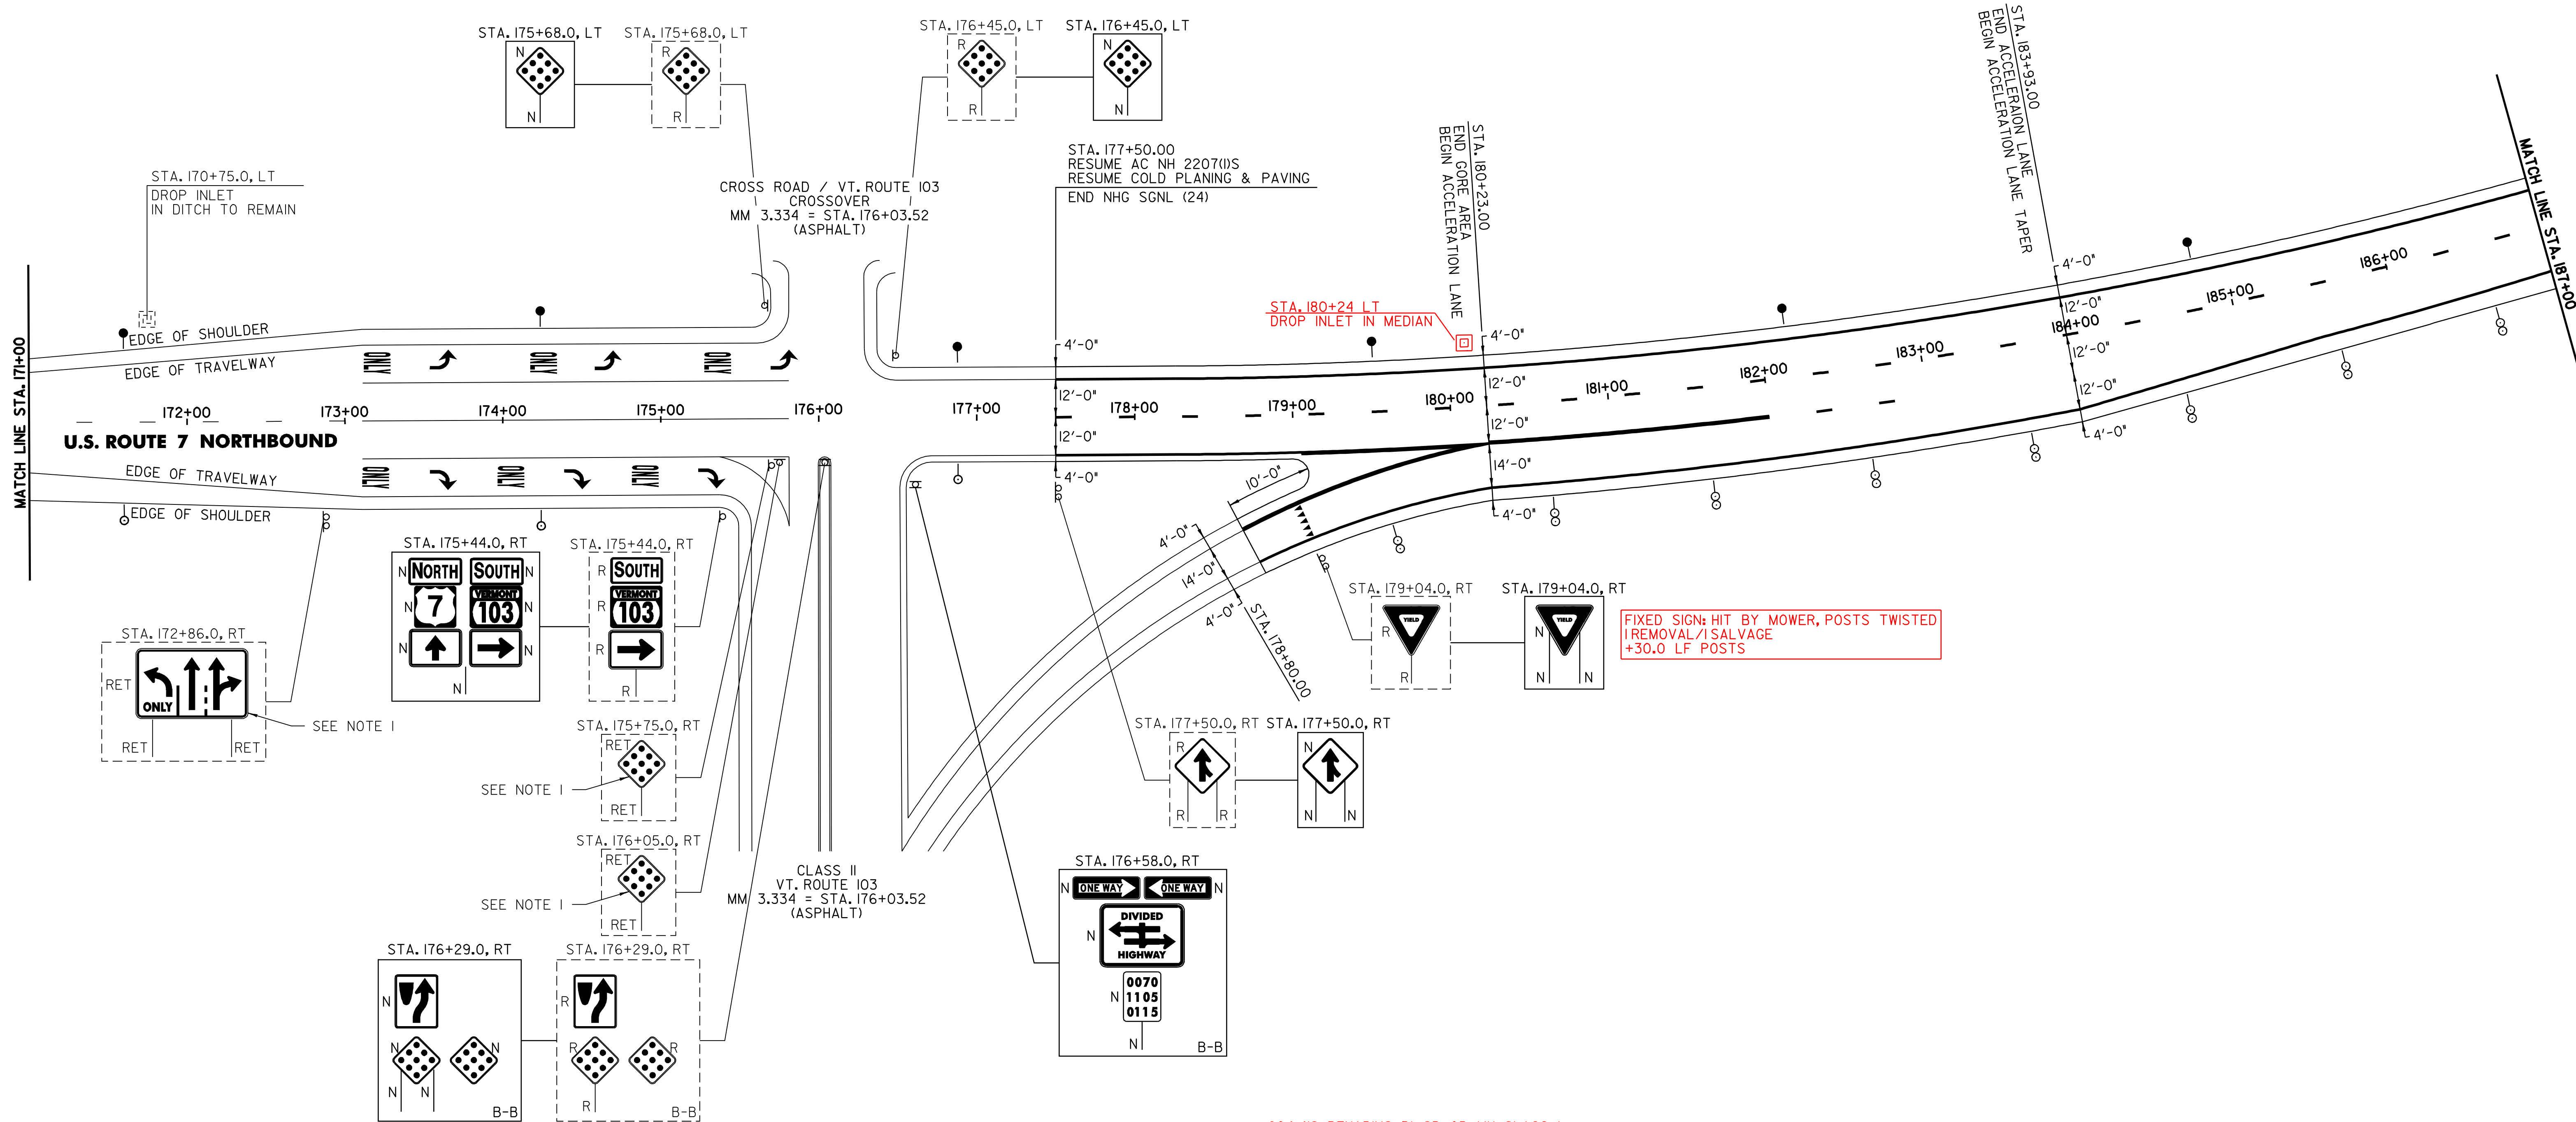

604.412 REHABING DI, CB OR MH CLASS I
 STA. 180+24 LT

213.10 MILLED RUMBLE STRIPS

CLARENDON:
 STA. 176+58.0 TO STA. 179+04.0 RT (246 FT)
 STA. 177+50.0 TO STA. 187+00.0 LT (950 FT)

676.10 DELINEATORS WITH STEEL POSTS

TYPE I WHITE
 CLARENDON:
 STA. 171+60.0 RT
 STA. 174+24.0 RT
 STA. 176+88.0 RT

TYPE I AMBER
 STA. 171+60.0 LT
 STA. 174+24.0 LT
 STA. 176+88.0 LT

TYPE II WHITE

CLARENDON:
 STA. 179+60.0 RT
 STA. 180+60.0 RT
 STA. 181+60.0 RT
 STA. 182+60.0 RT
 STA. 183+60.0 RT
 STA. 184+60.0 RT
 STA. 185+60.0 RT
 STA. 186+60.0 RT

NOTE:

1. THESE EXISTING SIGNS SHOWN SHALL BE INSTALLED UNDER THE NHG SGNL(24) PROJECT.

SIGN LEGEND

R= REMOVE
 S= SALVAGE
 N= NEW
 RET= RETAIN
 B-B= BACK TO BACK
 EXISTING= -----
 NEW= -----

PROJECT LAYOUT SHEET #15	PROJECT NAME: WALLINGFORD - RUTLAND TOWN	PLOT DATE: 12-MAR-2007 11:29
	PROJECT NUMBER: AC NH 2207(1)S	DRAWN BY: C.A.K.
	FILE NAME: p99b166.dgn	CHECKED BY: D.E.G.
	PROJECT LEADER: D.E.G.	SHEET 27 OF 95
	DESIGNED BY: D.W.E.	