

646.414 DURABLE 6" WHITE LINE (MOD.) (RETROREFLECTIVITY/INLAID)
 (ALL LINES WILL INCLUDE EDGE LINE BREAKS AND RADIUS FOR TOWN HIGHWAYS)
 CLARENDON:
 STA. 219+00.00 - STA. 235+00.00 DASHED LINE C/L
 STA. 219+00.00 - STA. 235+00.00 EDGE LINE RT

646.415 DURABLE 6" YELLOW LINE (MOD.) (RETROREFLECTIVITY/INLAID)
 (ALL LINES WILL INCLUDE C/L BREAKS FOR TOWN HIGHWAYS) S=SOLID, D=DASHED
 CLARENDON:
 STA. 219+00.00 - STA. 235+00.00 EDGE LINE LT


646.614 TEMPORARY 6" WHITE LINE (PAINT)
 (ALL LINES WILL INCLUDE EDGE LINE BREAKS AND RADIUS FOR TOWN HIGHWAYS)
 CLARENDON:
 STA. 219+00.00 - STA. 235+00.00 DASHED LINE C/L
 STA. 219+00.00 - STA. 235+00.00 EDGE LINE RT

646.615 TEMPORARY 6" YELLOW LINE (PAINT)
 (ALL LINES WILL INCLUDE C/L BREAKS FOR TOWN HIGHWAYS) S=SOLID, D=DASHED
 CLARENDON:
 STA. 219+00.00 - STA. 235+00.00 EDGE LINE LT

646.81 PAINTED CURB

CLARENDON:
 STA. 231+50.00 - STA. 235+00.00 LT (350 FT)

675.50 REMOVING SIGNS
 AS SHOWN - I

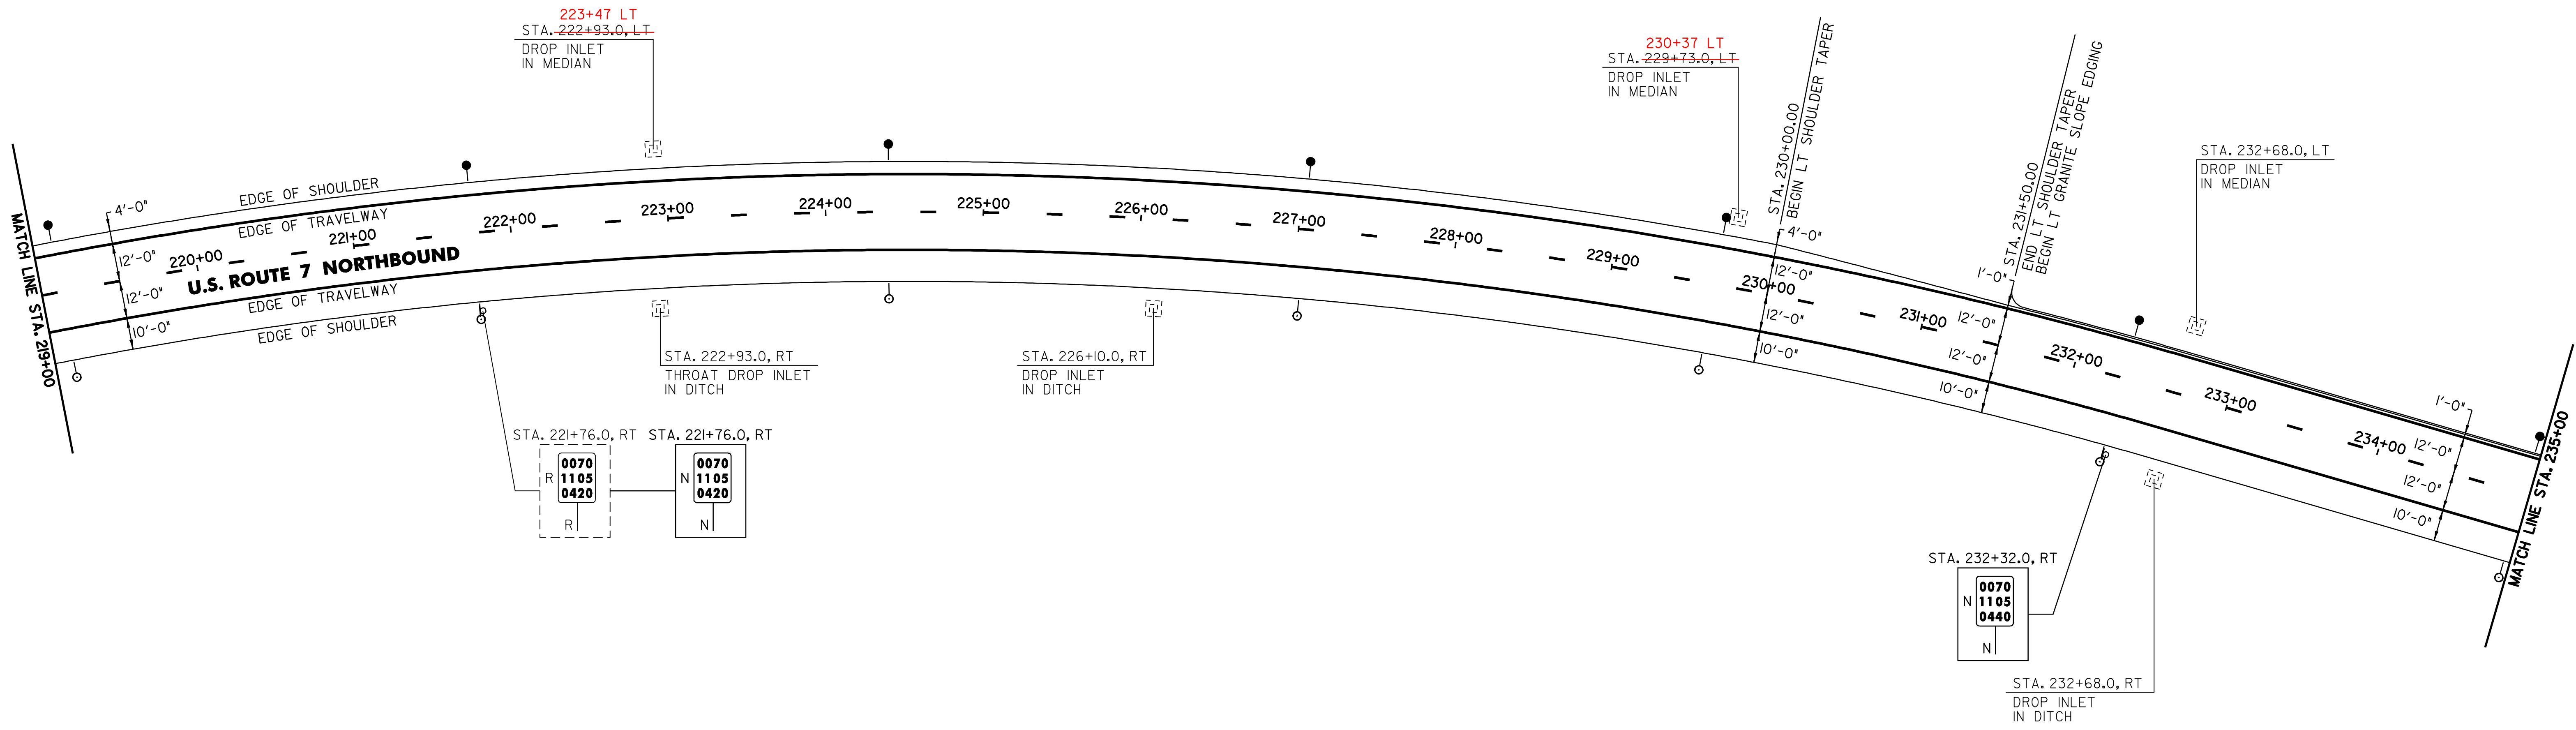

213.10 MILLED RUMBLE STRIPS

CLARENDON:
 STA. 219+00.0 TO STA. 230+00.0 LT (1100 FT)
 STA. 219+00.0 TO STA. 235+00.0 RT (1600 FT)

604.412 REHABING DI, CB OR MH, CLASS I

CLARENDON:
 STA. 222+93.0 LT 223+47 LT
 STA. 222+93.0 RT
 STA. 226+10.0 RT 230+37 LT
 STA. 229+73.0 LT
 STA. 232+68.0 LT
 STA. 232+68.0 RT

676.10 DELINEATORS WITH STEEL POSTS

○ TYPE I WHITE ● TYPE I AMBER

CLARENDON:
 STA. 219+12.2 RT STA. 219+12.2 LT
 STA. 221+76.0 RT STA. 221+76.0 LT
 STA. 224+40.0 RT STA. 224+40.0 LT
 STA. 227+04.0 RT STA. 227+04.0 LT
 STA. 229+68.0 RT STA. 229+68.0 LT
 STA. 232+32.0 RT STA. 232+32.0 LT
 STA. 234+96.0 RT STA. 234+96.0 LT

SIGN LEGEND

R= REMOVE
 S= SALVAGE
 N= NEW
 RET= RETAIN
 B-B= BACK TO BACK
 EXISTING= -----
 NEW= -----

PROJECT LAYOUT SHEET #18

PROJECT NAME: WALLINGFORD - RUTLAND TOWN
 PROJECT NUMBER: AC NH 2207(I)S

FILE NAME: p99bl66.dgn
 PROJECT LEADER: D.E.G.
 DESIGNED BY: D.W.E.

PLOT DATE: 12-MAR-2007 11:29
 DRAWN BY: C.A.K.
 CHECKED BY: D.E.G.
 SHEET 30 OF 95