

646.414 DURABLE 6" WHITE LINE (MOD.) (RETROREFLECTIVITY/INLAID)
 (ALL LINES WILL INCLUDE EDGE LINE BREAKS AND RADIUS FOR TOWN HIGHWAYS)
 RUTLAND TOWN:
 STA. 298+00.00 - STA. 298+68.96 EDGE LINE RT
 STA. 298+00.00 - STA. 298+68.96 DASHED LINE C/L

CLARENDON:
 STA. 0+00.00 - STA. 15+00.00 DASHED LINE C/L
 STA. 0+00.00 - STA. 15+00.00 EDGE LINE RT
 STA. 1+37.00 - STA. 3+22.00 DOTTED LANE LINE LT
 STA. 3+22.00 - STA. 5+39.00 SOLID LANE LINE LT
 STA. 13+22.00 - STA. 14+50.00 DOTTED LANE LINE LT
 STA. 14+50.00 - STA. 15+00.00 SOLID LANE LINE LT
 STA. 14+50.00 - STA. 15+00.00 DOTTED LANE LINE RT

646.415 DURABLE 6" YELLOW LINE (MOD.) (RETROREFLECTIVITY/INLAID)
 (ALL LINES WILL INCLUDE C/L BREAKS FOR TOWN HIGHWAYS) S=SOLID, D=DASHED

RUTLAND TOWN:
 STA. 298+00.00 - STA. 298+68.96 EDGE LINE LT

CLARENDON:
 STA. 0+00.00 - STA. 15+00.00 DASHED LINE C/L

646.614 TEMPORARY 6" WHITE LINE (PAINT)
 (ALL LINES WILL INCLUDE EDGE LINE BREAKS AND RADIUS FOR TOWN HIGHWAYS)
 RUTLAND TOWN:
 STA. 298+00.00 - STA. 298+68.96 EDGE LINE RT
 STA. 298+00.00 - STA. 298+68.96 DASHED LINE C/L

CLARENDON:
 STA. 0+00.00 - STA. 15+00.00 DASHED LINE C/L
 STA. 0+00.00 - STA. 15+00.00 EDGE LINE RT
 STA. 1+37.00 - STA. 3+22.00 DOTTED LANE LINE LT
 STA. 3+22.00 - STA. 5+39.00 SOLID LANE LINE LT
 STA. 13+22.00 - STA. 14+50.00 DOTTED LANE LINE LT
 STA. 14+50.00 - STA. 15+00.00 SOLID LANE LINE LT
 STA. 14+50.00 - STA. 15+00.00 DOTTED LANE LINE RT

646.615 TEMPORARY 6" YELLOW LINE (PAINT)
 (ALL LINES WILL INCLUDE C/L BREAKS FOR TOWN HIGHWAYS) S=SOLID, D=DASHED

RUTLAND TOWN:
 STA. 298+00.00 - STA. 298+68.96 EDGE LINE LT

CLARENDON:
 STA. 0+00.00 - STA. 16+00.00 DASHED LINE C/L

646.40 DURABLE 4" WHITE LINE (MOD.) (RETROREFLECTIVITY/INLAID)
 RUTLAND TOWN:
 STA. 5+96.64 SOLID LANE LINE RT, T-35
 STA. 5+96.64 EDGE LINE RT, T-35

646.41 DURABLE 4" YELLOW LINE (MOD.) (RETROREFLECTIVITY/INLAID)

RUTLAND TOWN:
 STA. 5+96.64 DOUBLE SOLID LINE RT, T-35

646.60 TEMPORARY 4" WHITE LINE (PAINT)
 RUTLAND TOWN:
 STA. 5+96.64 SOLID LANE LINE RT, T-35
 STA. 5+96.64 EDGE LINE RT, T-35

646.61 TEMPORARY 4" YELLOW LINE (PAINT)

RUTLAND TOWN:
 STA. 5+96.64 DOUBLE SOLID LINE RT, T-35

646.46 DURABLE 24" STOP BAR (THERMOPLASTIC)
 RUTLAND TOWN:
 STA. 5+40.00
 STA. 5+96.64 RT, T-35

646.66 TEMPORARY 24" STOP BAR (PAINT)

RUTLAND TOWN:
 STA. 5+40.00
 STA. 5+96.64 RT, T-35

646.50 DURABLE LETTER OR SYMBOL (THERMOPLASTIC)

RUTLAND TOWN:
 STA. 3+26.2 LT, "O,N,L,Y" (4 EA)
 STA. 3+67.1 LT, ARROW (1 EA)
 STA. 4+08.0 LT, "O,N,L,Y" (4 EA)
 STA. 4+48.9 LT, ARROW (1 EA)
 STA. 4+89.8 LT, "O,N,L,Y" (4 EA)
 STA. 5+30.7 LT, ARROW (1 EA)
 STA. 5+96.64 RT, T-35, ARROW (3 EA)
 STA. 5+96.64 RT, T-35, "O,N,L,Y" (4 EA)
 STA. 14+54.2 LT, "O,N,L,Y" (4 EA) ARROW (1 EA)
 STA. 14+92 LT, "O,N,L,Y" (4 EA)

646.70 TEMPORARY LETTER OR SYMBOL (PAINT)

RUTLAND TOWN:
 STA. 3+67.1 LT, ARROW (2 EA)
 STA. 5+30.7 LT, ARROW (2 EA)
 STA. 5+96.64 RT, T-35, ARROW (6 EA)

675.50 REMOVING SIGNS
 AS SHOWN - 16


675.60 ERECTING SALVAGED SIGNS

AS SHOWN - 1

646.81 PAINTED CURB

CLARENDON:
 STA. 298+00.00 - STA. 298+68.93 (68.96 FT)

RUTLAND TOWN:
 STA. 0+00.00 - STA. 5+42.00 (542 FT)
 STA. 6+33.00 - STA. 15+00.00 (867 FT)

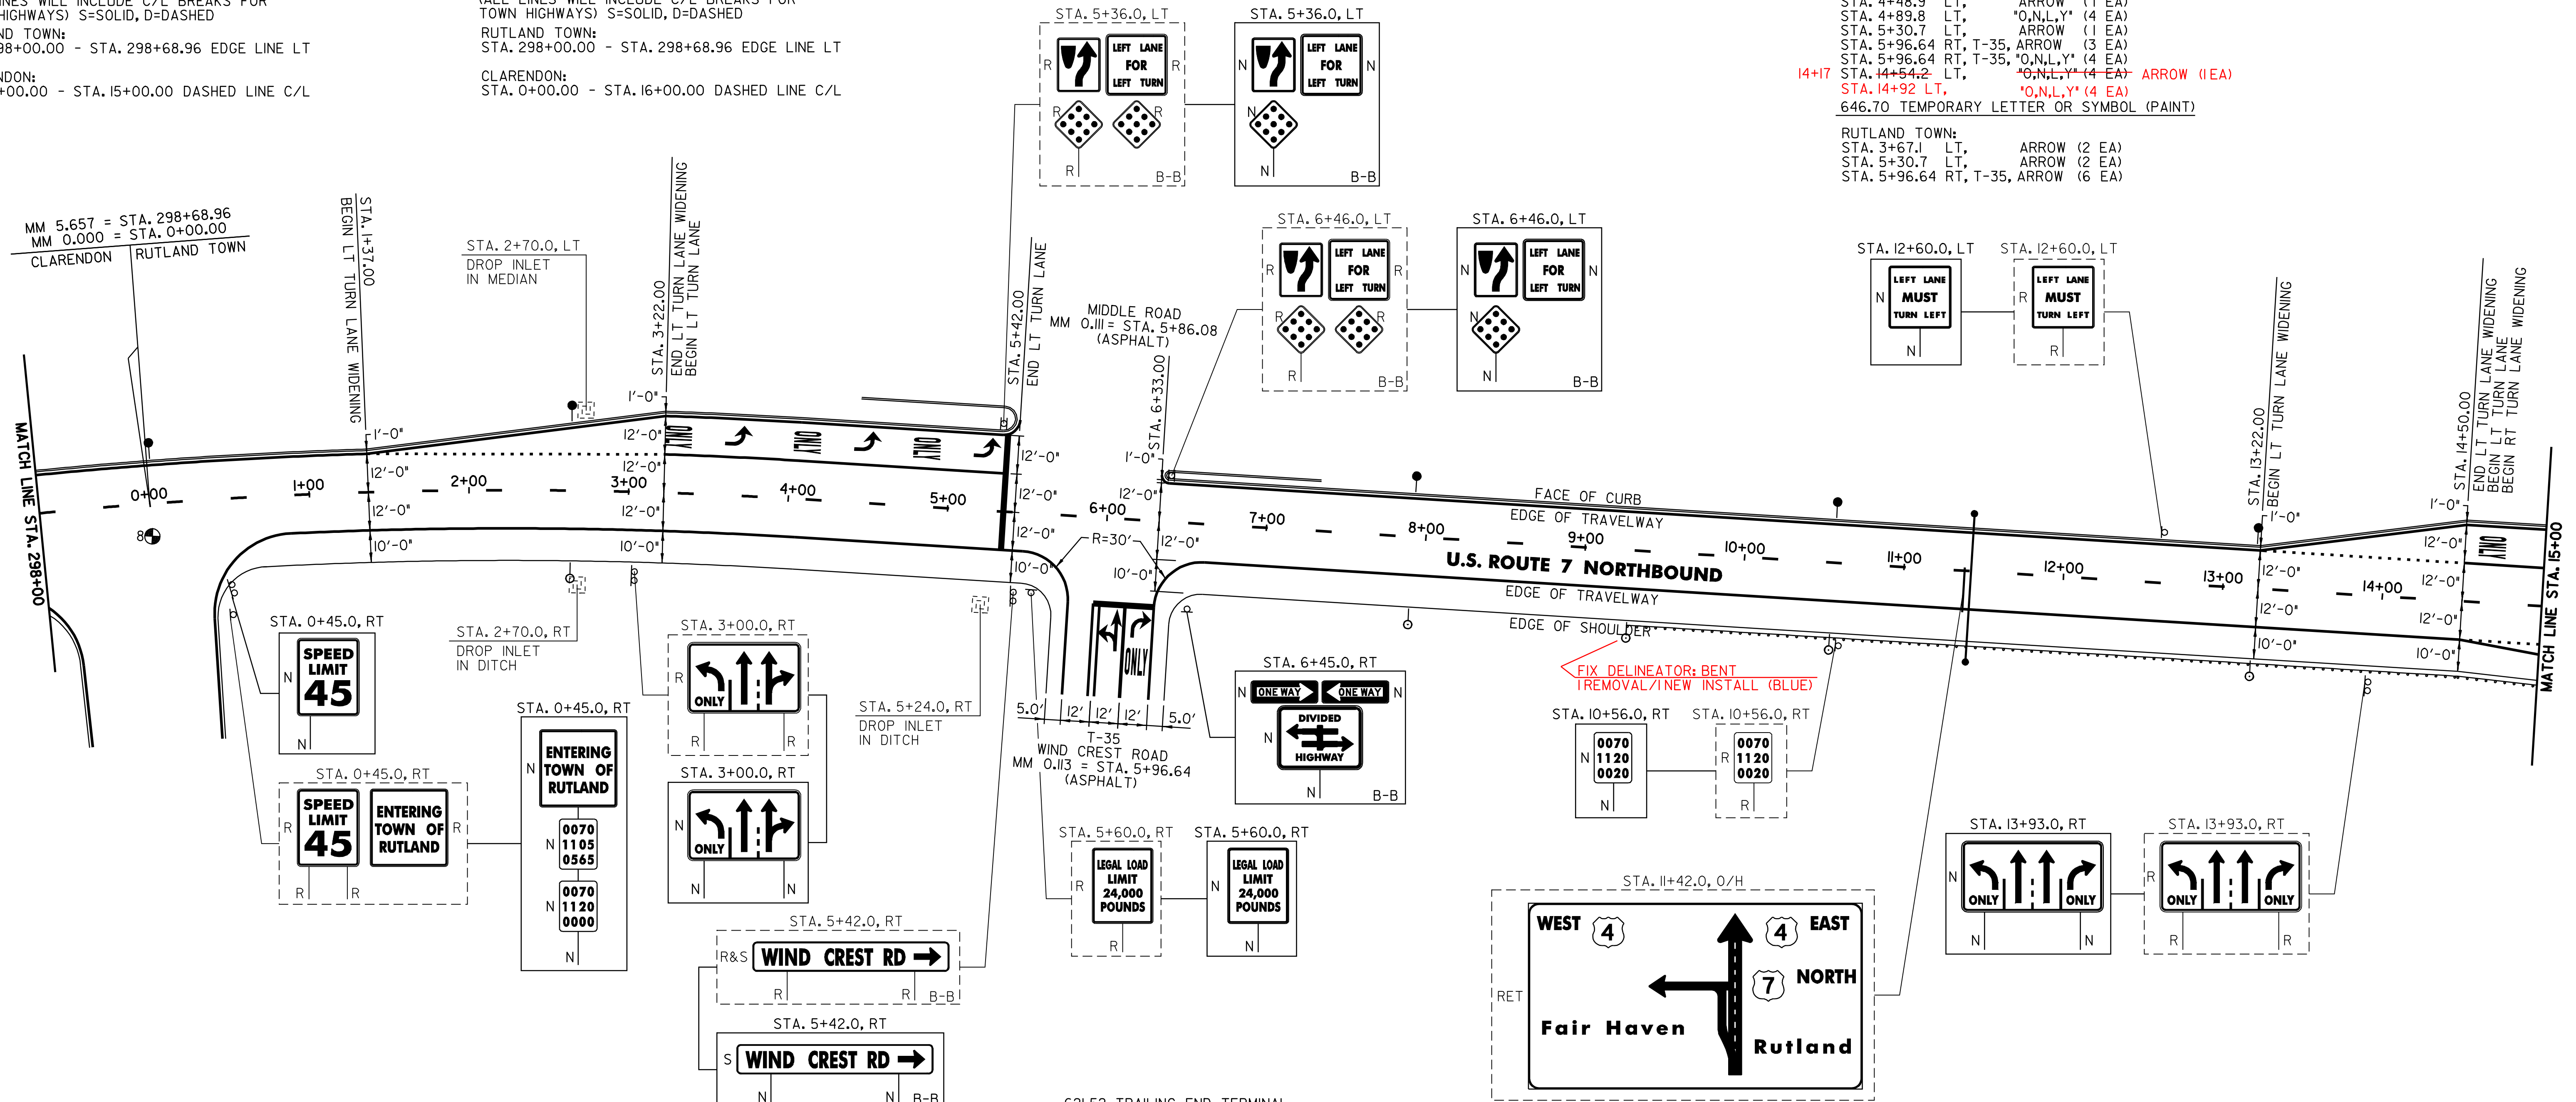

213.10 MILLED RUMBLE STRIPS

RUTLAND TOWN:
 STA. 0+93.0 - STA. 5+19.0 RT (426 FT)
 STA. 6+85.0 - STA. 14+50.0 RT (765 FT)

604.412 REHABING DI, CB OR MH, CLASS I

RUTLAND TOWN:
 STA. 2+70.0 RT
 STA. 2+70.0 LT
 STA. 5+24.0 RT

616.35 TREATED TIMBER CURB

RUTLAND TOWN:
 STA. 10+84.0 - STA. 14+68.0 RT (384 FT)

616.47 BITUMINOUS CONCRETE GUTTERS AND TRAFFIC ISLAND

RUTLAND TOWN:
 STA. 10+84.0 - STA. 15+00.0 RT (1 TON)

621.20 STEEL BEAM GUARDRAIL (GALVANIZED)

RUTLAND TOWN:
 STA. 9+66.3 - STA. 14+91.3 RT (525 FT)

621.505 MANUFACTURED TERMINAL SECTION (FLARED)

RUTLAND TOWN:
 STA. 9+28.8 - STA. 9+66.3 RT

621.52 TRAILING END TERMINAL

RUTLAND TOWN:
 STA. 14+91.3 - STA. 15+00 RT

621.80 REMOVAL AND DISPOSAL OF GUARDRAIL

RUTLAND TOWN:
 STA. 10+60.0 - STA. 15+00.0 RT (440.0 FT)

676.10 DELINEATORS WITH STEEL POSTS

♀ TYPE I WHITE ♂ TYPE I AMBER

RUTLAND TOWN:
 STA. 2+64.0 RT
 STA. 7+92.0 RT
 STA. 9+28.8 RT
 STA. 10+56.0 RT
 STA. 13+20.0 RT

STA. 0+00.0 LT
 STA. 2+64.0 LT
 STA. 7+92.0 LT
 STA. 10+56.0 LT
 STA. 13+20.0 LT

SIGN LEGEND
 R= REMOVE
 S= SALVAGE
 N= NEW
 RET= RETAIN
 B-B= BACK TO BACK
 EXISTING= _____
 NEW= _____

PAVEMENT CORES = ●

#	TOTAL DEPTH (INCH)	PCC	COMMENTS
8	1.5	NO	

PROJECT LAYOUT SHEET #23

PROJECT NAME: WALLINGFORD - RUTLAND TOWN
 PROJECT NUMBER: AC NH 2207(1)S

FILE NAME: p99b166.dgn
 PROJECT LEADER: D.E.G.
 DESIGNED BY: D.W.E.

PLOT DATE: 12-MAR-2007 11:29
 DRAWN BY: C.A.K.
 CHECKED BY: D.E.G.
 SHEET 35 OF 95