

646.414 DURABLE 6" WHITE LINE (MOD.) (RETROREFLECTIVITY/INLAID)
 (ALL LINES WILL INCLUDE EDGE LINE BREAKS AND RADIUS FOR TOWN HIGHWAYS)
 RUTLAND TOWN:
 STA. 15+00.00 - STA. 31+00.00 EDGE LINE RT
 STA. 15+00.00 - STA. 31+00.00 DASHED LINE C/L
 STA. 15+00.00 - STA. 16+42.00 DOTTED LANE LINE RT
 STA. 15+00.00 - STA. 18+56.00 SOLID LANE LINE LT
 STA. 16+42.00 - STA. 18+13.00 SOLID LANE LINE RT

646.614 TEMPORARY 6" WHITE LINE (PAINT)
 (ALL LINES WILL INCLUDE EDGE LINE BREAKS AND RADIUS FOR TOWN HIGHWAYS)
 RUTLAND TOWN:
 STA. 15+00.00 - STA. 31+00.00 EDGE LINE RT
 STA. 15+00.00 - STA. 31+00.00 DASHED LINE C/L
 STA. 15+00.00 - STA. 16+42.00 DOTTED LANE LINE RT
 STA. 15+00.00 - STA. 18+56.00 SOLID LANE LINE LT
 STA. 16+42.00 - STA. 18+13.00 SOLID LANE LINE RT

646.40 DURABLE 4" WHITE LINE (MOD.) (RETROREFLECTIVITY/INLAID)
 RUTLAND TOWN:
 STA. 18+43.00 - STA. 18+65.00 RAISED ISLAND RT
 STA. 19+27.20 EDGE LINE RT, DIAMOND RUN MALL PLACE
 STA. 19+27.20 SOLID LANE LINE RT, DIAMOND RUN MALL PLACE
 STA. 19+43.00 - STA. 19+68.00 RAISED ISLAND RT

646.60 TEMPORARY 4" WHITE LINE (PAINT)
 RUTLAND TOWN:
 STA. 18+43.00 - STA. 18+65.00 RAISED ISLAND RT
 STA. 19+27.20 EDGE LINE RT, DIAMOND RUN MALL PLACE
 STA. 19+27.20 SOLID LANE LINE RT, DIAMOND RUN MALL PLACE
 STA. 19+43.00 - STA. 19+68.00 RAISED ISLAND RT

646.41 DURABLE 4" YELLOW LINE (MOD.) (RETROREFLECTIVITY/INLAID)
 RUTLAND TOWN:
 STA. 18+43.00 - STA. 18+65.00 RAISED ISLAND RT
 STA. 19+27.20 RAISED MEDIAN RT, DIAMOND RUN MALL PLACE
 STA. 19+43.00 - STA. 19+68.00 RAISED ISLAND RT

646.61 TEMPORARY 4" YELLOW LINE (PAINT)
 RUTLAND TOWN:
 STA. 18+43.00 - STA. 18+65.00 RAISED ISLAND RT
 STA. 19+27.20 RAISED MEDIAN RT, DIAMOND RUN MALL PLACE
 STA. 19+43.00 - STA. 19+68.00 RAISED ISLAND RT

646.44 DURABLE 12" WHITE LINE (MOD.) (RETROREFLECTIVITY/INLAID)
 RUTLAND TOWN:
 STA. 18+13.00 - STA. 18+43.00 GORE LINE RT

646.64 TEMPORARY 12" WHITE LINE (PAINT)
 RUTLAND TOWN:
 STA. 18+13.00 - STA. 18+43.00 GORE LINE RT


646.81 PAINTED CURB
 RUTLAND TOWN:
 STA. 15+00.00 - STA. 18+57.00 LT (357 FT)
 STA. 18+43.00 - STA. 18+65.00 RAISED ISLAND RT (88 FT)
 STA. 19+27.20 RAISED MEDIAN RT, DIAMOND RUN MALL PLACE (125 FT)
 STA. 19+43.00 - STA. 19+68.00 RAISED ISLAND RT (100 FT)
 STA. 19+95.00 - STA. 31+00.00 LT (1105 FT)

646.46 DURABLE 24" STOP BAR (THERMOPLASTIC)
 RUTLAND TOWN:
 STA. 18+57.00
 STA. 19+27.20 RT, DIAMOND RUN MALL PLACE

646.66 TEMPORARY 24" STOP BAR (PAINT)
 RUTLAND TOWN:
 STA. 18+57.00
 STA. 19+27.20 RT, DIAMOND RUN MALL PLACE

646.50 DURABLE LETTER OR SYMBOL (THERMOPLASTIC)
 RUTLAND TOWN:
 STA. 15+30.9 LT, ARROW (1 EA)
 STA. 16+09.6 LT, "O,N,L,Y" (4 EA)
 STA. 16+46.2 RT, "O,N,L,Y" (4 EA)
 STA. 16+88.3 LT, ARROW (1 EA)
 STA. 17+00.4 RT, ARROW (1 EA)
 STA. 17+54.6 RT, "O,N,L,Y" (4 EA)
 STA. 17+67.0 LT, "O,N,L,Y" (4 EA)
 STA. 18+08.8 RT, ARROW (1 EA)
 STA. 18+45.7 LT, ARROW (1 EA)
 STA. 18+62.0 RT, "Y,I,E,L,D" (4 EA)
 STA. 19+27.20 RT DIAMOND RUN MALL PLACE, ARROW (1 EA)
 STA. 19+27.20 RT DIAMOND RUN MALL PLACE, "O,N,L,Y" (4 EA)
 STA. 19+70.0 RT, "Y,I,E,L,D" (4 EA)

646.70 TEMPORARY LETTER OR SYMBOL (PAINT)
 RUTLAND TOWN:
 STA. 15+30.9 LT, ARROW (2 EA)
 STA. 17+00.4 RT, ARROW (2 EA)
 STA. 17+54.6 RT, ARROW (2 EA)
 STA. 18+45.7 LT, ARROW (2 EA)
 STA. 18+62.0 RT, "Y,I,E,L,D" (8 EA)
 STA. 19+27.20 RT, DIAMOND RUN MALL PLACE, ARROW (2 EA)
 STA. 19+70.0 RT, "Y,I,E,L,D" (8 EA)

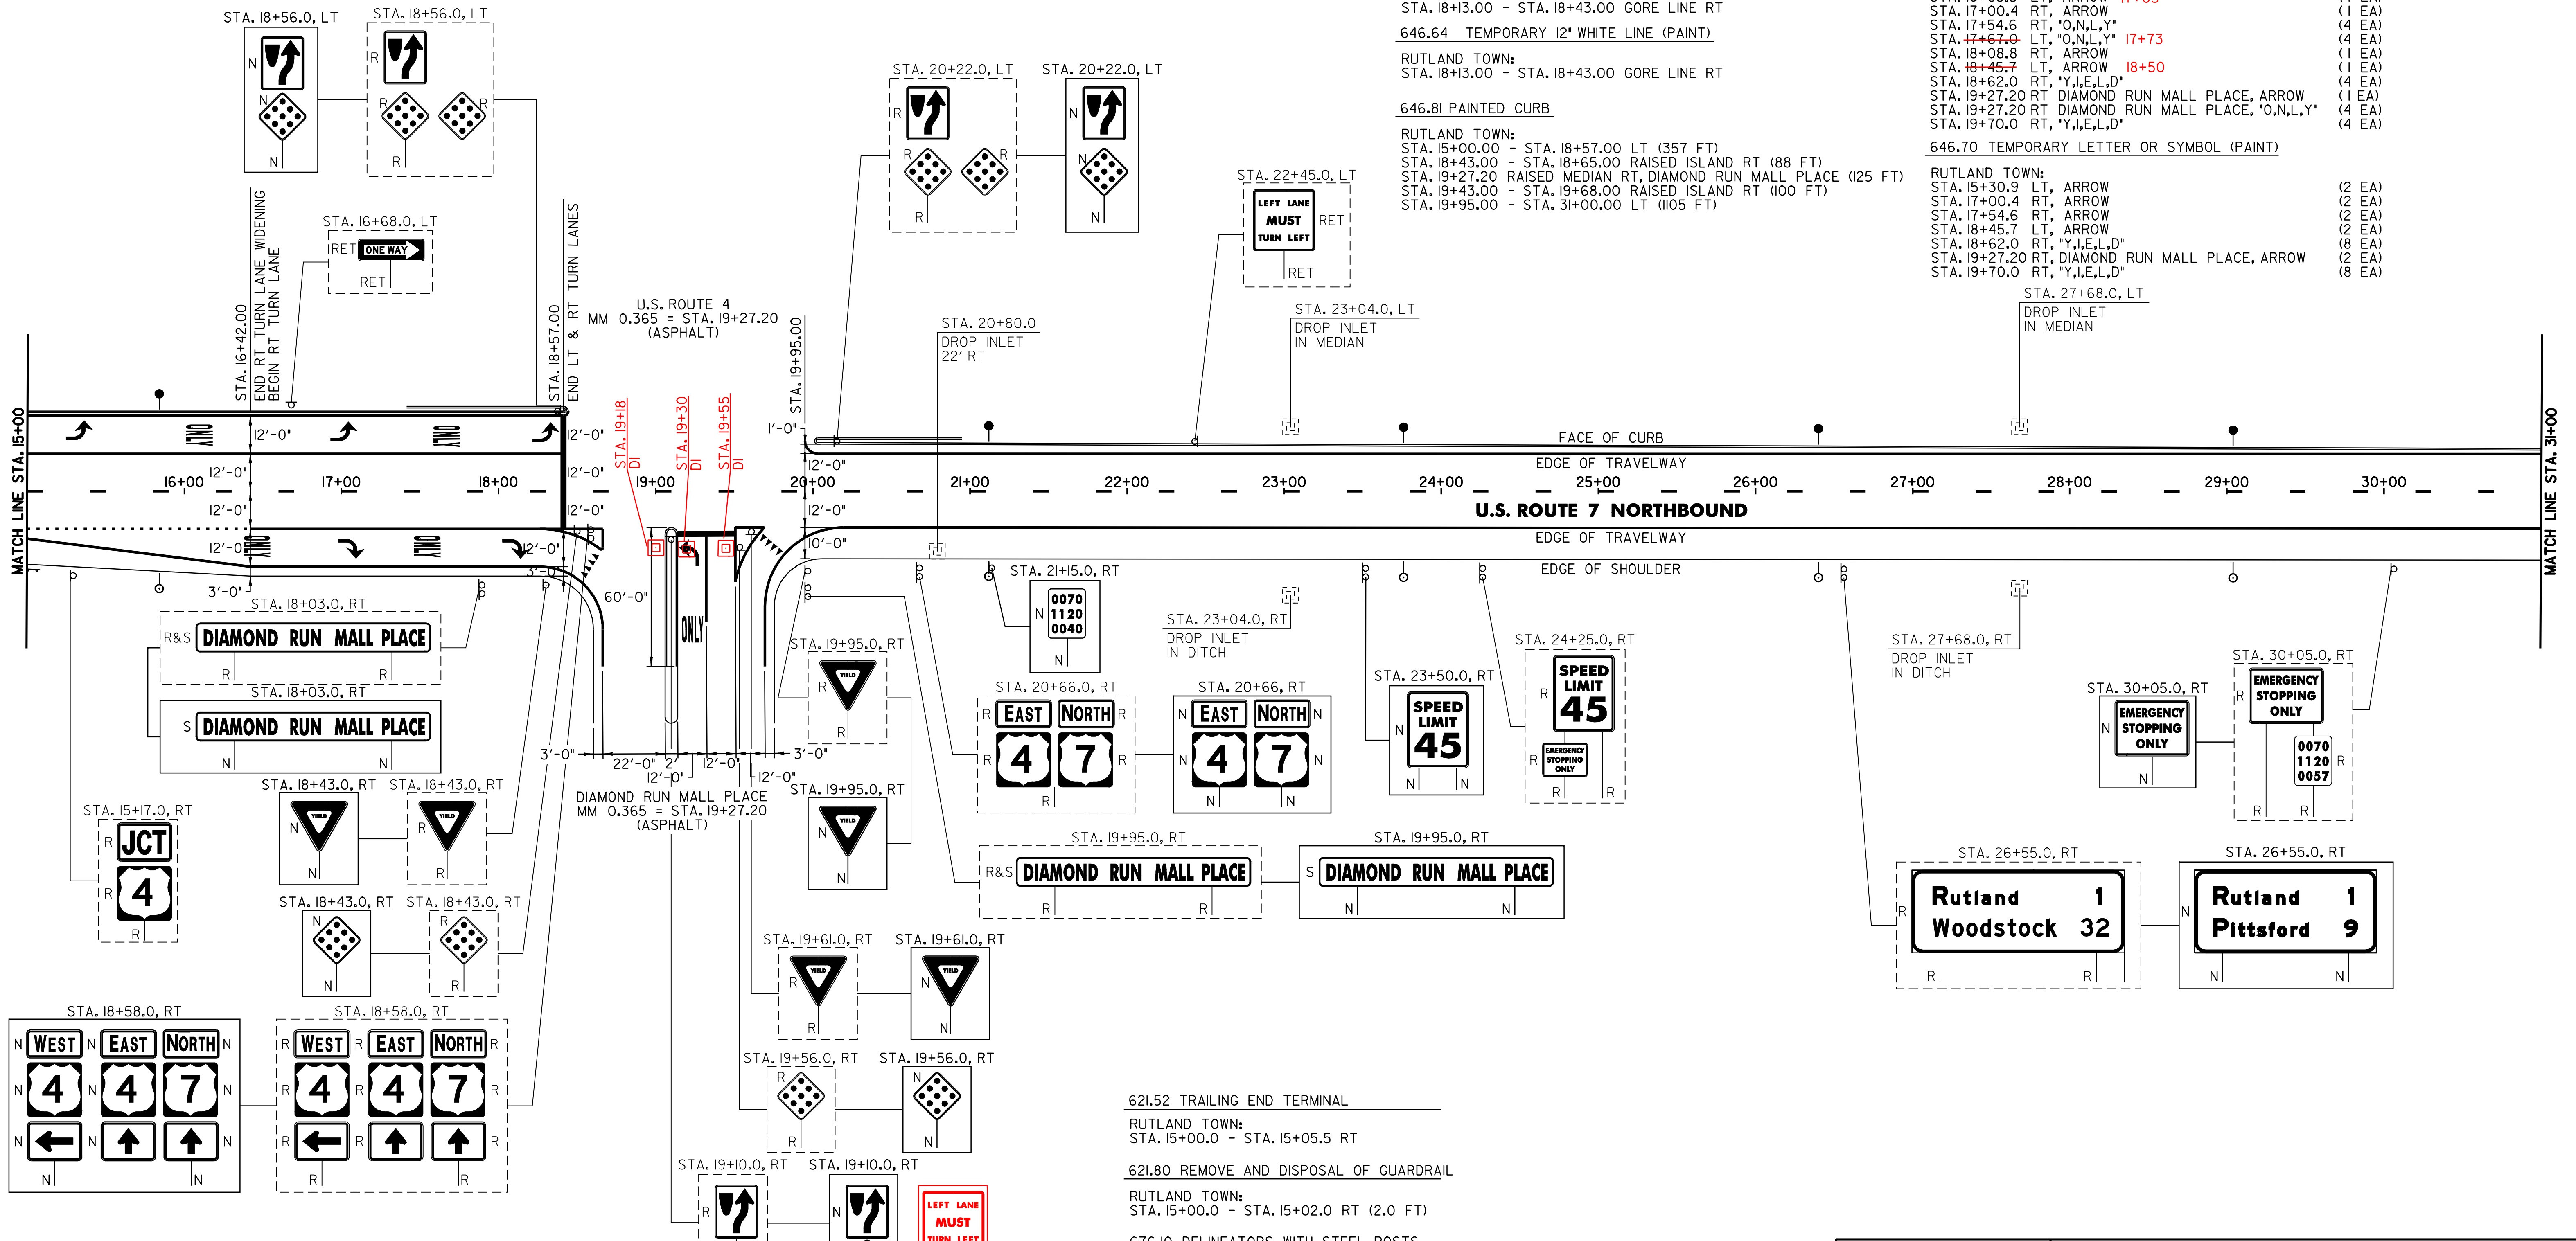

213.10 MILLED RUMBLE STRIPS
 RUTLAND TOWN:
 STA. 20+50 TO STA. 31+00 RT (1050 FT)

604.412 REHABING DI, CB OR MH, CLASS I
 RUTLAND TOWN:
 STA. 20+80.0 RT
 STA. 23+04.0 LT
 STA. 23+04.0 RT
 STA. 27+68.0 RT
 STA. 27+68.0 LT

STA. 19+18 RT
STA. 19+30 RT
STA. 19+55 RT

621.52 TRAILING END TERMINAL
 RUTLAND TOWN:
 STA. 15+00.0 - STA. 15+05.5 RT

621.80 REMOVE AND DISPOSAL OF GUARDRAIL
 RUTLAND TOWN:
 STA. 15+00.0 - STA. 15+02.0 RT (2.0 FT)

676.10 DELINEATORS WITH STEEL POSTS
 ♀ TYPE I WHITE ♂ TYPE I AMBER
 RUTLAND TOWN:
 STA. 15+84.0 RT STA. 15+84.0 LT
 STA. 21+12.0 RT STA. 21+12.0 LT
 STA. 23+76.0 RT STA. 23+76.0 LT
 STA. 26+40.0 RT STA. 26+40.0 LT
 STA. 29+04.0 RT STA. 29+04.0 LT

SIGN LEGEND
 R= REMOVE
 S= SALVAGE
 N= NEW
 RET= RETAIN
 B-B= BACK TO BACK
 EXISTING= _____
 NEW= _____

PROJECT LAYOUT SHEET #24	PROJECT NAME: WALLINGFORD - RUTLAND TOWN	PLOT DATE: 12-MAR-2007 11:30
	PROJECT NUMBER: AC NH 2207(I)S	DRAWN BY: C.A.K.
	FILE NAME: p99b166.dgn	CHECKED BY: D.E.G.
	DESIGNED BY: D.W.E.	SHEET 36 OF 95