

646.414 DURABLE 6" WHITE LINE (MOD.) (RETROREFLECTIVITY/INLAID)
 (ALL LINES WILL INCLUDE EDGE LINE BREAKS AND RADIUS FOR TOWN HIGHWAYS)
 CLARENDON:
 STA. 127+45.00 - STA. 129+85.00 EDGE LINE RT
 STA. 125+50.00 - STA. 131+84.00 EDGE LINE RT

646.415 DURABLE 6" YELLOW LINE (MOD.) (RETROREFLECTIVITY/INLAID)
 (ALL LINES WILL INCLUDE C/L BREAKS FOR TOWN HIGHWAYS) S=SOLID, D=DASHED
 CLARENDON:
 STA. 126+55.00 - STA. 127+45.00 EDGE LINE RT
 STA. 129+85.00 - STA. 130+70.00 EDGE LINE RT


646.44 DURABLE 12" WHITE LINE (MOD.) (RETROREFLECTIVITY/INLAID)
 CLARENDON:
 STA. 125+50.00 - STA. 126+55.00 GORE AREA RT
 STA. 130+70.00 - STA. 131+84.00 GORE AREA RT

646.614 TEMPORARY 6" WHITE LINE (PAINT)
 (ALL LINES WILL INCLUDE EDGE LINE BREAKS AND RADIUS FOR TOWN HIGHWAYS)
 CLARENDON:
 STA. 127+45.00 - STA. 129+85.00 EDGE LINE RT
 STA. 125+50.00 - STA. 131+84.00 EDGE LINE RT

646.615 TEMPORARY 6" YELLOW LINE (PAINT)
 (ALL LINES WILL INCLUDE C/L BREAKS FOR TOWN HIGHWAYS) S=SOLID, D=DASHED
 CLARENDON:
 STA. 126+55.00 - STA. 127+45.00 EDGE LINE RT
 STA. 129+85.00 - STA. 130+70.00 EDGE LINE RT

646.64 TEMPORARY 12" WHITE LINE (PAINT)
 CLARENDON:
 STA. 125+50.00 - STA. 126+55.00 GORE AREA RT
 STA. 130+70.00 - STA. 131+84.00 GORE AREA RT

675.50 REMOVING SIGNS
 AS SHOWN - 14

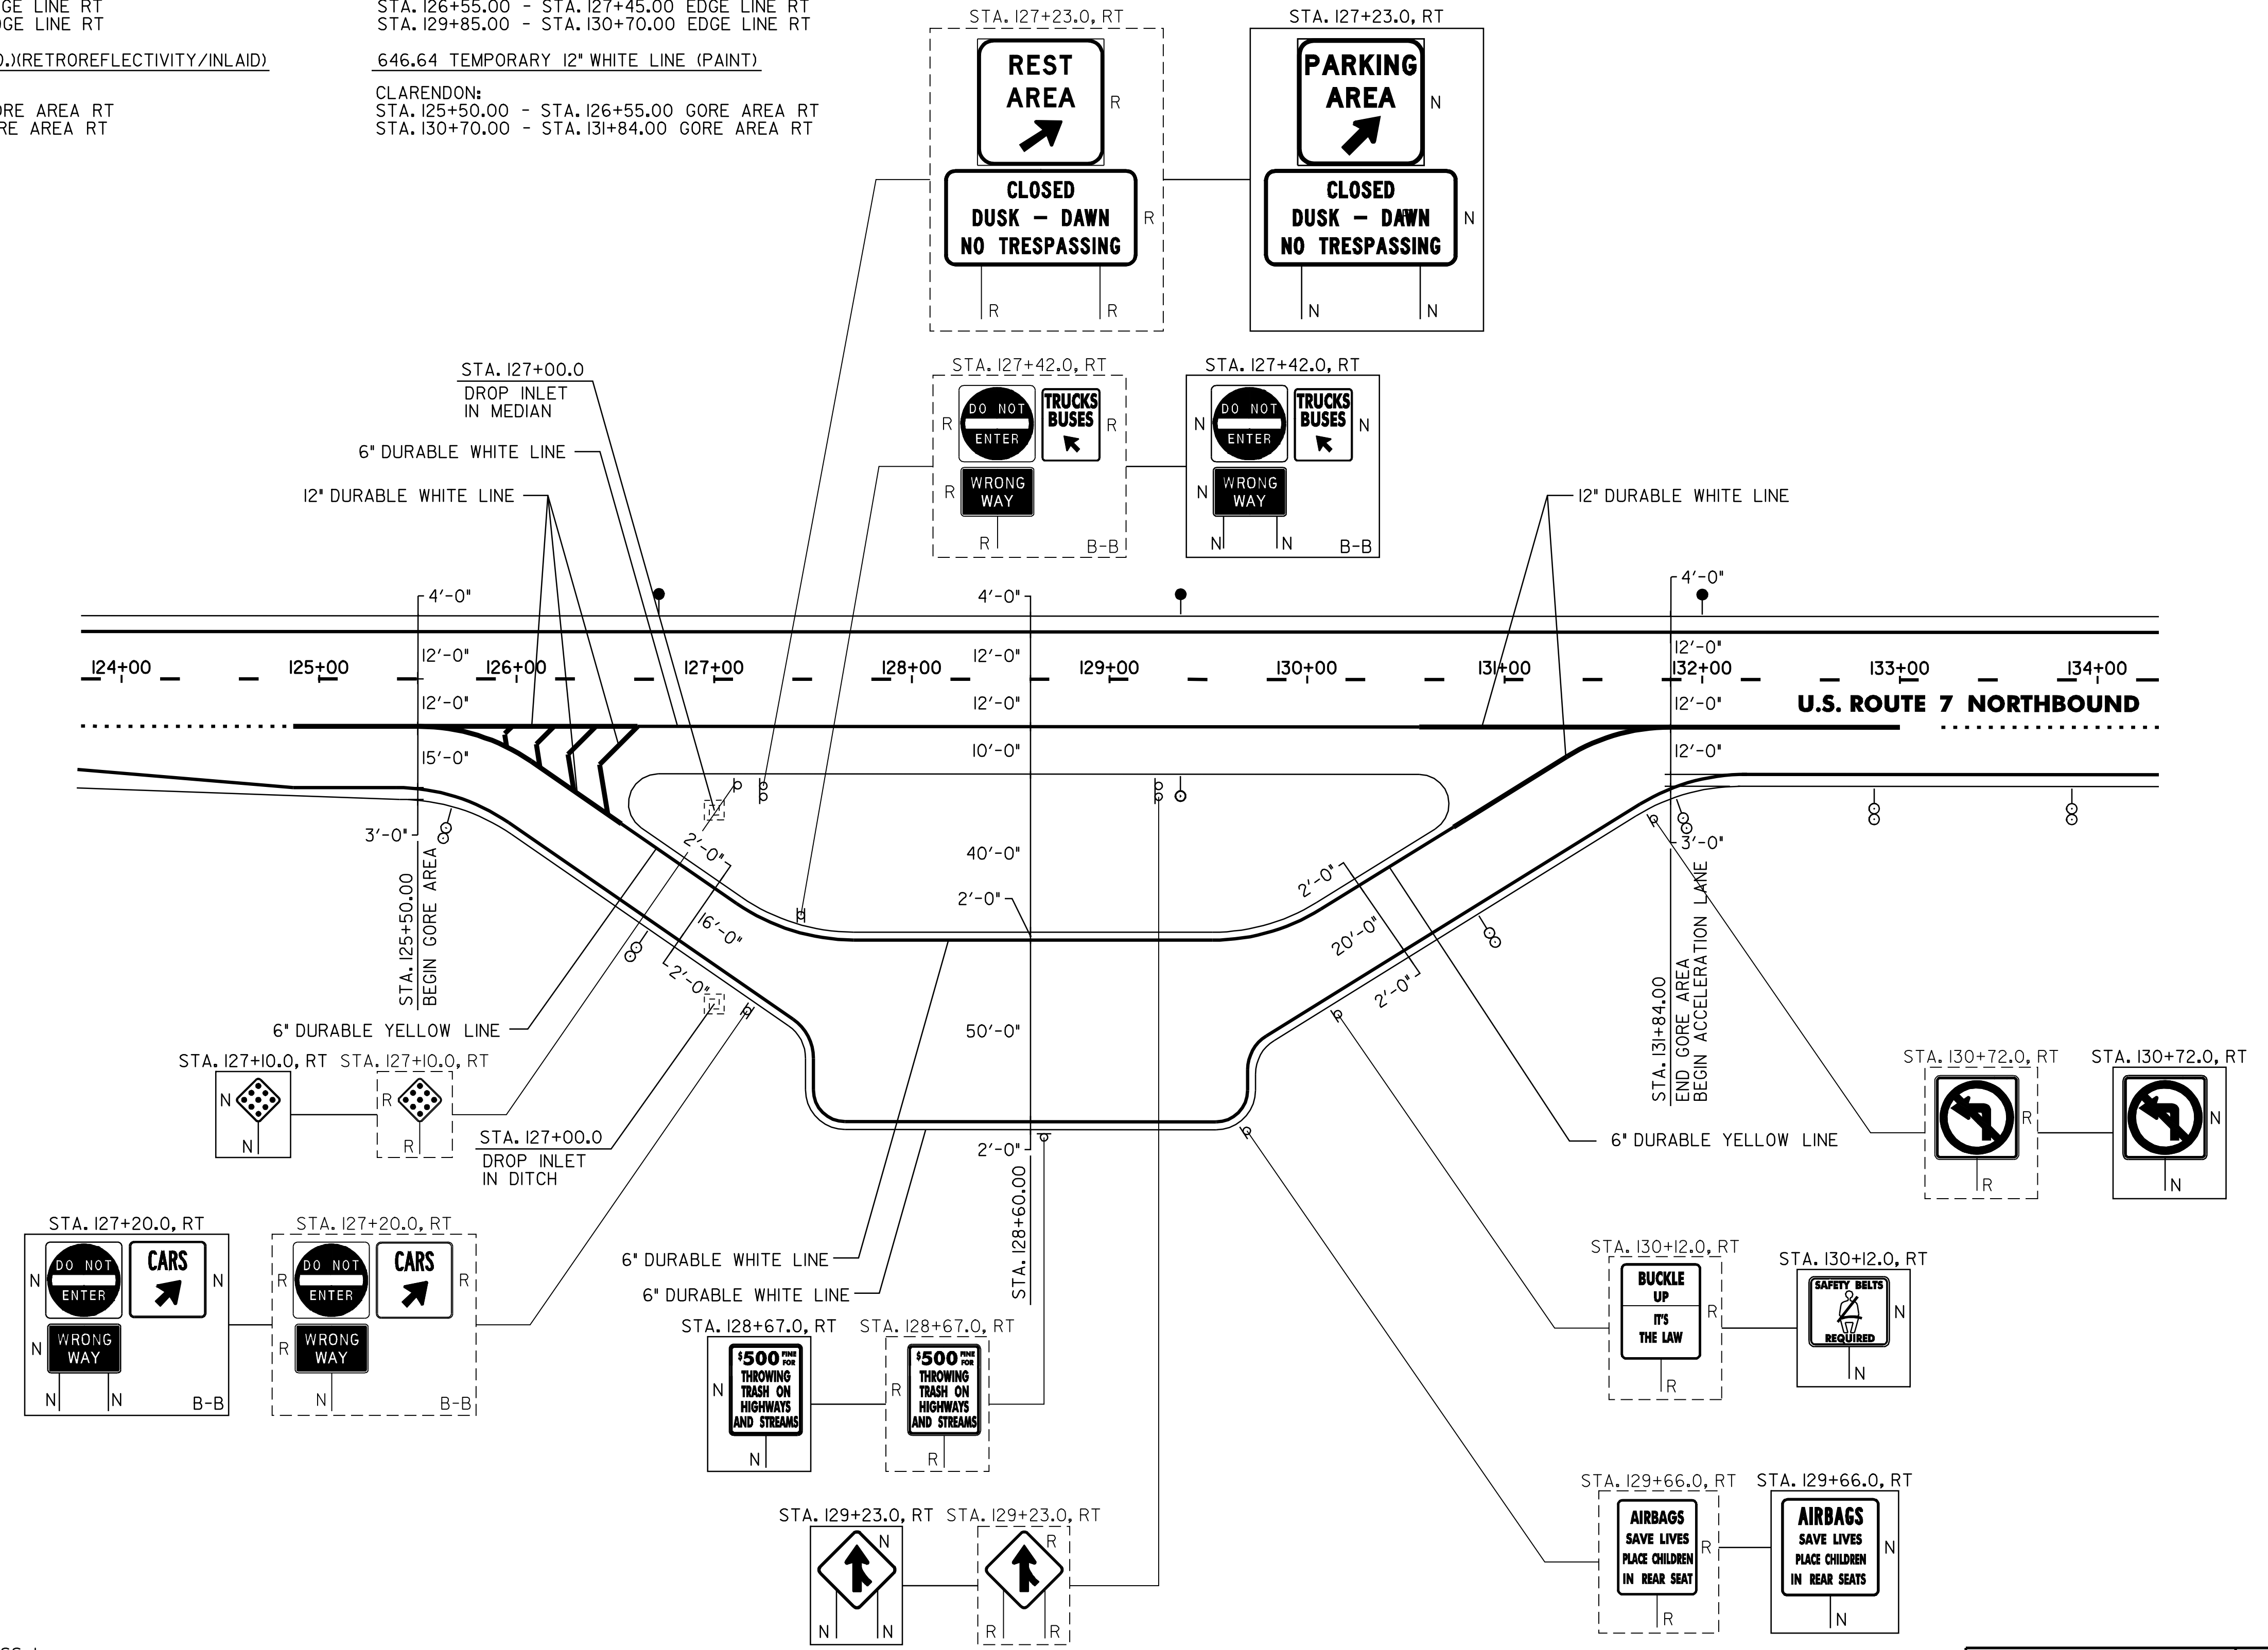

604.412 REHABING DI, CB OR MH CLASS 1
 CLARENDON:
 STA. 127+00.0 RT
 STA. 127+00.0 RT

PARKING AREA DETAIL
 STA. 130+89.12 (MM 2.479)

SIGN LEGEND

- R= REMOVE
- S= SALVAGE
- N= NEW
- RET= RETAIN
- B-B= BACK TO BACK
- EXISTING=
- NEW=

**PARKING AREA
 DETAIL
 SHEET**

PROJECT NAME: WALLINGFORD - RUTLAND TOWN
 PROJECT NUMBER: AC NH 2207(1)S
 FILE NAME: p99bl66.dgn
 PROJECT LEADER: D.E.G.
 DESIGNED BY: D.W.E.
 PLOT DATE: 12-MAR-2007 11:30
 DRAWN BY: C.A.K.
 CHECKED BY: D.W.E.
 SHEET 39 OF 95