





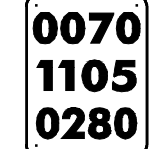



# TRAFFIC SIGN SUMMARY SHEET 13

MILEMARKER, STATION, OR SIGN NUMBER	SIGN LEGEND	SIGN DIMENSIONS		NEW & SALVAGED SIGNS				EXIST POST		NEW SIGN POSTS														REMARKS	SIGN DETAIL											
		E A	WIDTH (In)	HEIGHT (In)	"A"	"B"	SALV SIGN	SALV TIS	RETAIN	SALVAGE	NO. OF POSTS	FLANGED CHANNEL			SQUARE STEEL (In)			TUBULAR ALUMINUM Ø (In)			TUBULAR STEEL Ø (In)				W-SHAPE STEEL			REQUIRE	DETAIL ON DWG. NUMBER	STD. SHEET NUMBER						
												lb/ft	3.0	1.75	2.0	2.5	3.0	4.0	4.0 MOD	FOUND-ATION	3.0	3.5	4.0		5.0	FTG. SIZE					WEIGHT	POST SIZE				
																										1.12	2.0						1.88	2.16	3.35	1.3
OPTION ITEMS ( )																																				
CLARENDON: 129+66.0, RT		I	30	30	6.25					I			X 14.08		X		X													79						
130+12.0, RT		I	30	36	7.50					I			X 14		X		X													79						
130+72.0, RT		I	36	24	9.00					I			X 14			X	X														SIGN ID CODE R3-2	E-143				
131+11.0, LT		I	36	12	3.00					I			X 12.50	X			X														SIGN ID CODE R6-IR	E-142				
137+28.0, RT		I	6	10	0.42					I	X 9			X			X														SIGN ID CODE VD-700	E-138				
139+28.0, RT		I	108	84		63.00				2								238.5 2		275.4											79					
147+84.0, RT		I	6	10	0.42					I	X 9			X			X														SIGN ID CODE VD-700	E-138				
149+50.0, RT		I	102	102		72.25				2								402.3 2			427.6										79					
FINAL POST LENGTHS ARE TO BE DETERMINED IN THE FIELD. POST SIZES ARE COMPUTED BASED ON INFORMATION FURNISHED ON THE STANDARD SHEETS AND THE TRAFFIC OPERATIONS SECTION "SIGN POST DESIGN GUIDELINE."											FT (28.0)	FT (42.0)	FT (42.0)	FT (28.0)	FT (14.0 (-))	EA	LB	LB	LB	LB	LB	LB	LB	EA	EA	LB										
											72.58			604.8																						
<b>TOTALS</b>		SF	SF	EA.	SF						FT (70.0)		FT 14 (70.0)		LB	EA.	4	LB	703.0	EA.	EA.	LB														
		26.59	135.25																													PROJECT NAME: WALLINGFORD - RUTLAND TOWN PROJECT NUMBER: AC NH 2207(I)S FILE NAME: p99bl66.dgn PROJECT LEADER: D.E.G. DESIGNED BY: D.W.E.	PLOT DATE: 12-MAR-2007 11:31 DRAWN BY: M.L.M. CHECKED BY: D.E.G. SHEET 58 OF 95			