




Clarendon 127+23.0 RT
 LEFT POST = 16.5' 16.42'
 RIGHT POST = 16.7' 16.5'
 3" DIAMETER TUBULAR STEEL

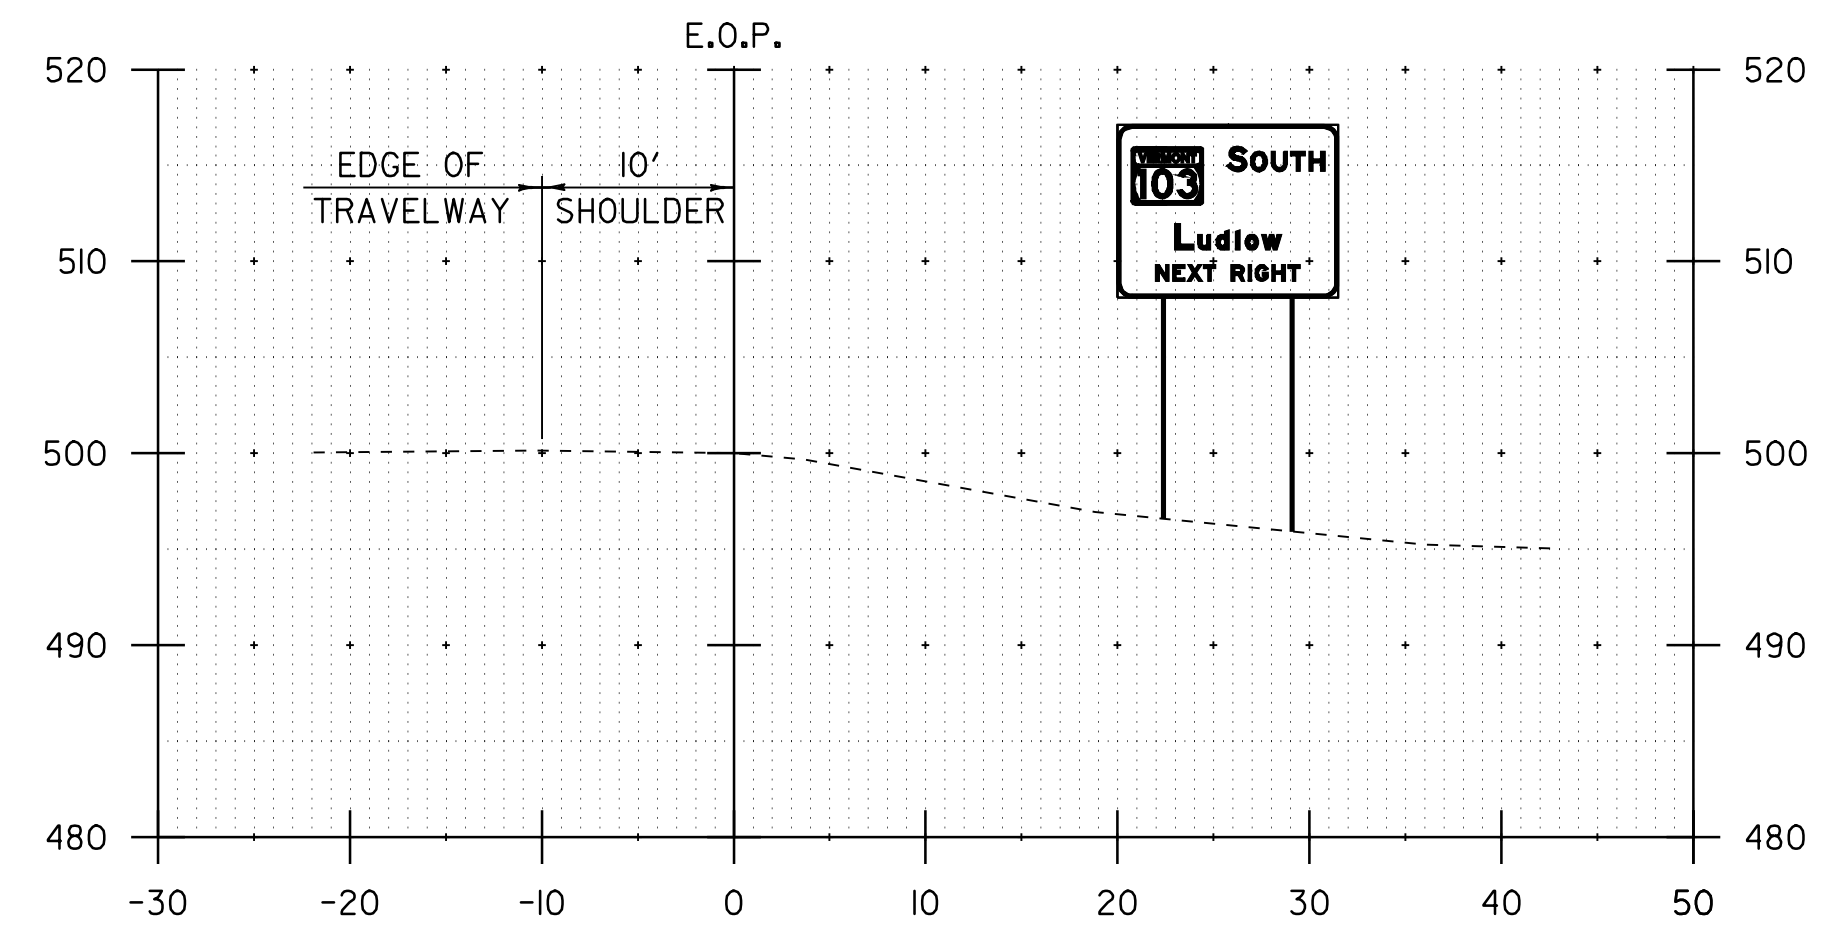


Clarendon 162+10.0 RT
 LEFT POST = 20.5' 20.42'
 RIGHT POST = 21.2' 21.0'
 5" DIAMETER TUBULAR STEEL

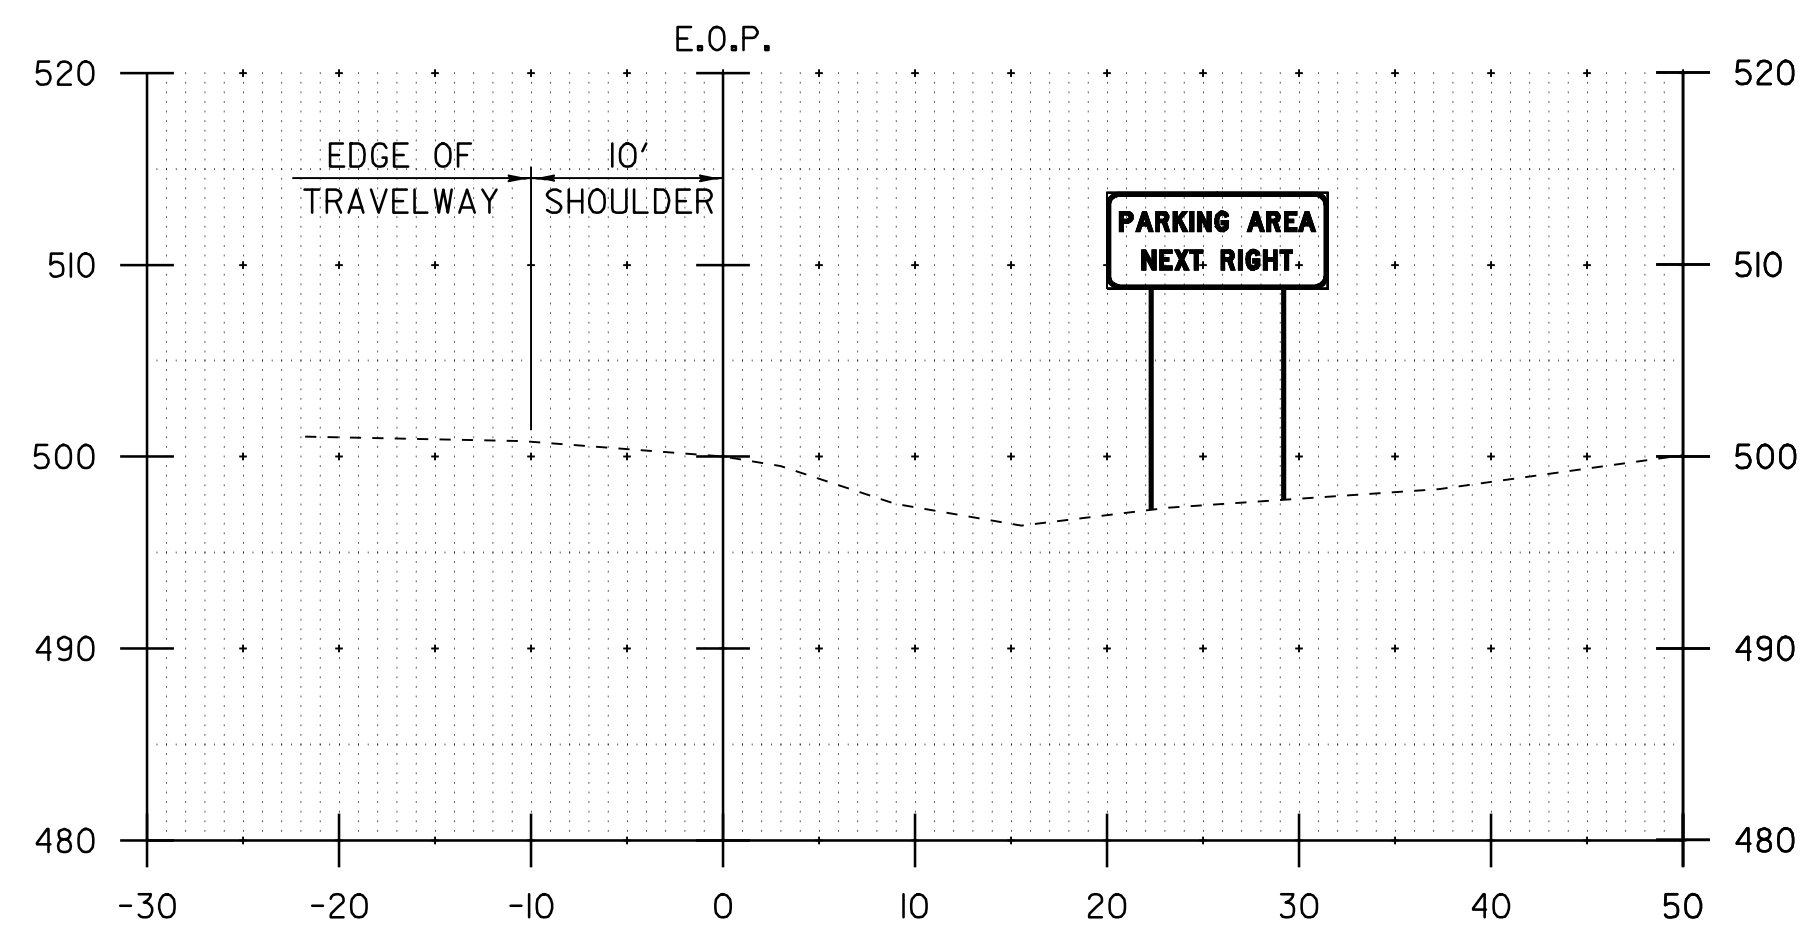


Clarendon 116+16.0 RT
 LEFT POST = 16.5' 17.42'
 RIGHT POST = 16.0' 16.58'
 3 1/2" DIAMETER TUBULAR STEEL

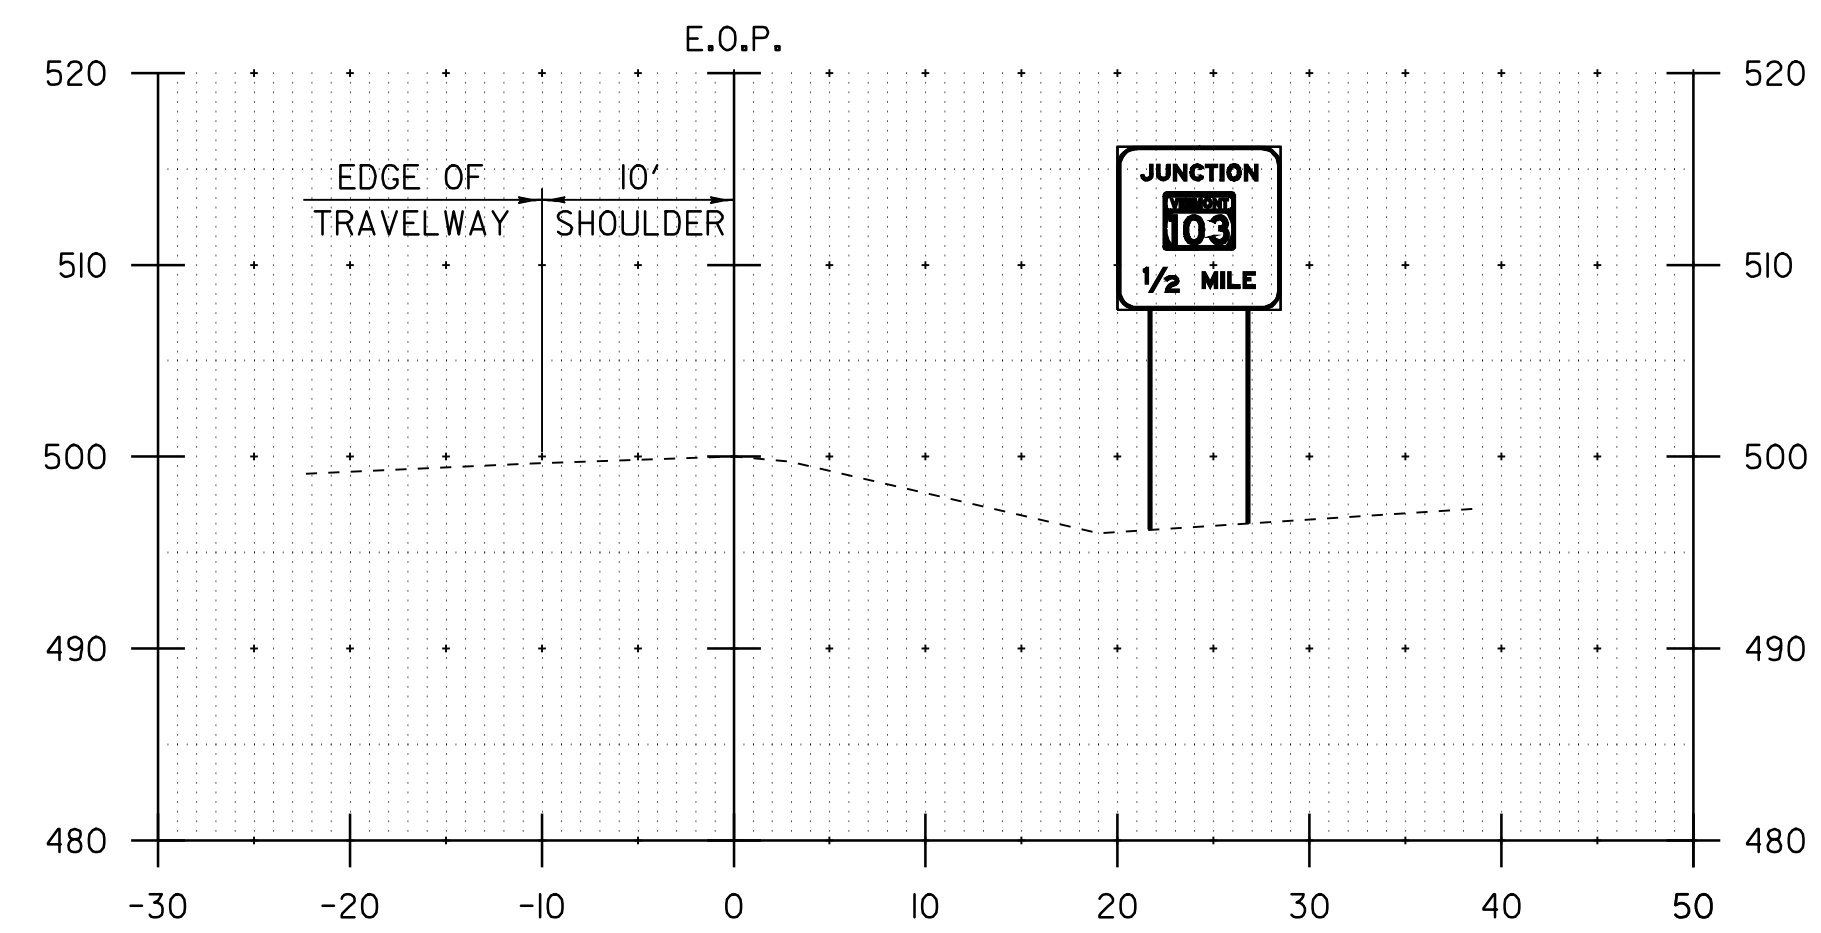


Clarendon 149+50.0 RT
 LEFT POST = 20.0' 18.67'
 RIGHT POST = 19.6' 18.58'
 4" DIAMETER TUBULAR STEEL

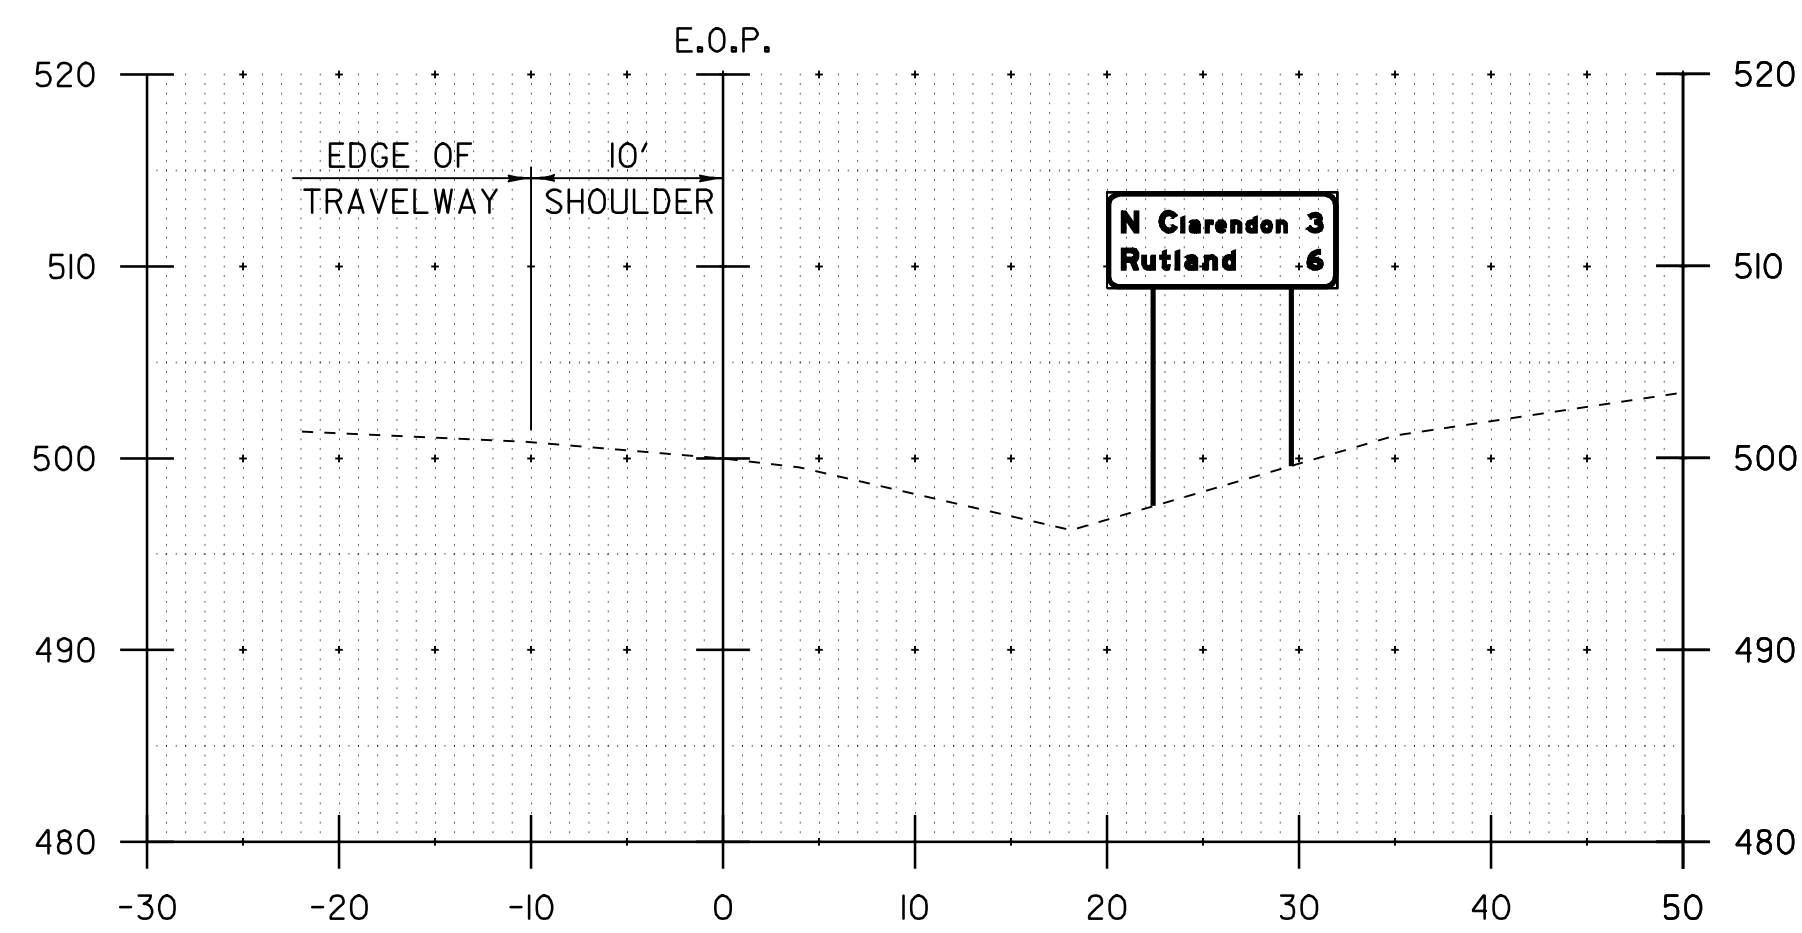

Clarendon 99+28.0 RT
 LEFT POST = 16.3' 13.17'
 RIGHT POST = 14.3' 9.67'
 3 1/2" DIAMETER TUBULAR STEEL

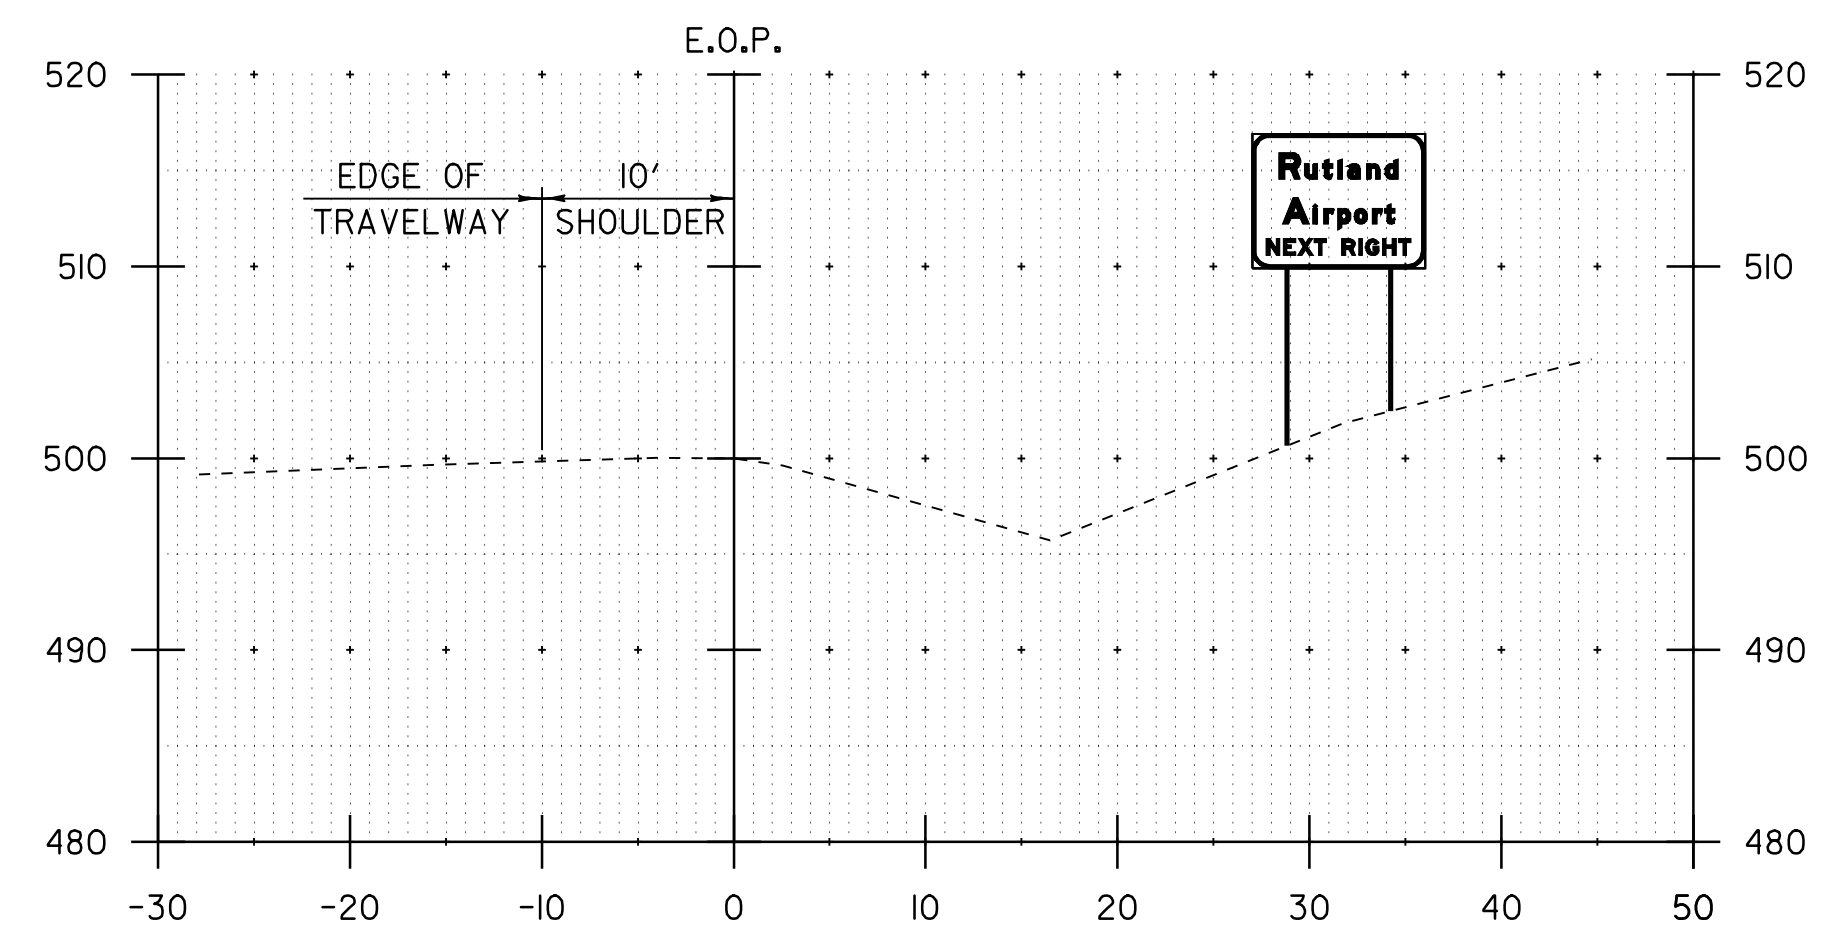

Clarendon 136+00.0 RT
 LEFT POST = 16.2' 14.0'
 RIGHT POST = 14.4' 12.5'
 3 1/2" DIAMETER TUBULAR STEEL

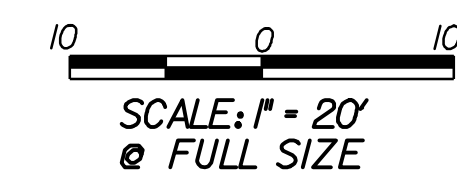

CROSS SECTION SHEET #2

PROJECT NAME: WALLINGFORD - RUTLAND TOWN
 PROJECT NUMBER: AC NH 2207(I)S

FILE NAME: p99b166.dgn
 PROJECT LEADER: D.E.G.
 DESIGNED BY: D.W.E.
 PLOT DATE: 12-MAR-2007 11:34
 DRAWN BY: C.A.K.
 CHECKED BY: D.E.G.
 SHEET 84 OF 95