




Clarendon 263+49.0 RT
 LEFT POST = 22.5' 20.17'
 RIGHT POST = 22.6' 20.75'
 4" DIAMETER TUBULAR STEEL

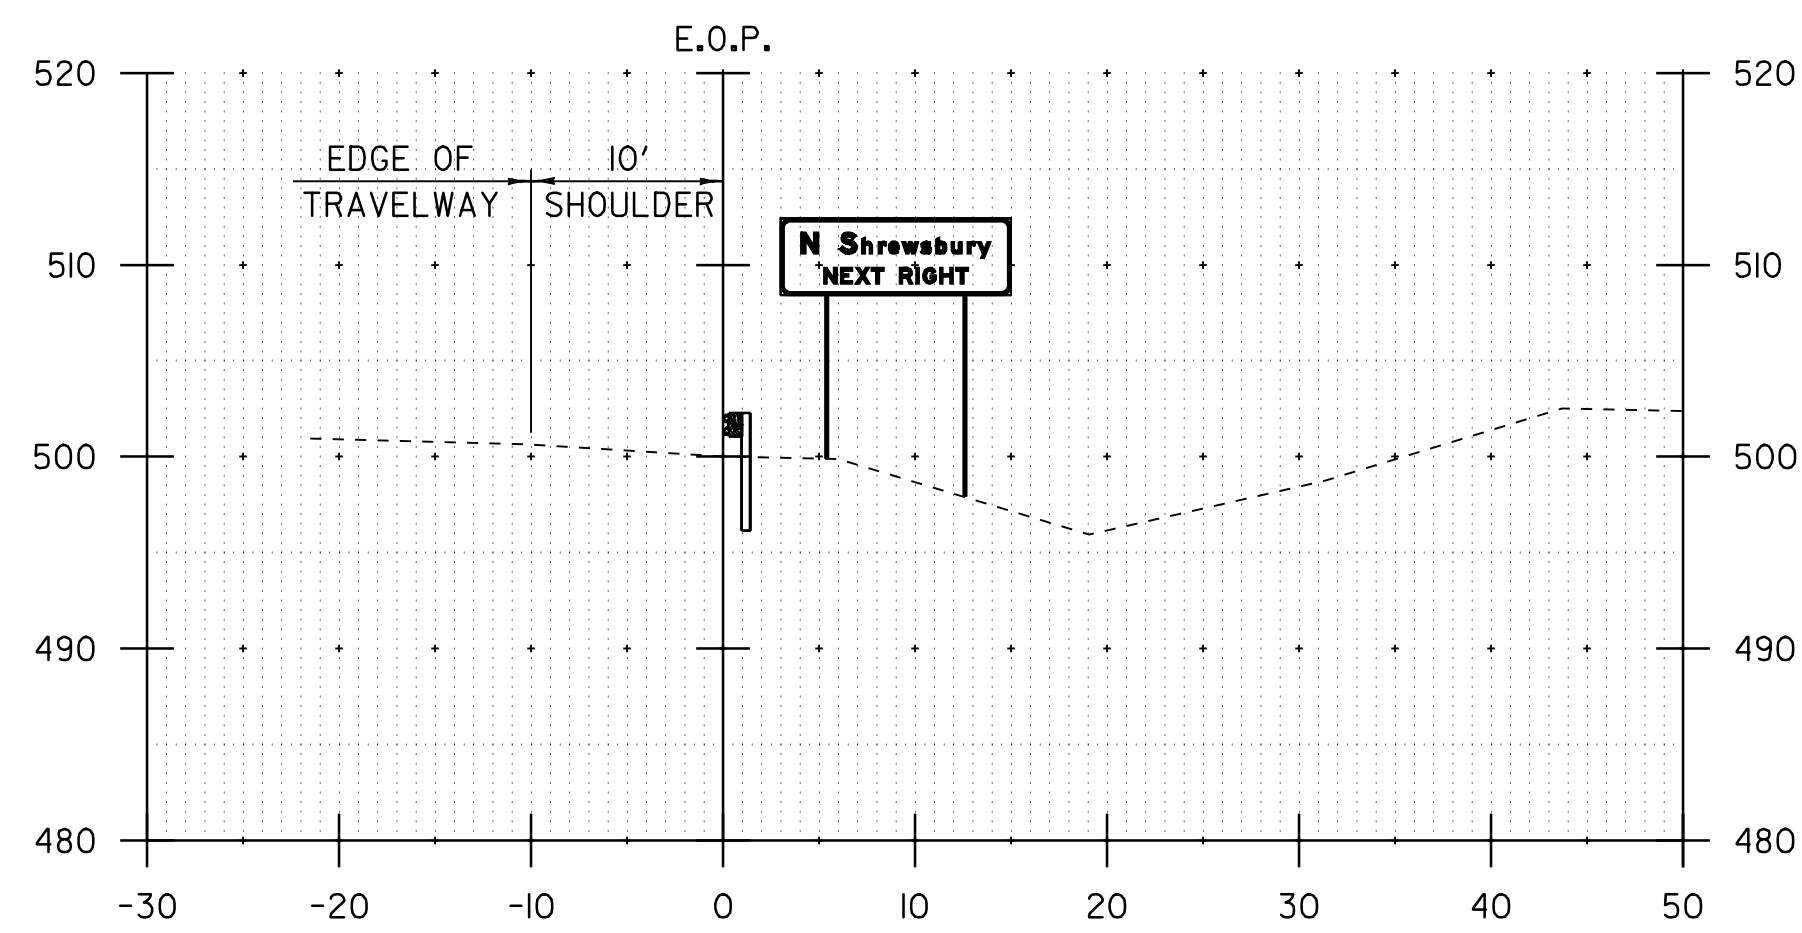


Clarendon 257+22.0 RT
 LEFT POST = 12.5' 12.83'
 RIGHT POST = 14.5' 16.0'
 3" DIAMETER TUBULAR STEEL

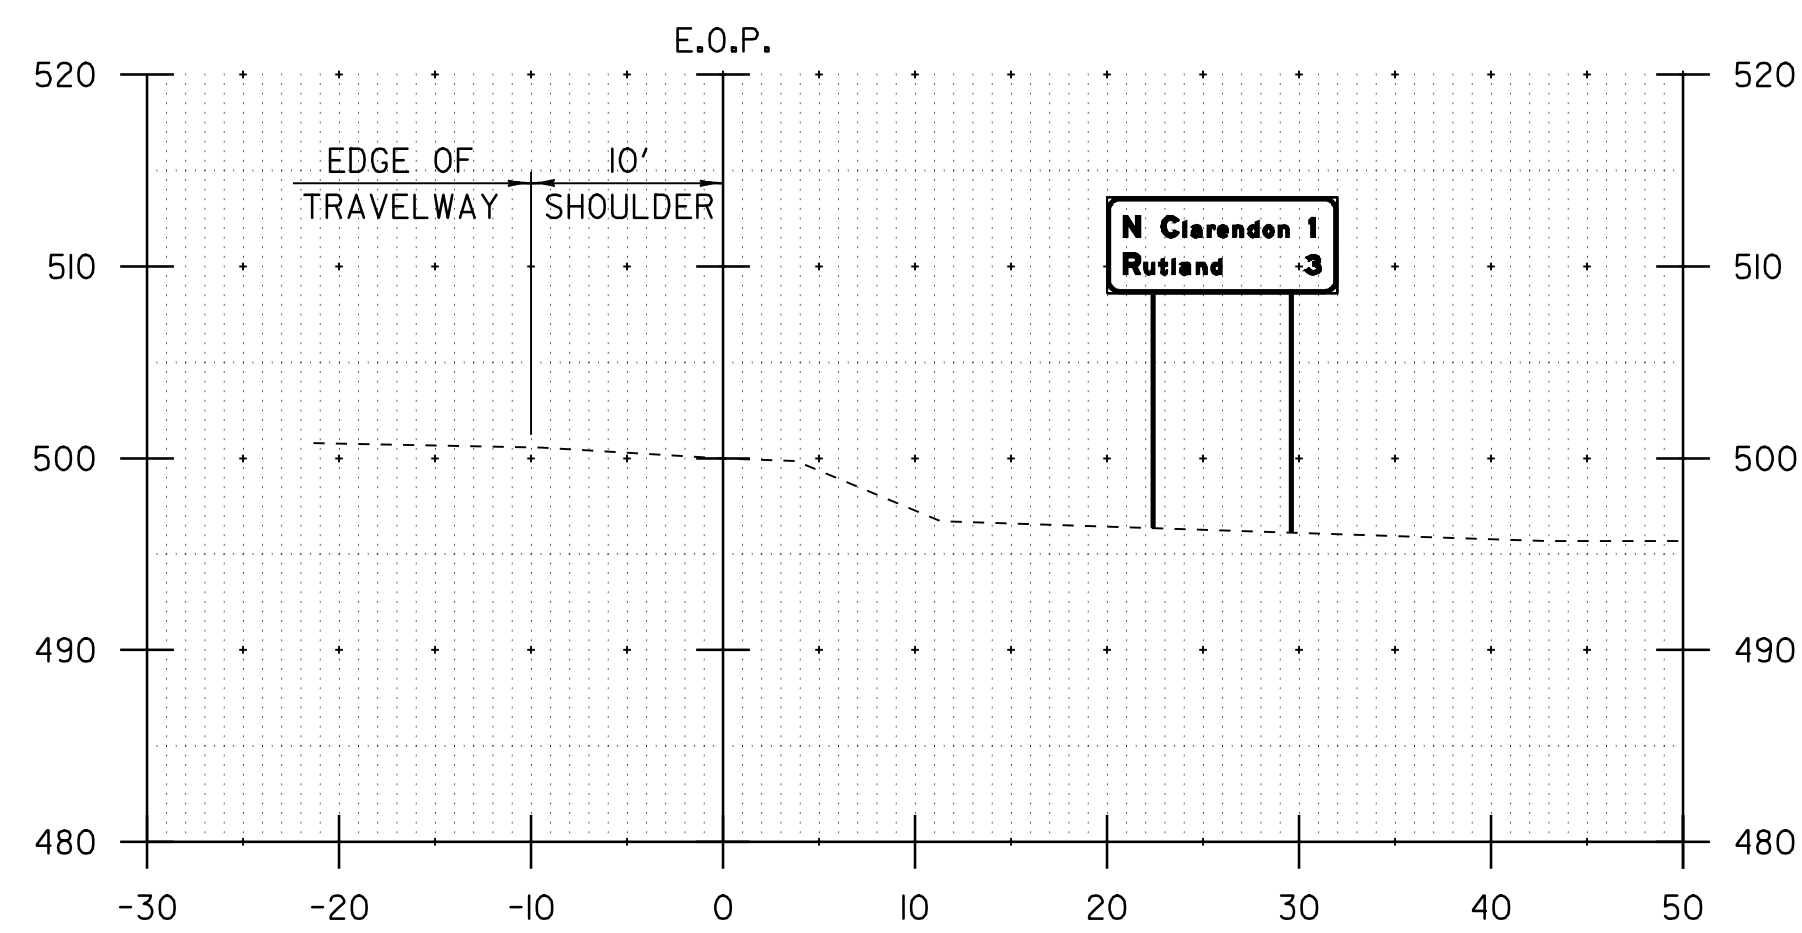


Clarendon 211+60.0 RT
 LEFT POST = 17.2' 15.75'
 RIGHT POST = 17.5' 16.17'
 4" DIAMETER TUBULAR STEEL

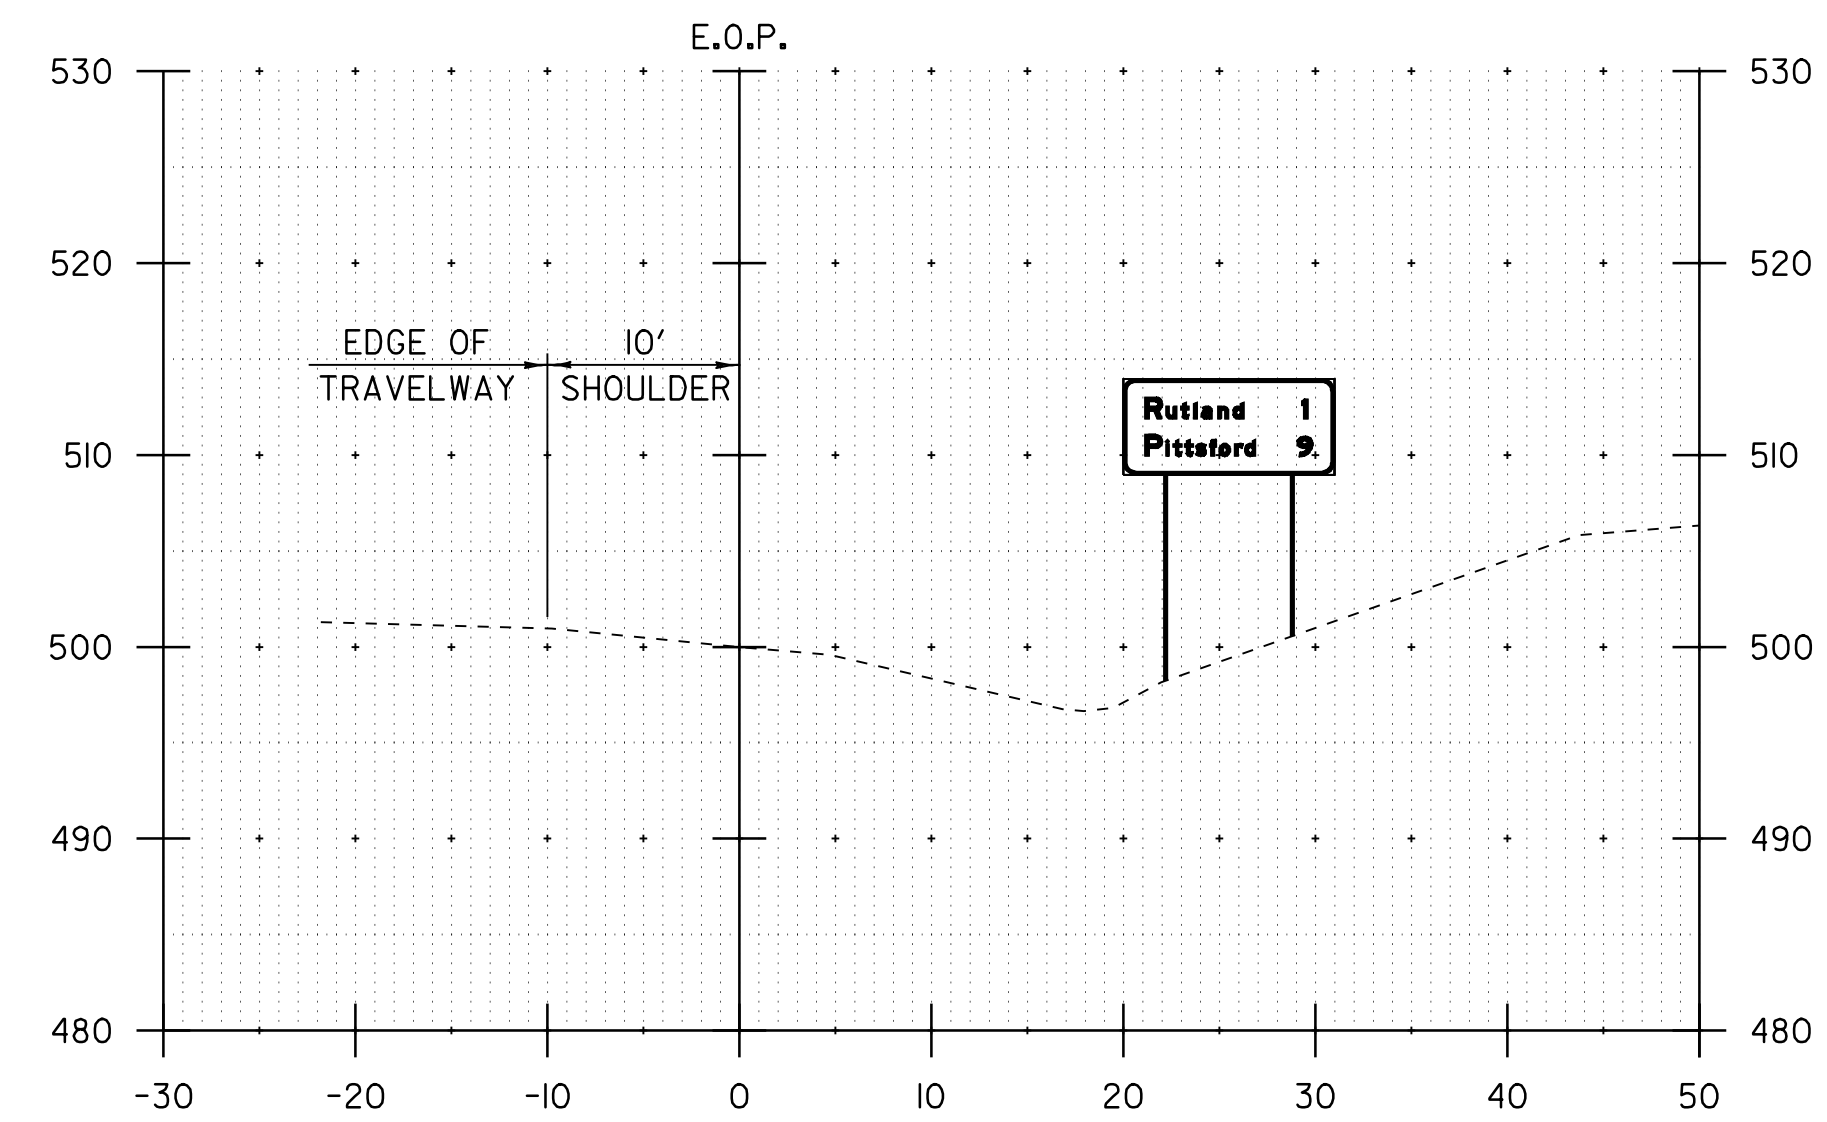

Rutland Town 26+55.0 RT
 LEFT POST = 15.7' 12.0'
 RIGHT POST = 13.4' 9.42'
 3/2" DIAMETER TUBULAR STEEL

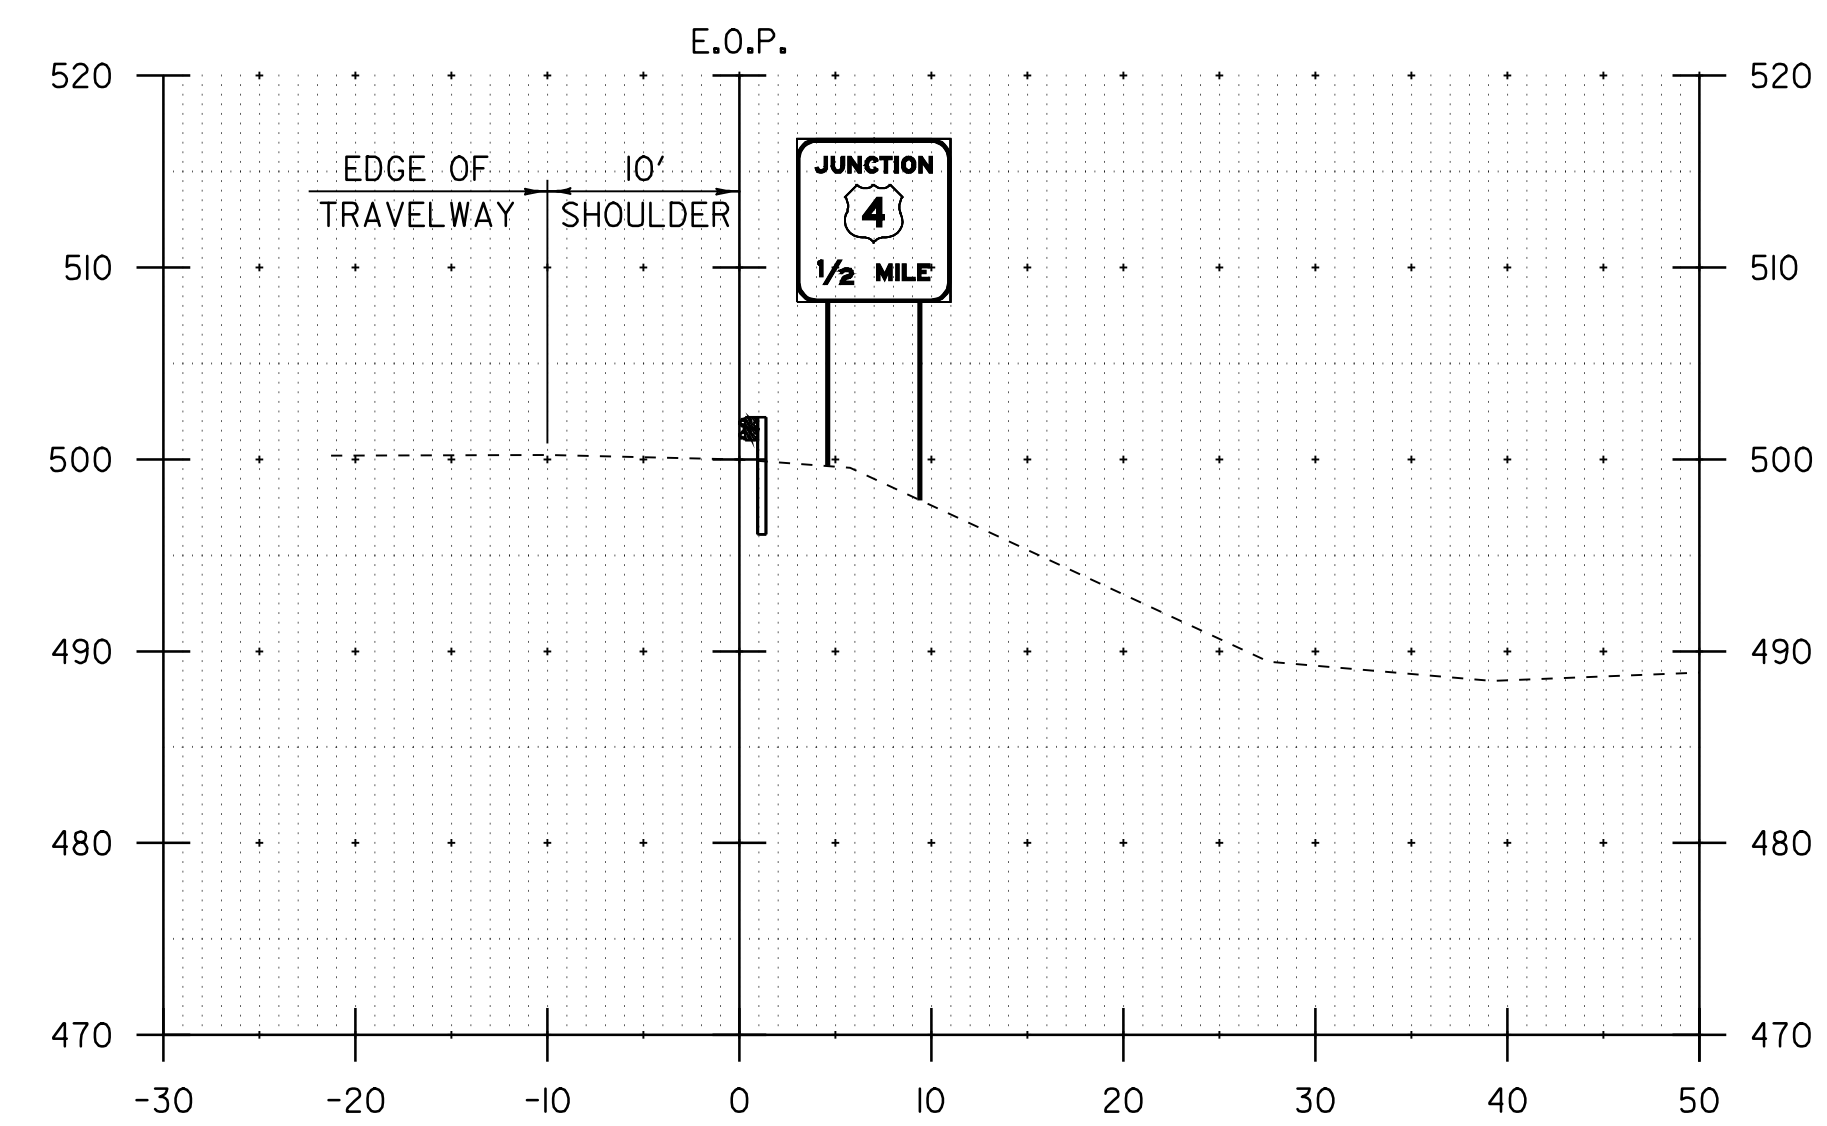

Clarendon 292+25.0 RT
 LEFT POST = 17.0' 15.5'
 RIGHT POST = 18.8' 17.25'
 4" DIAMETER TUBULAR STEEL

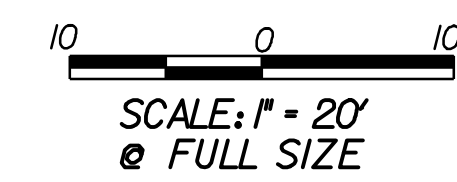

CROSS SECTION SHEET #3	PROJECT NAME: WALLINGFORD - RUTLAND TOWN	PLOT DATE: 12-MAR-2007 11:34
	PROJECT NUMBER: AC NH 2207(I)S	DRAWN BY: C.A.K.
	FILE NAME: p99bl66.dgn	CHECKED BY: D.E.G.
	PROJECT LEADER: D.E.G.	SHEET 85 OF 95
	DESIGNED BY: D.W.E.	