

604.412 REHAB, DROP INLETS,
CATCH BASINS, OR MANHOLES, CLASS I

33 STA. 372+15 RT (TYPE E GRATE)
93 STA. 376+67 RT (TYPE E GRATE)
82 STA. 381+48 RT (TYPE E GRATE)

646.402 DURABLE 4 INCH WHITE LINE, THERMOPLASTIC
STA. 369+50 - STA. 385+25 (SOLID LT & RT)

646.602 TEMPORARY 4 INCH WHITE LINE, PAINT
STA. 369+50 - STA. 385+25 (SOLID LT & RT)

621.50 MANUFACTURED TERMINAL SECTION, FLARED


12.50 STA. 370+02.50 - STA. 370+40.00 LT 50.00
39.00 STA. 370+06.00 - STA. 370+43.50 RT 76.50
39.00 STA. 374+18.50 - STA. 374+56.00 RT 76.50
STA. 376+55.00 - STA. 376+92.50 RT
78.00 STA. 384+17.50 - STA. 384+55.00 RT 385+15.5

646.412 DURABLE 4 INCH YELLOW LINE, THERMOPLASTIC

STA. 369+50 - STA. 373+81 (DASHED LT)
STA. 369+50 - STA. 385+25 (SOLID RT)
STA. 373+81 - STA. 385+25 (SOLID LT)

646.612 TEMPORARY 4 INCH YELLOW LINE, PAINT

STA. 369+50 - STA. 373+81 (DASHED LT)
STA. 369+50 - STA. 385+25 (SOLID RT)
STA. 373+81 - STA. 385+25 (SOLID LT)

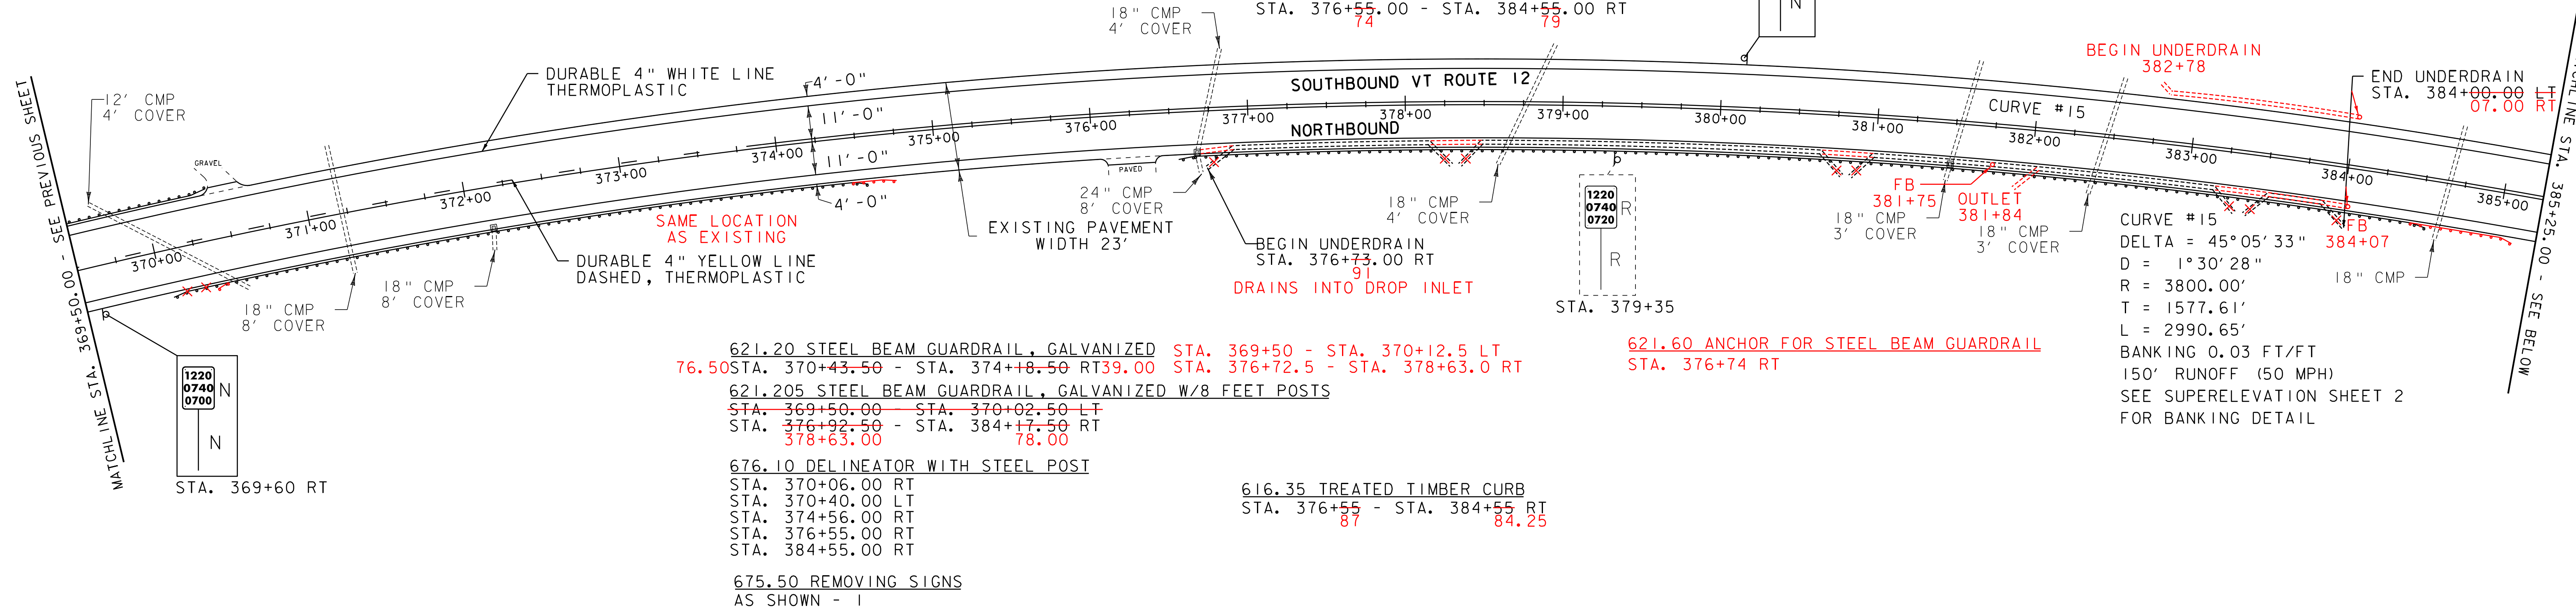

621.20 STEEL BEAM GUARDRAIL, GALVANIZED STA. 369+50 - STA. 370+12.5 LT
76.50 STA. 370+43.50 - STA. 374+18.50 RT 39.00 STA. 376+72.5 - STA. 378+63.0 RT

621.205 STEEL BEAM GUARDRAIL, GALVANIZED W/8 FEET POSTS
STA. 369+50.00 - STA. 370+02.50 LT
STA. 376+92.50 - STA. 384+17.50 RT
378+63.00 78.00

676.10 DELINEATOR WITH STEEL POST
STA. 370+06.00 RT
STA. 370+40.00 LT
STA. 374+56.00 RT
STA. 376+55.00 RT
STA. 384+55.00 RT

675.50 REMOVING SIGNS
AS SHOWN - 1

616.35 TREATED TIMBER CURB
STA. 376+55 - STA. 384+55 RT
87 84.25

621.60 ANCHOR FOR STEEL BEAM GUARDRAIL
STA. 376+74 RT

646.402 DURABLE 4 INCH WHITE LINE, THERMOPLASTIC
STA. 385+25 - STA. 399+75 (SOLID LT & RT)

646.602 TEMPORARY 4 INCH WHITE LINE, PAINT
STA. 385+25 - STA. 399+75 (SOLID LT & RT)

621.20 STEEL BEAM GUARDRAIL, GALVANIZED
STA. 398+03.50 - STA. 399+75.00 RT
396+07.00

621.205 STEEL BEAM GUARDRAIL, GALVANIZED W/8 FEET POSTS
STA. 396+03.50 - STA. 398+03.50 RT


621.50 MANUFACTURED TERMINAL SECTION, FLARED
STA. 395+66.00 - STA. 396+03.50 RT
69.50 07.00

621.80 REMOVAL AND DISPOSAL OF GUARDRAIL
STA. 395+66.00 - STA. 399+75.00 RT

646.412 DURABLE 4 INCH YELLOW LINE, THERMOPLASTIC
STA. 385+25 - STA. 399+75 (SOLID LT)
STA. 385+25 - STA. 395+10 (SOLID RT)
STA. 395+10 - STA. 399+75 (DASHED RT)

646.612 TEMPORARY 4 INCH YELLOW LINE, PAINT
STA. 385+25 - STA. 399+75 (SOLID LT)
STA. 385+25 - STA. 395+10 (SOLID RT) 394+58
STA. 395+10 - STA. 399+75 (DASHED RT)
394+58

676.10 DELINEATOR WITH STEEL POST
STA. 395+66.00 RT

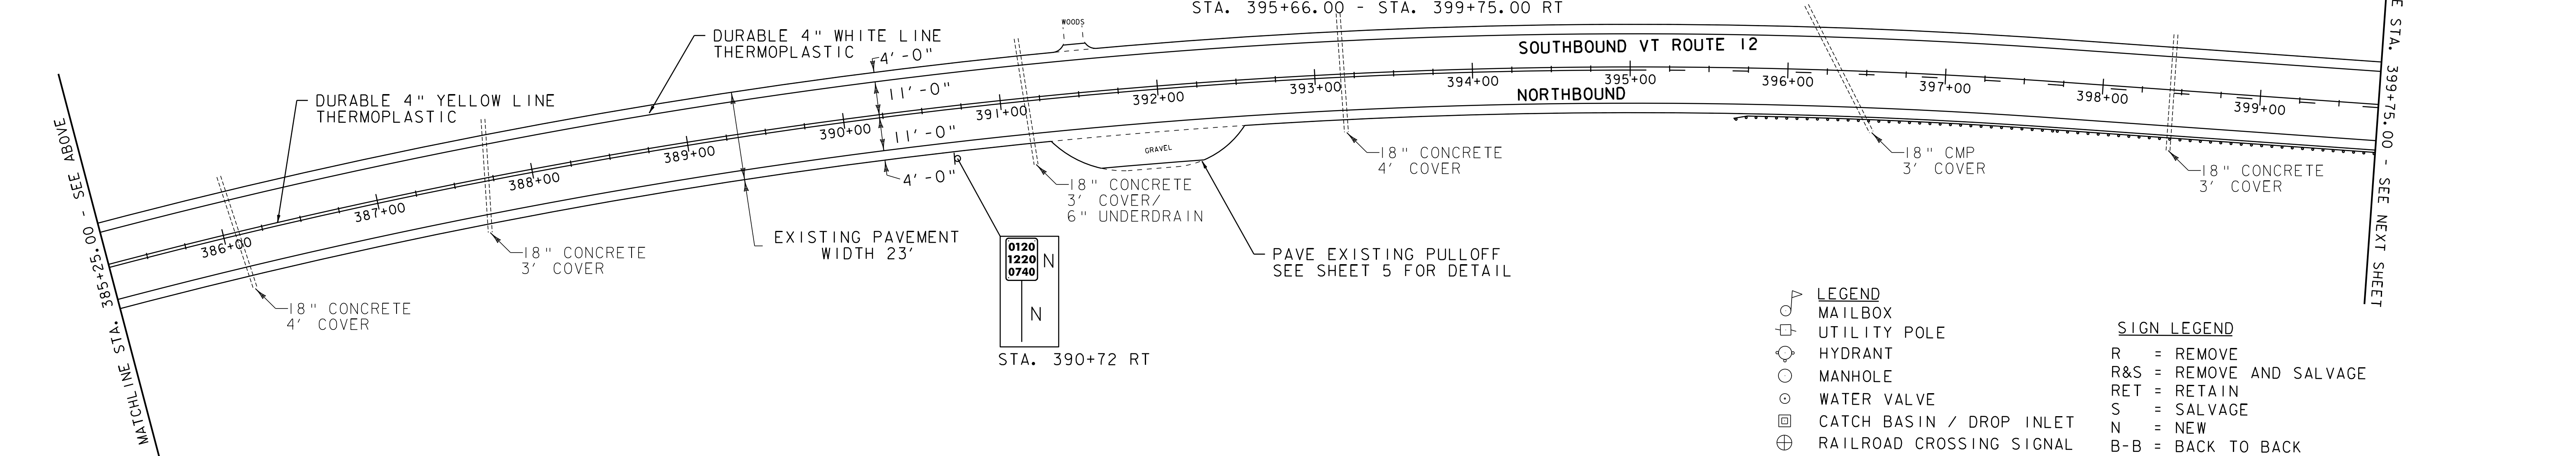

0120
1220
0740
N
N
STA. 390+72 RT

- | | | | |
|---|--------------------------|--|--|
| ○ | LEGEND | | |
| □ | MAILBOX | | |
| □ | UTILITY POLE | | |
| ○ | HYDRANT | | |
| ○ | MANHOLE | | |
| ○ | WATER VALVE | | |
| □ | CATCH BASIN / DROP INLET | | |
| ⊕ | RAILROAD CROSSING SIGNAL | | |
| | SIGN LEGEND | | |
| | R = REMOVE | | |
| | R&S = REMOVE AND SALVAGE | | |
| | RET = RETAIN | | |
| | S = SALVAGE | | |
| | N = NEW | | |
| | B-B = BACK TO BACK | | |

PROJECT LAYOUT SHEET 6

PROJECT NAME: WORCESTER-ELMORE
PROJECT NUMBER: STP 2209(I)S

FILE NAME: 99cl70.dgn	PLOT DATE: 23-SEP-2011 15:24
PROJECT LEADER: CDL	DRAWN BY: SJL
DESIGNED BY: SJL	CHECKED BY: EPD
PLOT FILE: 99cl70_21.i	SHEET 21 OF 36

NOT TO SCALE