



**BITUMINOUS CONCRETE
GUTTER DETAIL**

WATERVILLE
 STA ~~19+90 TO 21+90 RT~~ ~~19+50 - 21+75 RT~~ 172+00 - 173+43 LT
 STA ~~25+90 TO 31+60 RT~~ 25+75 - 28+00 RT
 STA ~~31+90 TO 34+00 LT~~
 STA 32+00 TO 33+20 RT
 STA ~~39+20 TO 40+75 RT~~
 STA 34+46 RT
 BELVIDERE
 STA 112+05 TO 112+50 LT
 STA 142+46 LT

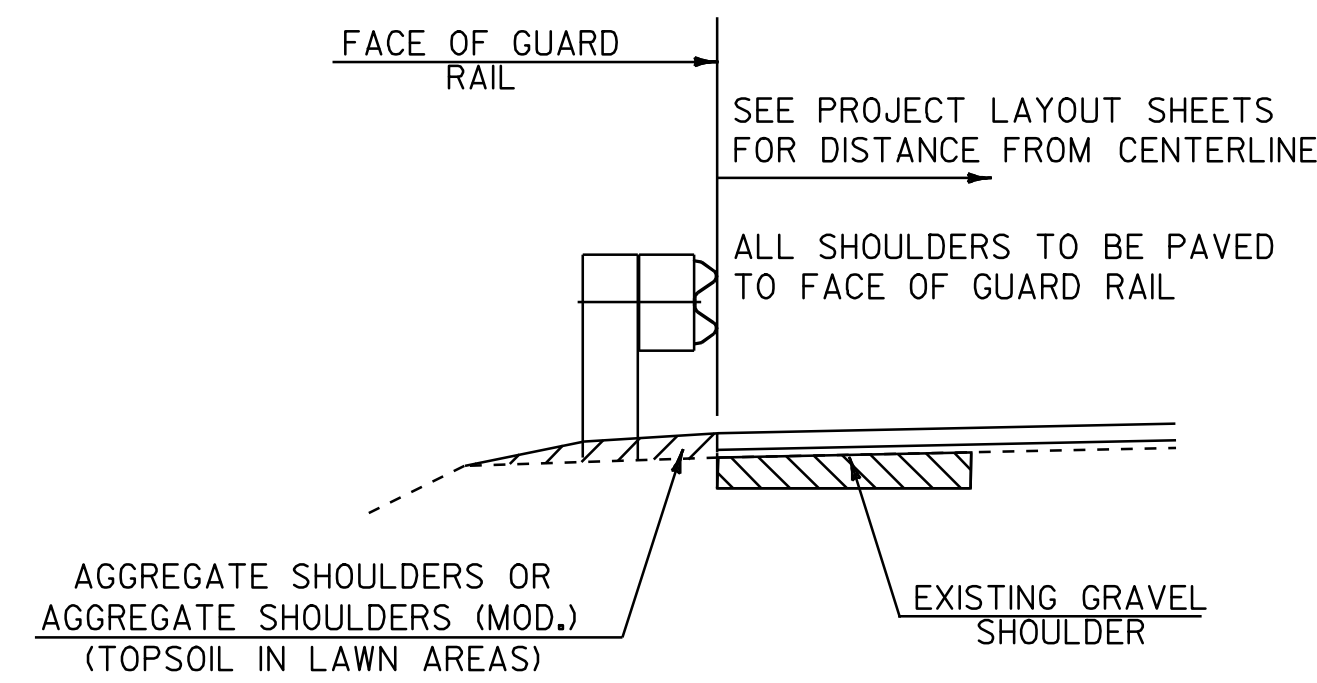

- TYPICAL SECTION AT GUARD RAIL -
(@ EXISTING GRAVEL SHOULDER)

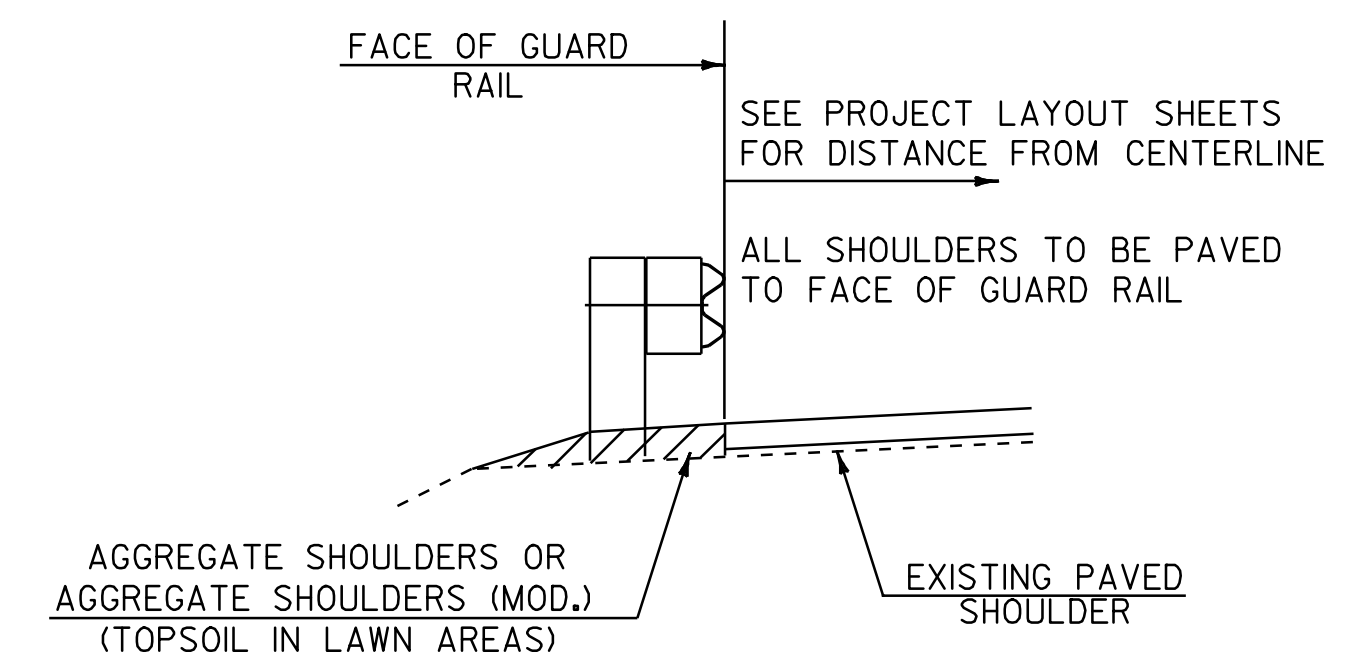

- TYPICAL SECTION AT GUARD RAIL -
(@ EXISTING PAVED SHOULDER)

CONSERVATION SEED MIX
RURAL AREA - SEED MIXTURE

% WT.	lbs./ACRE	NAME	PUR%	GERM%
37.5	22.5	CREeping RED FESCUE	98	85
37.5	22.5	TALL FESCUE	95	90
5.0	3	RED TOP	95	90
15.0	9	BIRDSFOOT TREFOIL	98	85
5.0	3	ANNUAL RYEGRASS	95	85
100.0	60			

SEED MIXTURE:
 SHALL NOT HAVE A WEED CONTENT EXCEEDING 0.40% BY WEIGHT AND SHALL BE FREE OF ALL NOXIOUS SEED.

SEED:
 TO BE APPLIED PER SEEDING FORMULAS OR AS DIRECTED BY THE ENGINEER.

FERTILIZER:
 FORMULA 10-20-10, TO BE USED WITH SEED, APPLIED AT THE RATE OF 500 lbs/ACRE. (HYDRO SEEDERS MAY USE 19-19-19 FORMULA)

AGRICULTURAL LIMESTONE:
 TO BE APPLIED AT THE RATE OF 2.0 TONS/ACRE, OR AS DIRECTED BY THE ENGINEER.

HAY MULCH:
 TO BE PLACED ON EARTH SLOPES AT THE RATE OF 2.0 TONS/ACRE, OR AS DIRECTED BY THE ENGINEER.

TOPSOIL:
 TO BE USED AS INDICATED ON THE PLANS, OR AS DIRECTED BY THE ENGINEER.

PROJECT TYPICAL SHEET #3	DESIGNED BY	BCE/PJM	DATE	8-05
	DRAWN BY	C.E.A., INC.	DATE	8-05
	DESIGN FILE NO.	p99cl90.dgn		
	PRF FILE	p99cl90+yp3.t	DATE PLOTTED	12-DEC-2008 09
	PROJ. NAME	CAMBRIDGE - BELVIDERE		
PROJ. NO.	STP 2219(1)S			
SHEET	4	OF	37	SHEETS