

TEMPORARY AND DURABLE 4 in YELLOW LINE
 STA 72+00 TO 74+31 SOLID LT & DASHED RT
 STA 74+31 TO 80+78 SOLID LT & DASHED RT
 STA 80+78 TO 81+84 SOLID LT & DASHED RT
 STA 81+84 TO 87+75 DASHED LT & SOLID RT
 STA 87+75 TO 94+40 SOLID LT & DASHED RT
 STA 94+40 TO 95+40 DASHED
 STA 95+40 TO 102+00 DASHED LT & SOLID RT

TEMPORARY AND DURABLE 4 in WHITE LINE
 STA 72+00 TO 102+00 SOLID LT&RT
 REHABILITATION OF C.B.'S, D.I.'S, OR M.H.'S
 STA 99+50 RT


REMOVAL AND DISPOSAL OF GUARD RAIL
 STA 71+72 TO 73+38 RT
 STA 72+00 TO 73+69 LT
 STA 75+95 TO 79+94 RT
 STA 76+44 TO 80+42 LT
 STA 85+31 TO 90+43 LT

MANUFACTURED TERMINAL SECTION (FLARED)
 STA 71+72 TO 72+09 RT
 STA 73+00 TO 73+38 RT
 STA 73+32 TO 73+69 LT
 STA 75+95 TO 76+32 RT
 STA 76+44 TO 76+81 LT
 STA 79+57 TO 79+94 RT
 STA 80+06 TO 80+43 LT
 STA 85+31 TO 85+68 LT
 STA 90+06 TO 90+43 LT

STEEL BEAM GUARD RAIL (GALVANIZED)
 STA 72+09 TO 73+00 RT
 STA 72+00 TO 73+32 LT
 STA 76+32 TO 79+57 RT
 STA 76+81 TO 80+06 LT
 STA 85+68 TO 90+06 LT

STA 76+44 TO 76+81 LT
 INSTALL MANUFACTURED TERMINAL SECTION (FLARED)
 STA 76+44 TO 80+42 LT
 REMOVAL AND DISPOSAL OF GUARD RAIL
 STA 76+81 TO 80+06 LT
 INSTALL STEEL BEAM GUARD RAIL (GALVANIZED)
 STA 80+06 TO 80+43 LT
 INSTALL MANUFACTURED TERMINAL SECTION (FLARED)

STA 85+31 TO 85+68 LT
 INSTALL MANUFACTURED TERMINAL SECTION (FLARED)
 STA 85+31 TO 90+43 LT
 REMOVAL AND DISPOSAL OF GUARD RAIL

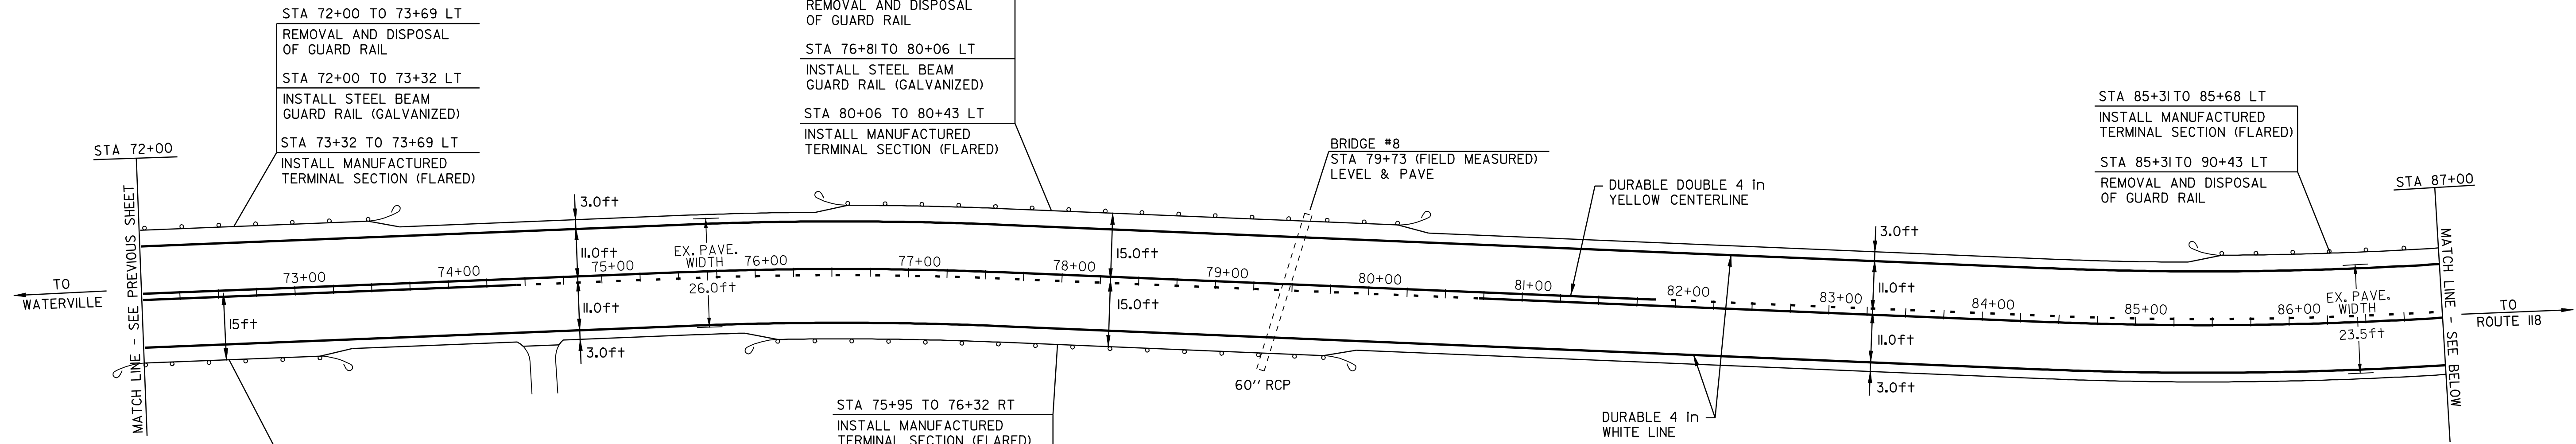


STA 71+72 TO 72+09 RT
 INSTALL MANUFACTURED TERMINAL SECTION (FLARED)
 STA 71+72 TO 73+38 RT
 REMOVAL AND DISPOSAL OF GUARD RAIL
 STA 72+09 TO 73+00 RT
 INSTALL STEEL BEAM GUARD RAIL (GALVANIZED)
 STA 73+00 TO 73+38 RT
 INSTALL MANUFACTURED TERMINAL SECTION (FLARED)

STA 75+95 TO 76+32 RT
 INSTALL MANUFACTURED TERMINAL SECTION (FLARED)
 STA 75+95 TO 79+94 RT
 REMOVAL AND DISPOSAL OF GUARD RAIL
 STA 76+32 TO 79+57 RT
 INSTALL STEEL BEAM GUARD RAIL (GALVANIZED)
 STA 79+57 TO 79+94 RT
 INSTALL MANUFACTURED TERMINAL SECTION (FLARED)

DITCHING LOCATIONS

- 80+15 ~ 80+82 RT
- 81+12 ~ 82+04 RT
- 89+18 ~ 89+46 RT
- 92+66 ~ 93+19 RT
- 99+31 ~ 99+80 RT
- 101+70 ~ 102+68 RT

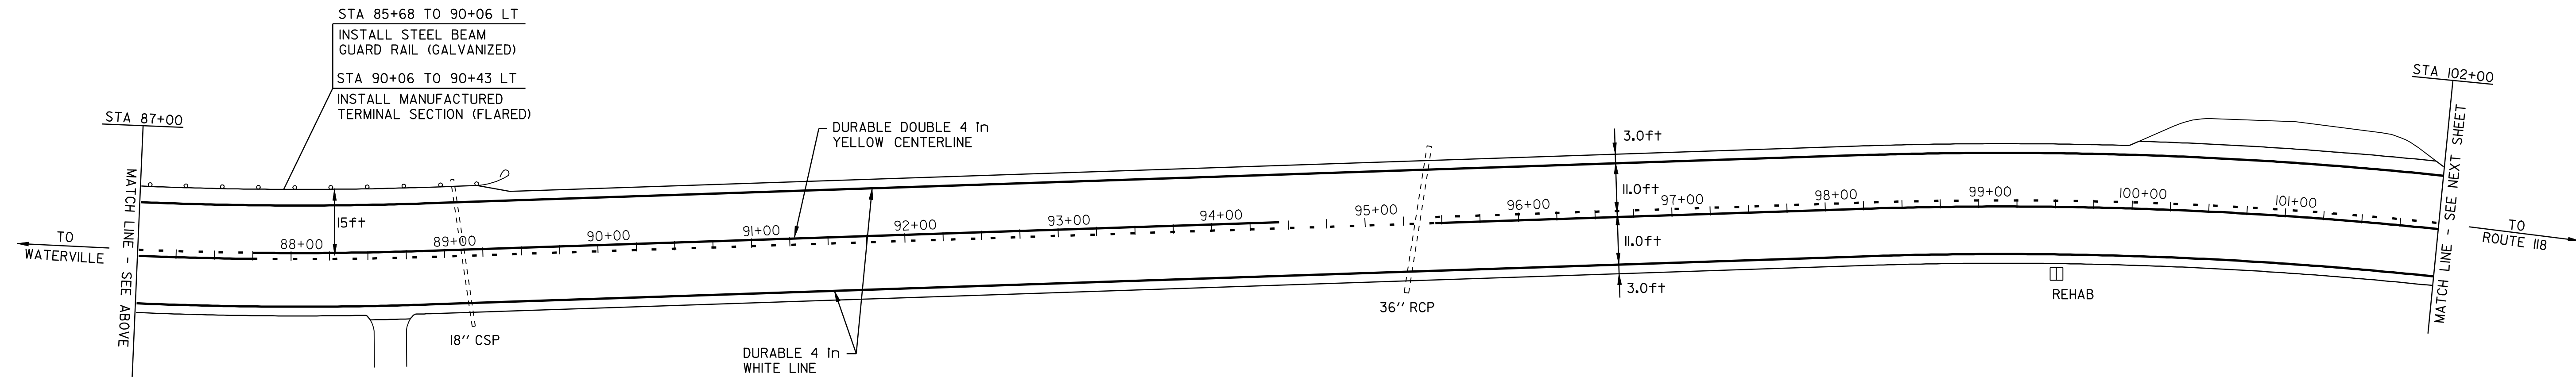

STA 85+68 TO 90+06 LT
 INSTALL STEEL BEAM GUARD RAIL (GALVANIZED)
 STA 90+06 TO 90+43 LT
 INSTALL MANUFACTURED TERMINAL SECTION (FLARED)

LEGEND

N	=	NEW
R	=	REMOVE
R&S	=	REMOVE & SALVAGE
S	=	SALVAGE
RET	=	RETAIN
B-TO-B	=	BACK TO BACK
⊕ ⊞ □	=	CATCH BASIN/DI
⊕ □	=	EXISTING THROAT DI
I	=	MARKER POST
⊗	=	UTILITY POLE
⊗/I	=	UTIL. POLE W/UNDERGROUND UTIL.
⌌	=	DRIVE

PAVING PROJECT LAYOUT SHEET #18

DESIGNED BY	BCE/PJM	DATE	8-05
DRAWN BY	C.E.A., INC.	DATE	8-05
DESIGN FILE NO.	p99ci90.dgn		
PRF FILE	p99ci90i8.1	DATE PLOTTED	12-DEC-2008 09
PROJ. NAME	CAMBRIDGE - BELVIDERE		
PROJ. NO.	STP 2219(1)S		
SHEET	27	OF	37 SHEETS