




| | |
|-------------------------|---|
| STA 131+90 LT | INSTALL ANCHOR FOR GUARD RAIL |
| STA 131+90 TO 132+40 LT | REMOVAL AND DISPOSAL OF GUARD RAIL |
| STA 131+90 TO 132+15 LT | INSTALL STEEL BEAM GUARD RAIL (GALVANIZED) |
| STA 132+15 TO 132+40 LT | INSTALL H.D. STEEL BEAM GUARD RAIL (GALVANIZED) |
| STA 132+40 TO 132+90 LT | REMOVAL OF EXISTING RAILING |
| STA 132+40 TO 132+90 LT | INSTALL ANCHOR FOR GUARD RAIL |

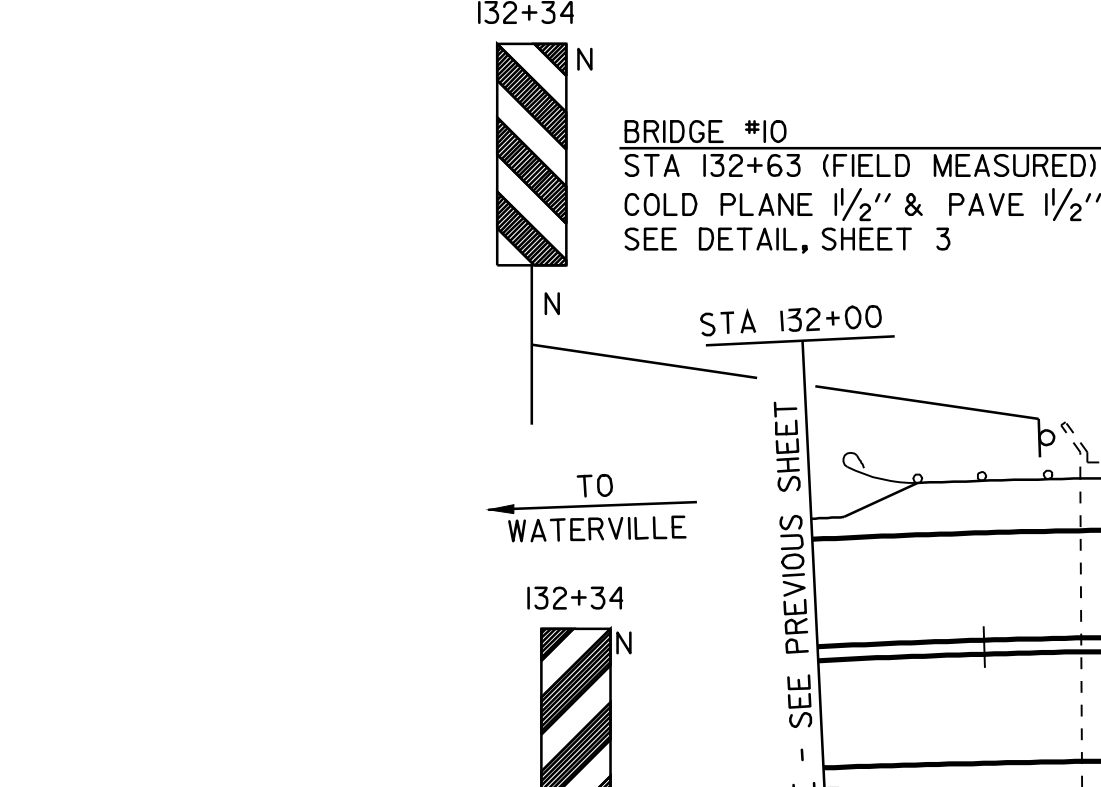


| | |
|-------------------------|---|
| STA 132+90 TO 133+40 LT | REMOVAL AND DISPOSAL OF GUARD RAIL |
| STA 132+90 TO 133+15 LT | INSTALL H.D. STEEL BEAM GUARD RAIL (GALVANIZED) |
| STA 132+90 TO 133+40 LT | INSTALL STEEL BEAM GUARD RAIL (GALVANIZED) |
| STA 132+90 TO 133+40 LT | INSTALL H.D. STEEL BEAM GUARD RAIL (GALVANIZED) |
| STA 132+90 TO 133+40 LT | REMOVAL OF EXISTING RAILING |

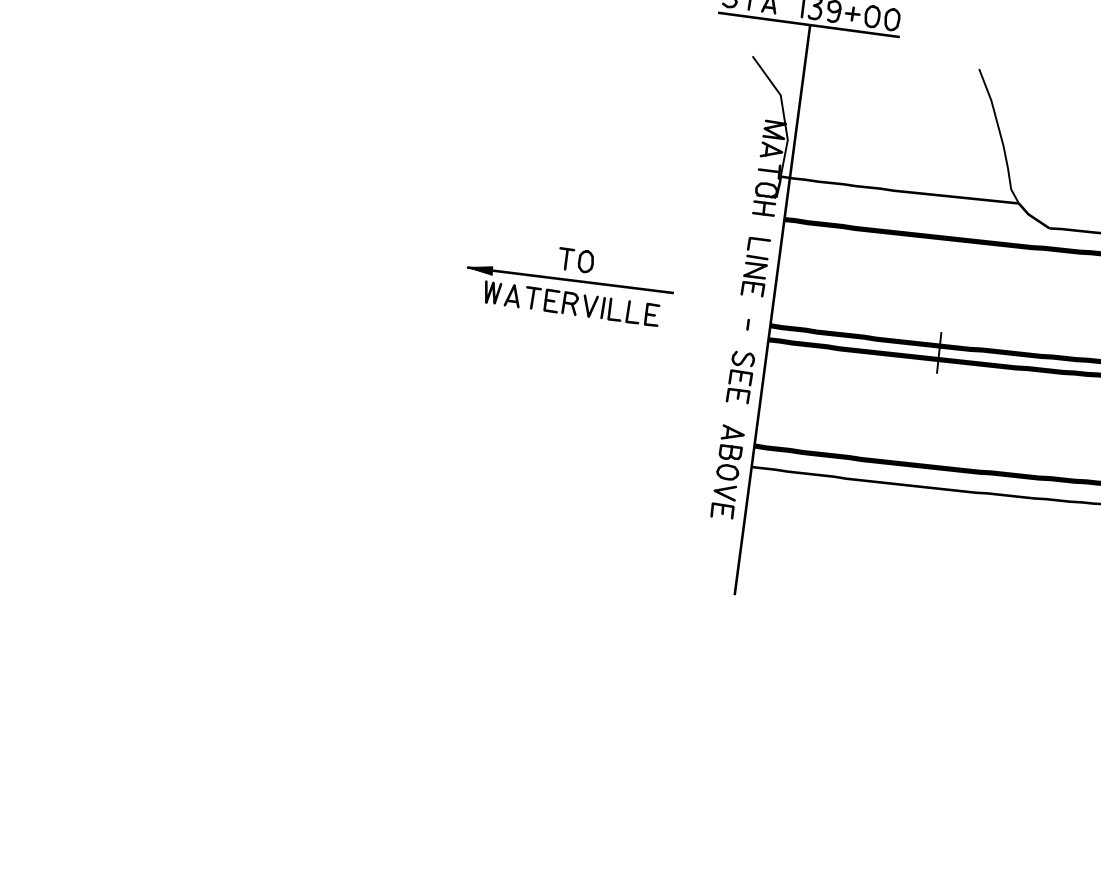


| | |
|-------------------------|---|
| STA 133+64 TO 134+00 RT | INSTALL ANCHOR FOR GUARD RAIL |
| STA 133+64 TO 134+00 RT | REMOVAL AND DISPOSAL OF GUARD RAIL |
| STA 133+64 TO 134+00 RT | INSTALL STEEL BEAM GUARD RAIL (GALVANIZED) |
| STA 133+64 TO 134+00 RT | INSTALL H.D. STEEL BEAM GUARD RAIL (GALVANIZED) |
| STA 133+64 TO 134+00 RT | REMOVAL OF EXISTING RAILING |

 

| | |
|----------------------|---|
| STA 132+00 TO 133+66 | TEMPORARY AND DURABLE 4 In YELLOW LINE |
| STA 132+00 TO 133+66 | TEMPORARY AND DURABLE 4 In WHITE LINE |
| STA 133+50 TO 133+66 | TEMPORARY AND DURABLE LETTER OR SYMBOL "STOP" |
| STA 133+50 TO 133+66 | TEMPORARY AND DURABLE 24 In STOP BAR |

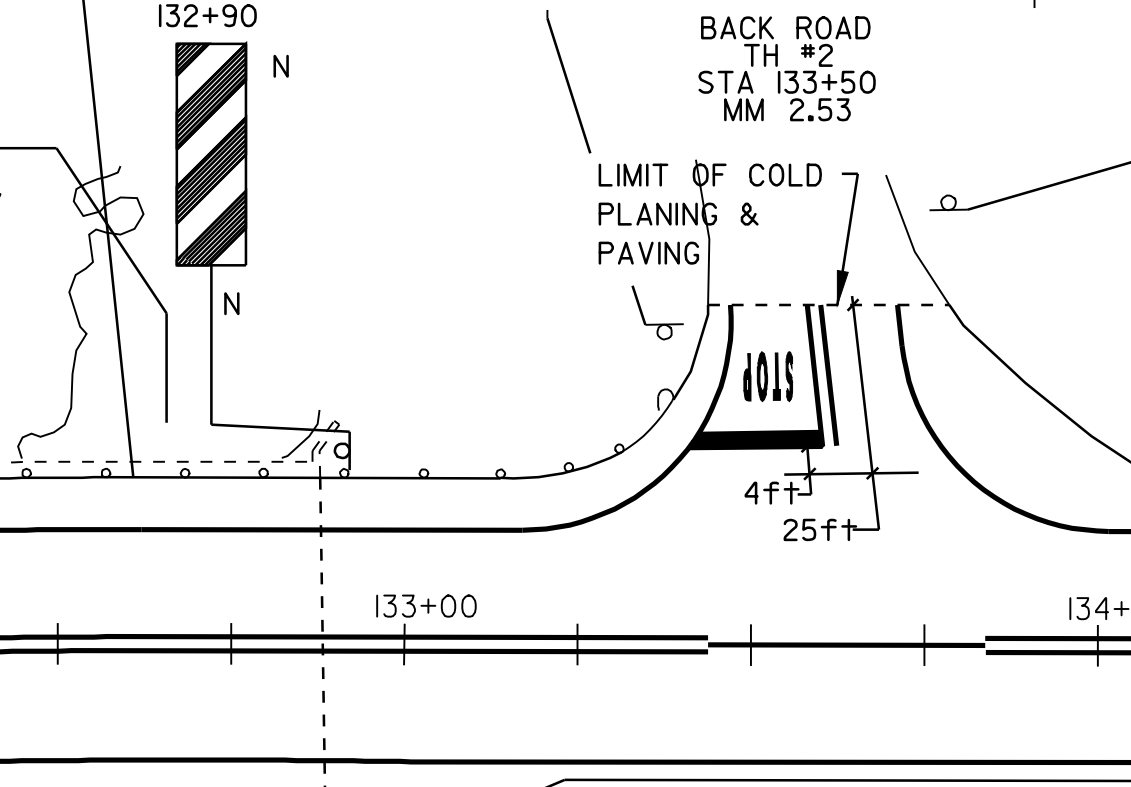


| | |
|-------------------------|---|
| STA 134+00 TO 135+00 RT | REMOVAL AND DISPOSAL OF GUARD RAIL |
| STA 134+00 TO 135+00 RT | REMOVAL OF EXISTING RAILING |
| STA 134+00 TO 135+00 RT | ANCHOR FOR GUARD RAIL |
| STA 134+00 TO 135+00 RT | STEEL BEAM GUARD RAIL (GALVANIZED) |
| STA 134+00 TO 135+00 RT | H.D. STEEL BEAM GUARD RAIL (GALVANIZED) |

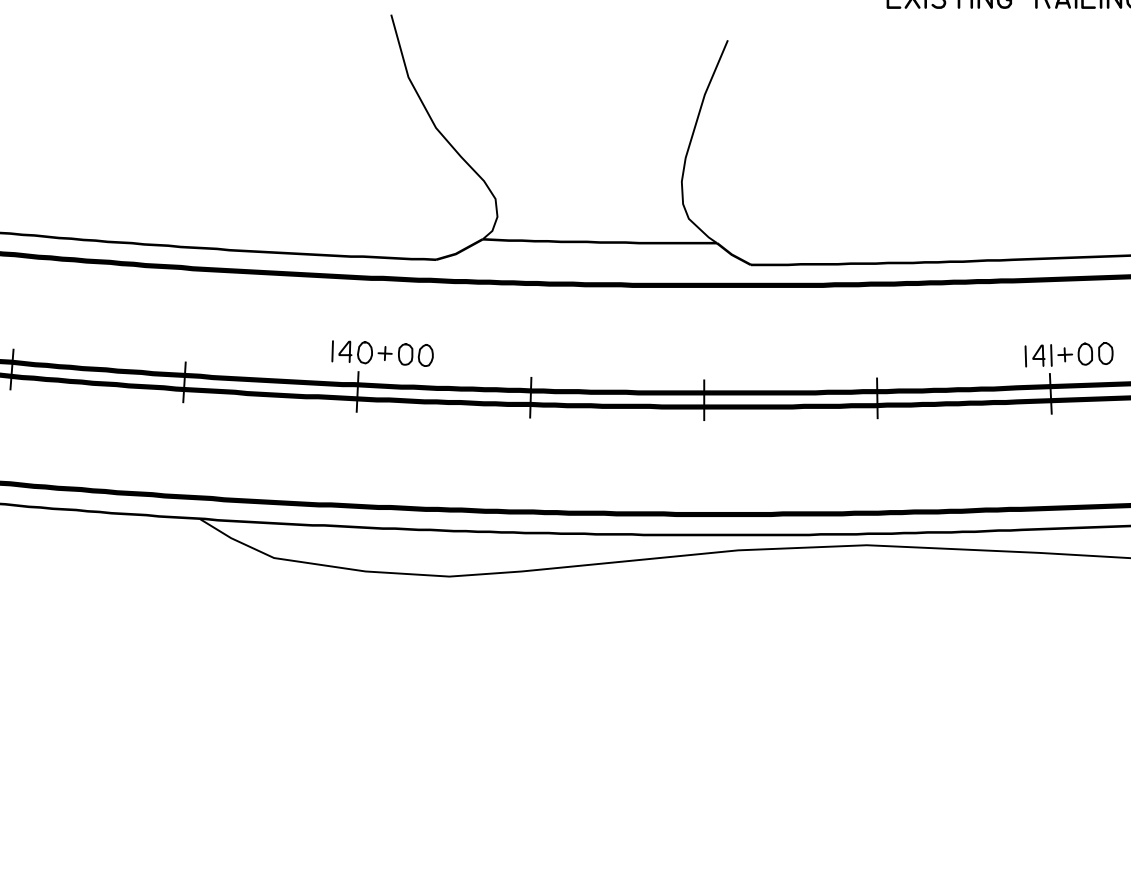


| | |
|-------------------------|---|
| STA 136+00 TO 137+00 RT | REMOVAL AND DISPOSAL OF GUARD RAIL |
| STA 136+00 TO 137+00 RT | REMOVAL OF EXISTING RAILING |
| STA 136+00 TO 137+00 RT | ANCHOR FOR GUARD RAIL |
| STA 136+00 TO 137+00 RT | STEEL BEAM GUARD RAIL (GALVANIZED) |
| STA 136+00 TO 137+00 RT | H.D. STEEL BEAM GUARD RAIL (GALVANIZED) |



| | |
|-------------------------|---|
| STA 137+00 TO 138+00 RT | REMOVAL AND DISPOSAL OF GUARD RAIL |
| STA 137+00 TO 138+00 RT | REMOVAL OF EXISTING RAILING |
| STA 137+00 TO 138+00 RT | ANCHOR FOR GUARD RAIL |
| STA 137+00 TO 138+00 RT | STEEL BEAM GUARD RAIL (GALVANIZED) |
| STA 137+00 TO 138+00 RT | H.D. STEEL BEAM GUARD RAIL (GALVANIZED) |

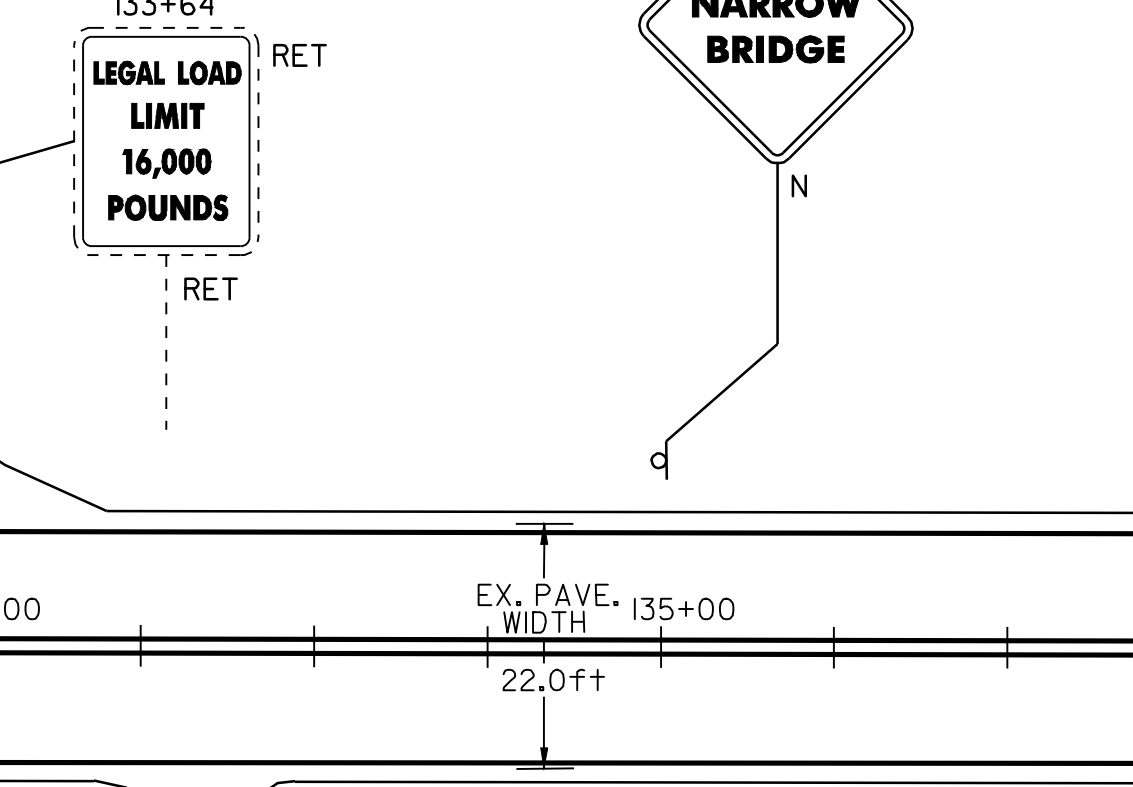


| | |
|-------------------------|---|
| STA 138+00 TO 139+00 RT | REMOVAL AND DISPOSAL OF GUARD RAIL |
| STA 138+00 TO 139+00 RT | REMOVAL OF EXISTING RAILING |
| STA 138+00 TO 139+00 RT | ANCHOR FOR GUARD RAIL |
| STA 138+00 TO 139+00 RT | STEEL BEAM GUARD RAIL (GALVANIZED) |
| STA 138+00 TO 139+00 RT | H.D. STEEL BEAM GUARD RAIL (GALVANIZED) |

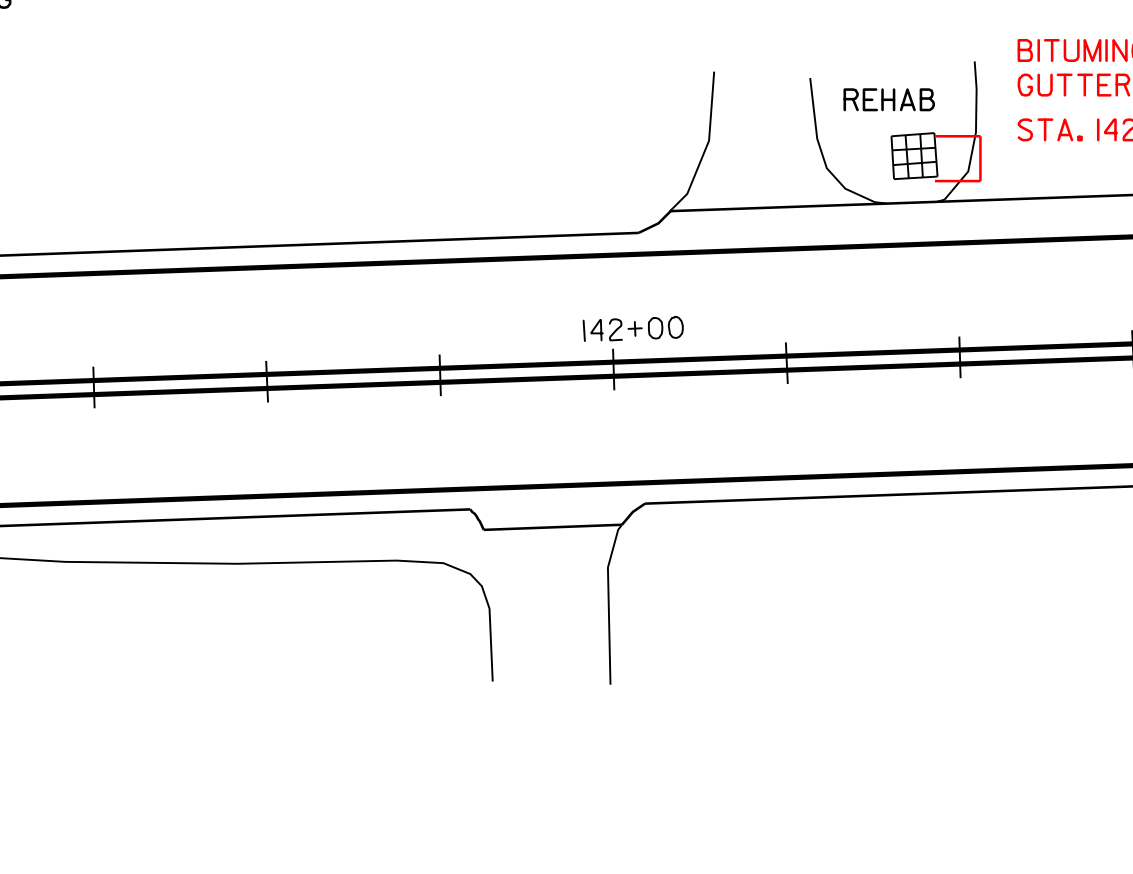


| | |
|-------------------------|---|
| STA 139+00 TO 140+00 RT | REMOVAL AND DISPOSAL OF GUARD RAIL |
| STA 139+00 TO 140+00 RT | REMOVAL OF EXISTING RAILING |
| STA 139+00 TO 140+00 RT | ANCHOR FOR GUARD RAIL |
| STA 139+00 TO 140+00 RT | STEEL BEAM GUARD RAIL (GALVANIZED) |
| STA 139+00 TO 140+00 RT | H.D. STEEL BEAM GUARD RAIL (GALVANIZED) |




| | |
|-------------------------|---|
| STA 140+00 TO 141+00 RT | REMOVAL AND DISPOSAL OF GUARD RAIL |
| STA 140+00 TO 141+00 RT | REMOVAL OF EXISTING RAILING |
| STA 140+00 TO 141+00 RT | ANCHOR FOR GUARD RAIL |
| STA 140+00 TO 141+00 RT | STEEL BEAM GUARD RAIL (GALVANIZED) |
| STA 140+00 TO 141+00 RT | H.D. STEEL BEAM GUARD RAIL (GALVANIZED) |

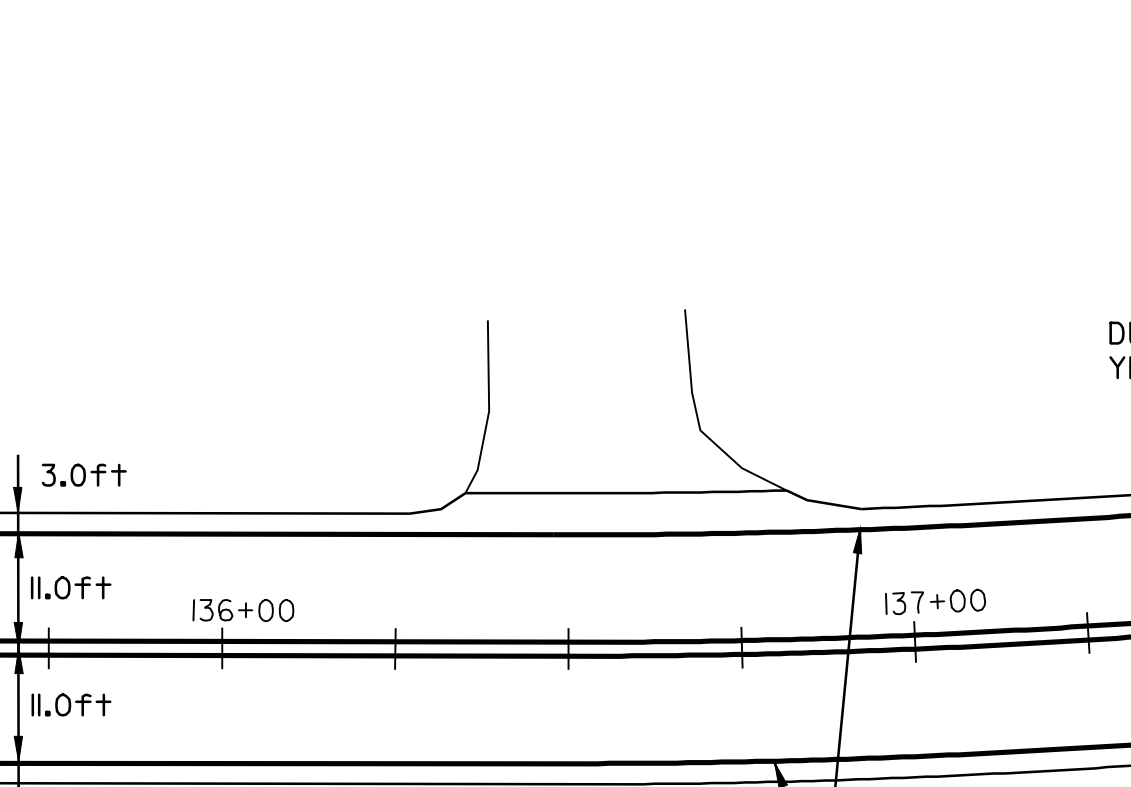


| | |
|-------------------------|---|
| STA 141+00 TO 142+00 RT | REMOVAL AND DISPOSAL OF GUARD RAIL |
| STA 141+00 TO 142+00 RT | REMOVAL OF EXISTING RAILING |
| STA 141+00 TO 142+00 RT | ANCHOR FOR GUARD RAIL |
| STA 141+00 TO 142+00 RT | STEEL BEAM GUARD RAIL (GALVANIZED) |
| STA 141+00 TO 142+00 RT | H.D. STEEL BEAM GUARD RAIL (GALVANIZED) |

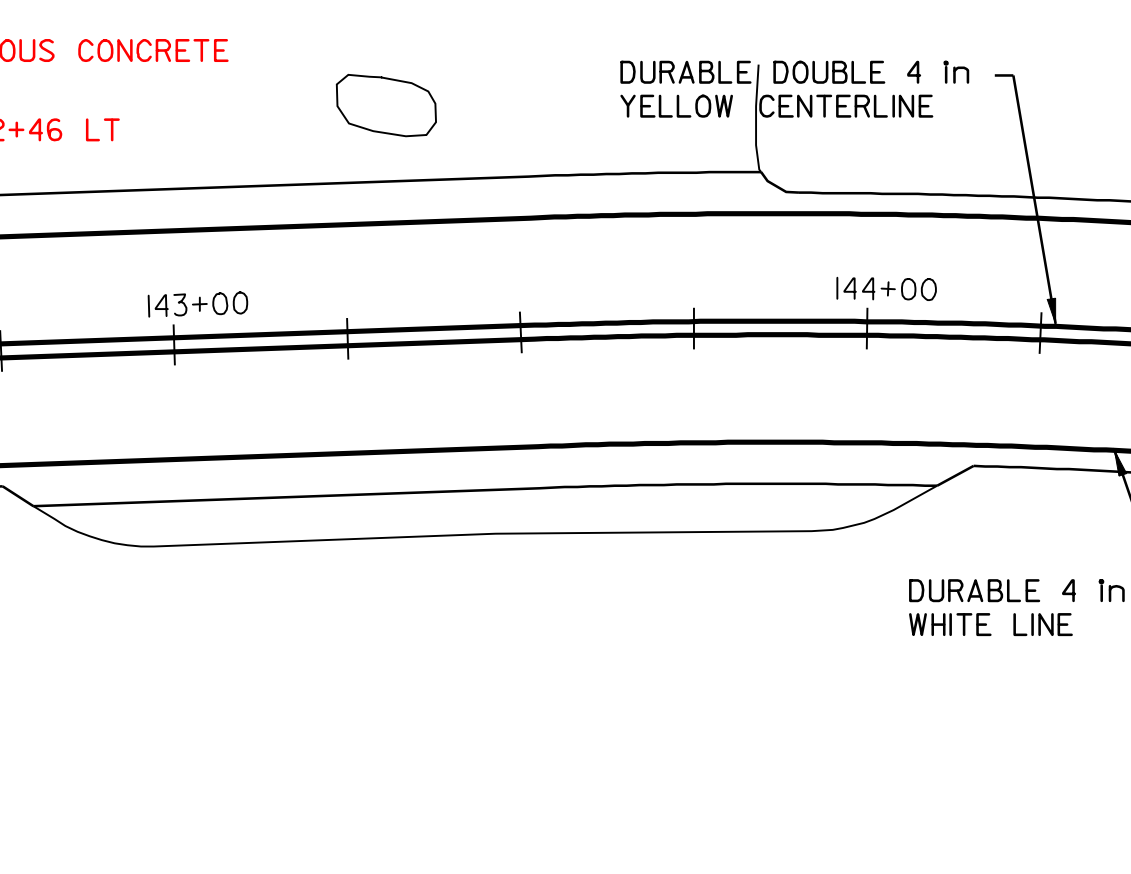


| | |
|-------------------------|---|
| STA 142+00 TO 143+00 RT | REMOVAL AND DISPOSAL OF GUARD RAIL |
| STA 142+00 TO 143+00 RT | REMOVAL OF EXISTING RAILING |
| STA 142+00 TO 143+00 RT | ANCHOR FOR GUARD RAIL |
| STA 142+00 TO 143+00 RT | STEEL BEAM GUARD RAIL (GALVANIZED) |
| STA 142+00 TO 143+00 RT | H.D. STEEL BEAM GUARD RAIL (GALVANIZED) |

 

| | |
|-------------------------|---|
| STA 143+00 TO 144+00 RT | REMOVAL AND DISPOSAL OF GUARD RAIL |
| STA 143+00 TO 144+00 RT | REMOVAL OF EXISTING RAILING |
| STA 143+00 TO 144+00 RT | ANCHOR FOR GUARD RAIL |
| STA 143+00 TO 144+00 RT | STEEL BEAM GUARD RAIL (GALVANIZED) |
| STA 143+00 TO 144+00 RT | H.D. STEEL BEAM GUARD RAIL (GALVANIZED) |

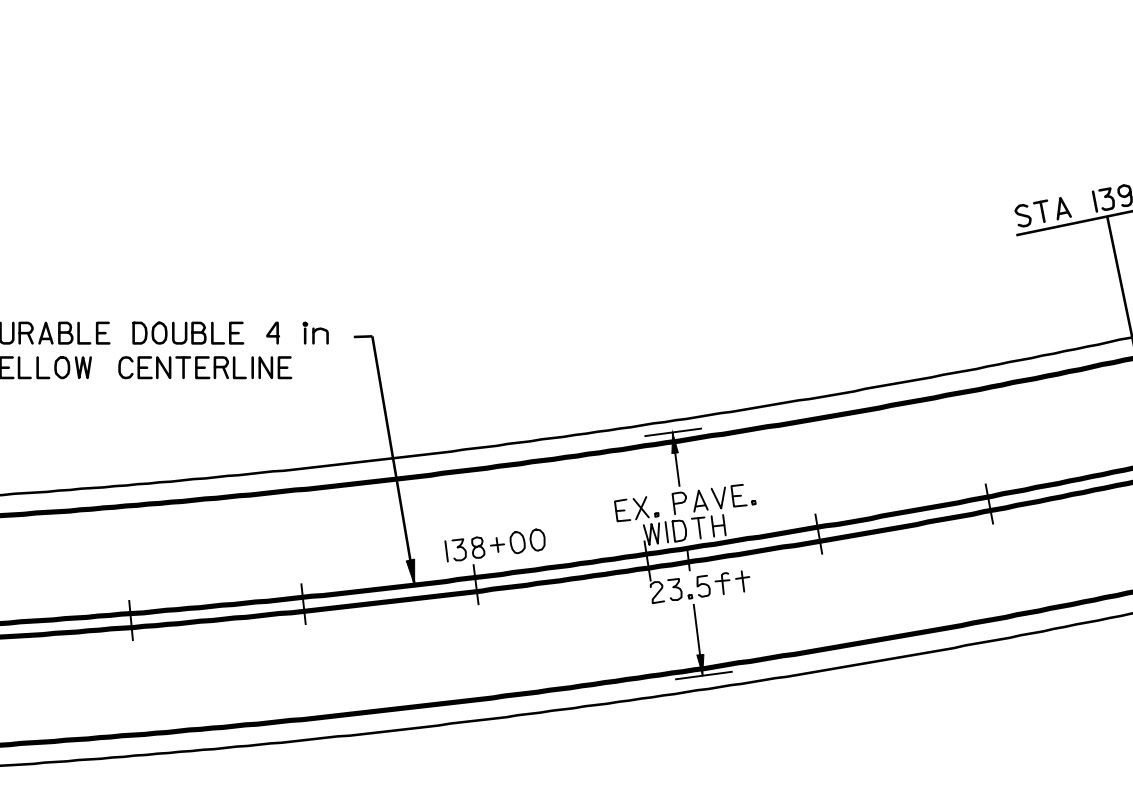


| | |
|-------------------------|---|
| STA 144+00 TO 145+00 RT | REMOVAL AND DISPOSAL OF GUARD RAIL |
| STA 144+00 TO 145+00 RT | REMOVAL OF EXISTING RAILING |
| STA 144+00 TO 145+00 RT | ANCHOR FOR GUARD RAIL |
| STA 144+00 TO 145+00 RT | STEEL BEAM GUARD RAIL (GALVANIZED) |
| STA 144+00 TO 145+00 RT | H.D. STEEL BEAM GUARD RAIL (GALVANIZED) |

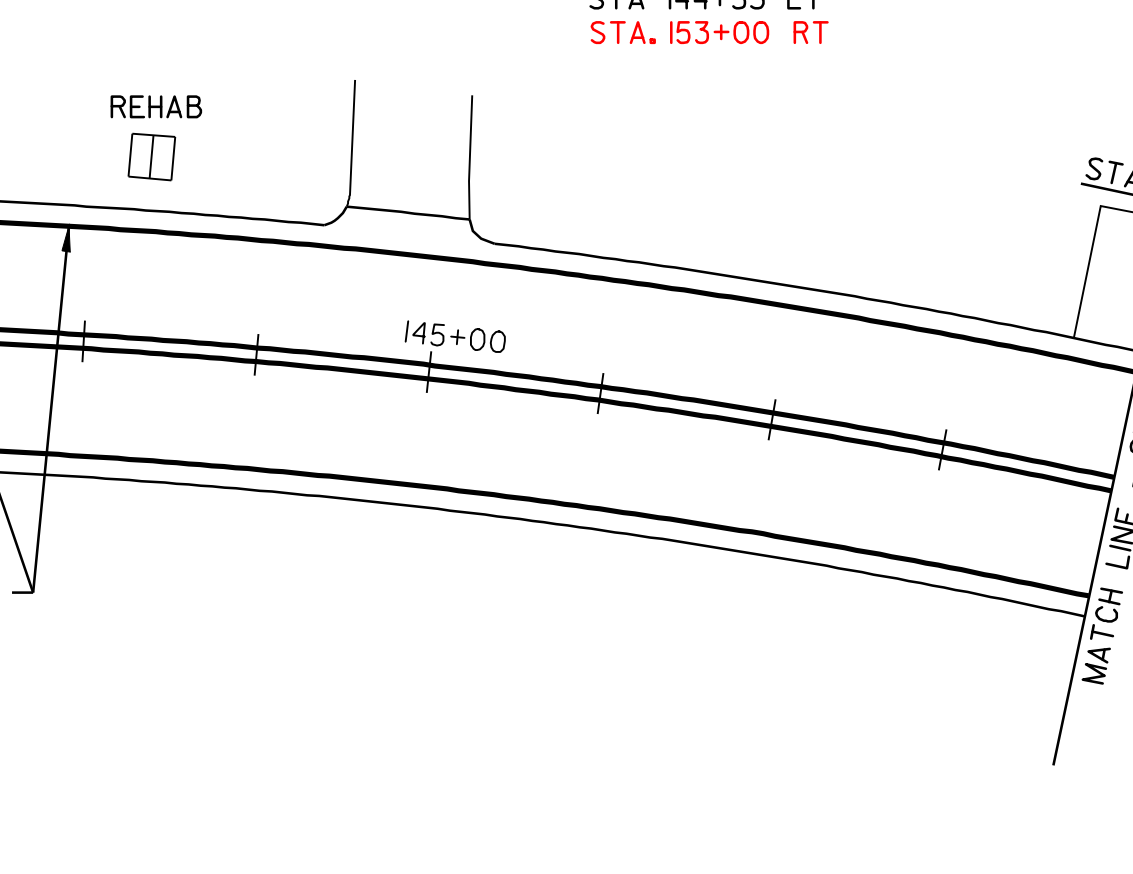


| | |
|-------------------------|---|
| STA 145+00 TO 146+00 RT | REMOVAL AND DISPOSAL OF GUARD RAIL |
| STA 145+00 TO 146+00 RT | REMOVAL OF EXISTING RAILING |
| STA 145+00 TO 146+00 RT | ANCHOR FOR GUARD RAIL |
| STA 145+00 TO 146+00 RT | STEEL BEAM GUARD RAIL (GALVANIZED) |
| STA 145+00 TO 146+00 RT | H.D. STEEL BEAM GUARD RAIL (GALVANIZED) |




| | |
|-------------------------|---|
| STA 146+00 TO 147+00 RT | REMOVAL AND DISPOSAL OF GUARD RAIL |
| STA 146+00 TO 147+00 RT | REMOVAL OF EXISTING RAILING |
| STA 146+00 TO 147+00 RT | ANCHOR FOR GUARD RAIL |
| STA 146+00 TO 147+00 RT | STEEL BEAM GUARD RAIL (GALVANIZED) |
| STA 146+00 TO 147+00 RT | H.D. STEEL BEAM GUARD RAIL (GALVANIZED) |

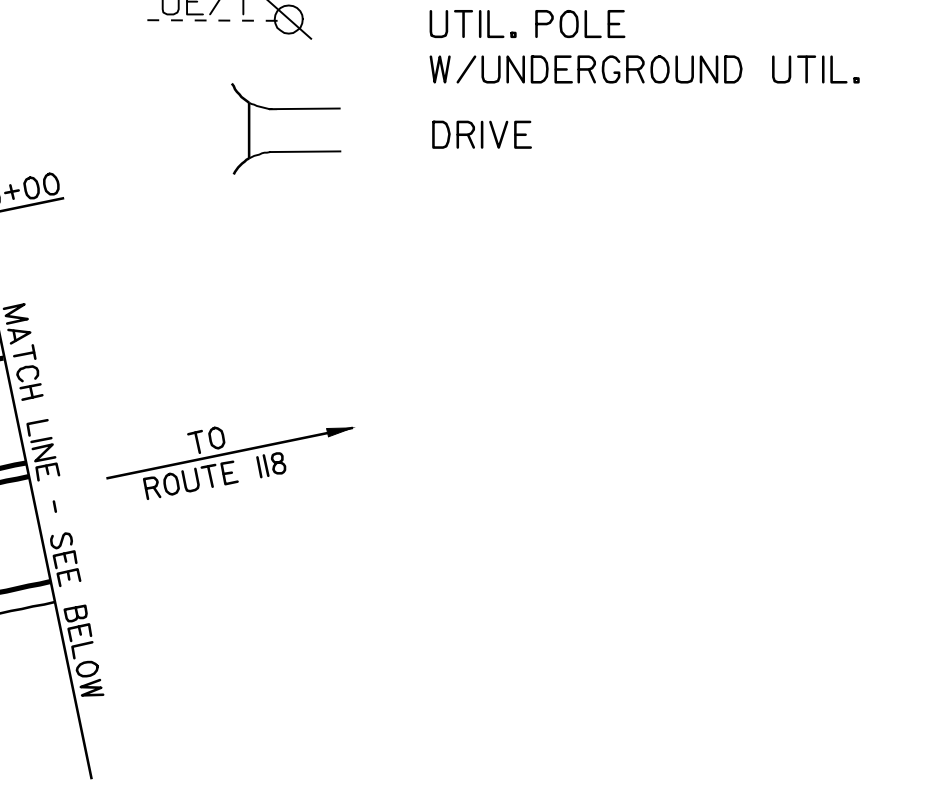

| | |
|-------------------------|---|
| STA 147+00 TO 148+00 RT | REMOVAL AND DISPOSAL OF GUARD RAIL |
| STA 147+00 TO 148+00 RT | REMOVAL OF EXISTING RAILING |
| STA 147+00 TO 148+00 RT | ANCHOR FOR GUARD RAIL |
| STA 147+00 TO 148+00 RT | STEEL BEAM GUARD RAIL (GALVANIZED) |
| STA 147+00 TO 148+00 RT | H.D. STEEL BEAM GUARD RAIL (GALVANIZED) |

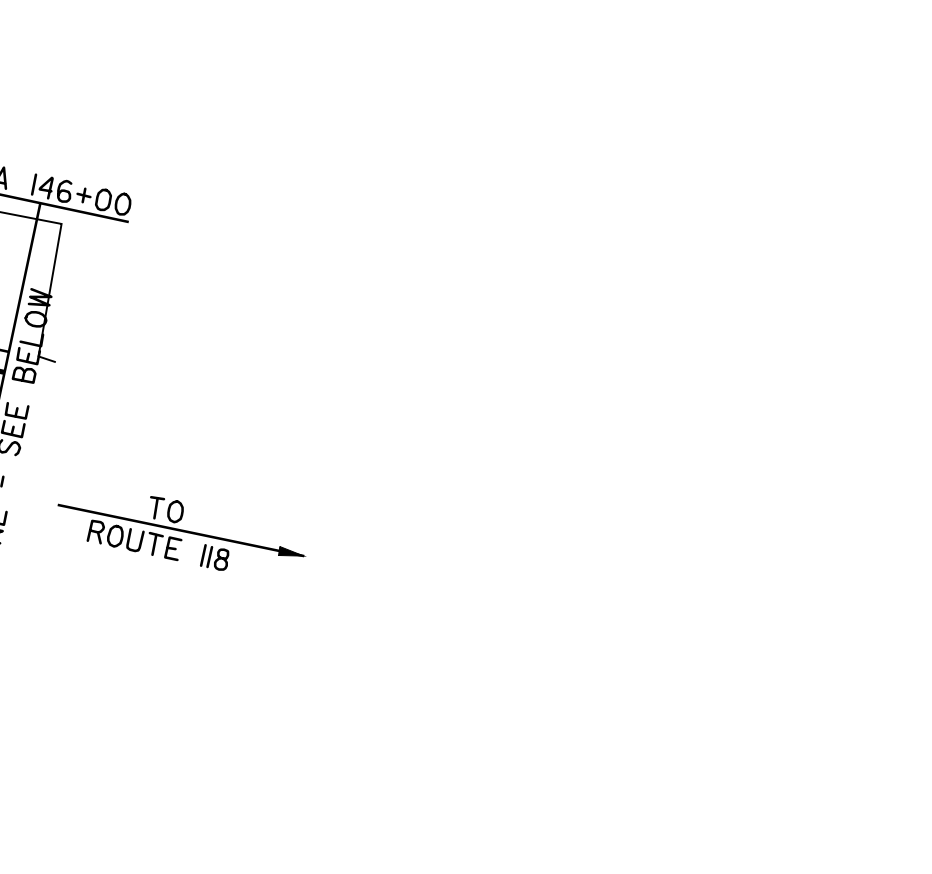

| | |
|-------------------------|---|
| STA 148+00 TO 149+00 RT | REMOVAL AND DISPOSAL OF GUARD RAIL |
| STA 148+00 TO 149+00 RT | REMOVAL OF EXISTING RAILING |
| STA 148+00 TO 149+00 RT | ANCHOR FOR GUARD RAIL |
| STA 148+00 TO 149+00 RT | STEEL BEAM GUARD RAIL (GALVANIZED) |
| STA 148+00 TO 149+00 RT | H.D. STEEL BEAM GUARD RAIL (GALVANIZED) |

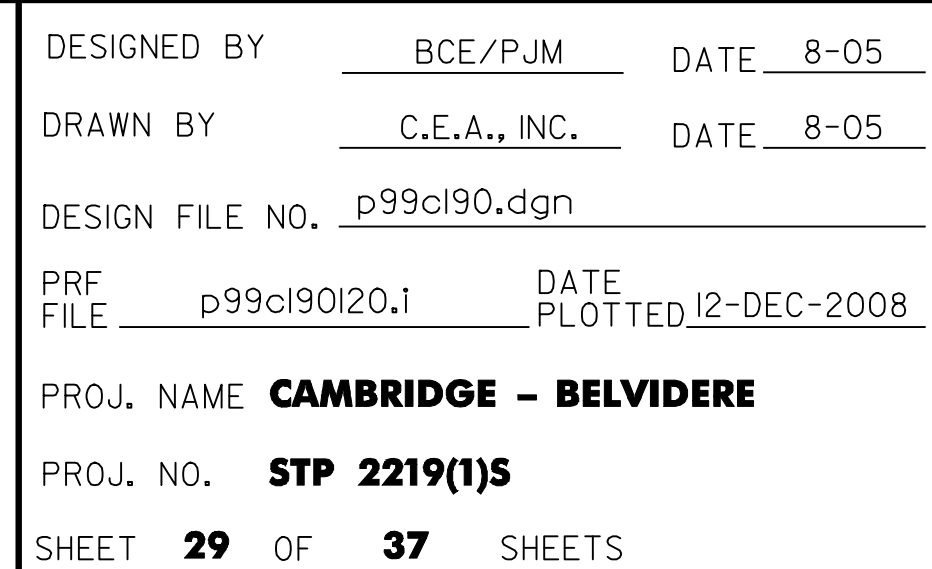

VT ROUTE 109
STA 153+66 = MM 2.910
END PROJECT STP 2219(1)S

PAVING PROJECT LAYOUT SHEET #20

| | | | |
|-----------------|-----------------------|--------------|----------------|
| DESIGNED BY | BCE/PJM | DATE | 8-05 |
| DRAWN BY | C.E.A., INC. | DATE | 8-05 |
| DESIGN FILE NO. | p99c190.dgn | | |
| PRF FILE | p99c190120.1 | DATE PLOTTED | 12-DEC-2008 09 |
| PROJ. NAME | CAMBRIDGE - BELVIDERE | | |
| PROJ. NO. | STP 2219(1)S | | |
| SHEET | 29 | OF | 37 SHEETS |