


TYPICAL BRIDGE SECTION

SCALE: 3/8" = 1'-0"
(* POSITION OF BEAMS WITH RESPECT TO CENTERLINE CONSTRUCTION VARIES)
(** CURB AND SIDEWALK OVERHANG WIDTHS VARY)

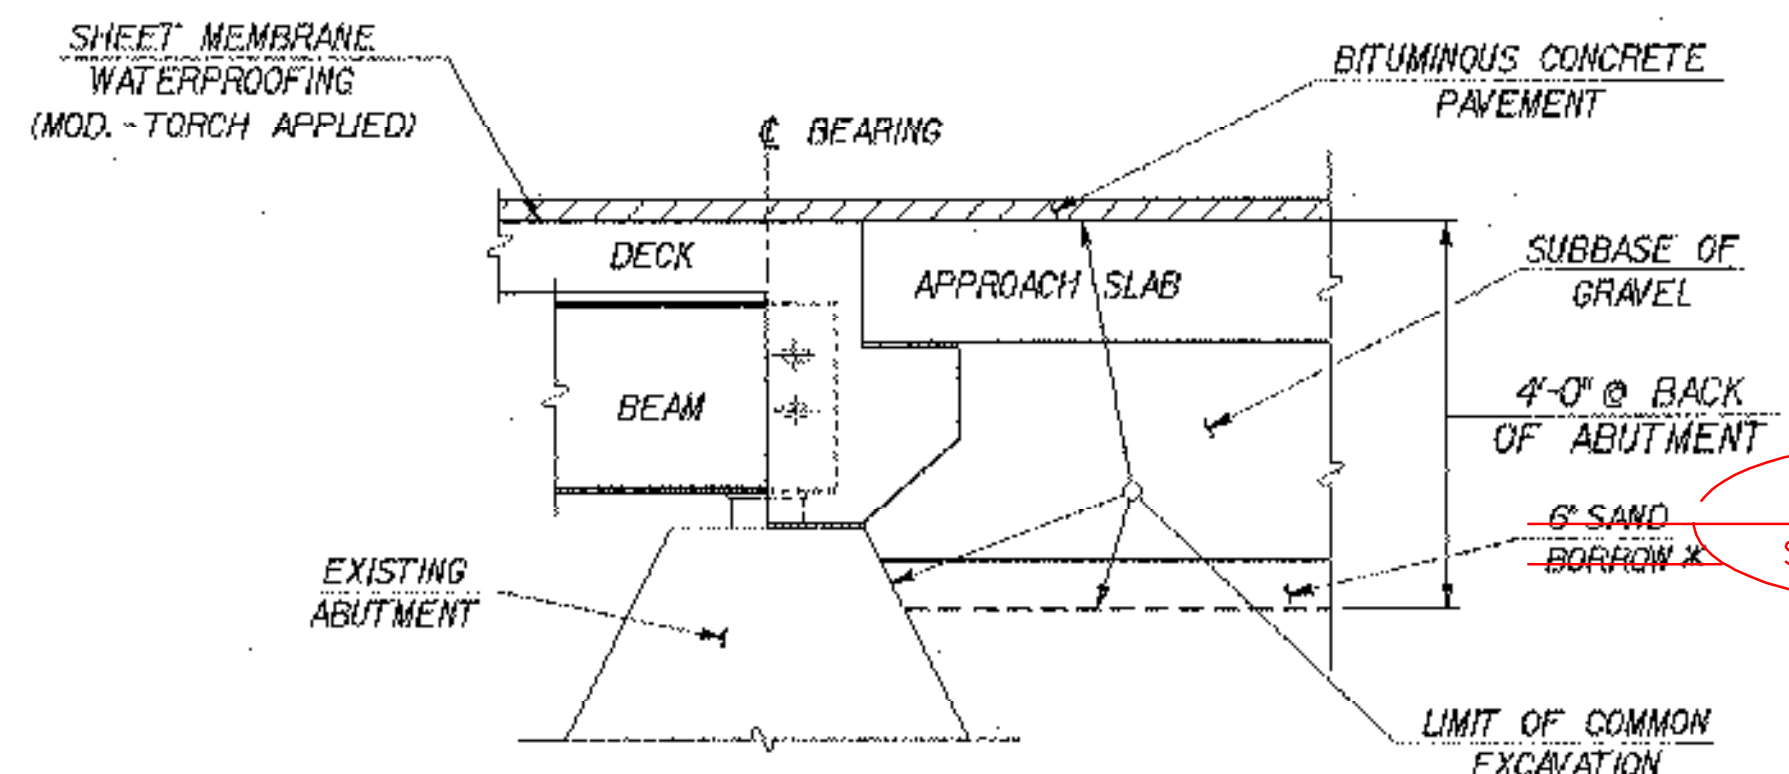


TYPICAL ABUTMENT EARTHWORK SECTION

SCALE: 1/2" = 1'-0"

MATERIAL ITEM	TOLERANCE
PAVEMENT	± 1/4" TOTAL THICKNESS
SUBBASE OF GRAVEL	± 1"
SAND BORROW *	± 1"

* 6" SAND BORROW TO BE USED ONLY IF SO DIRECTED BY THE RESIDENT ENGINEER.

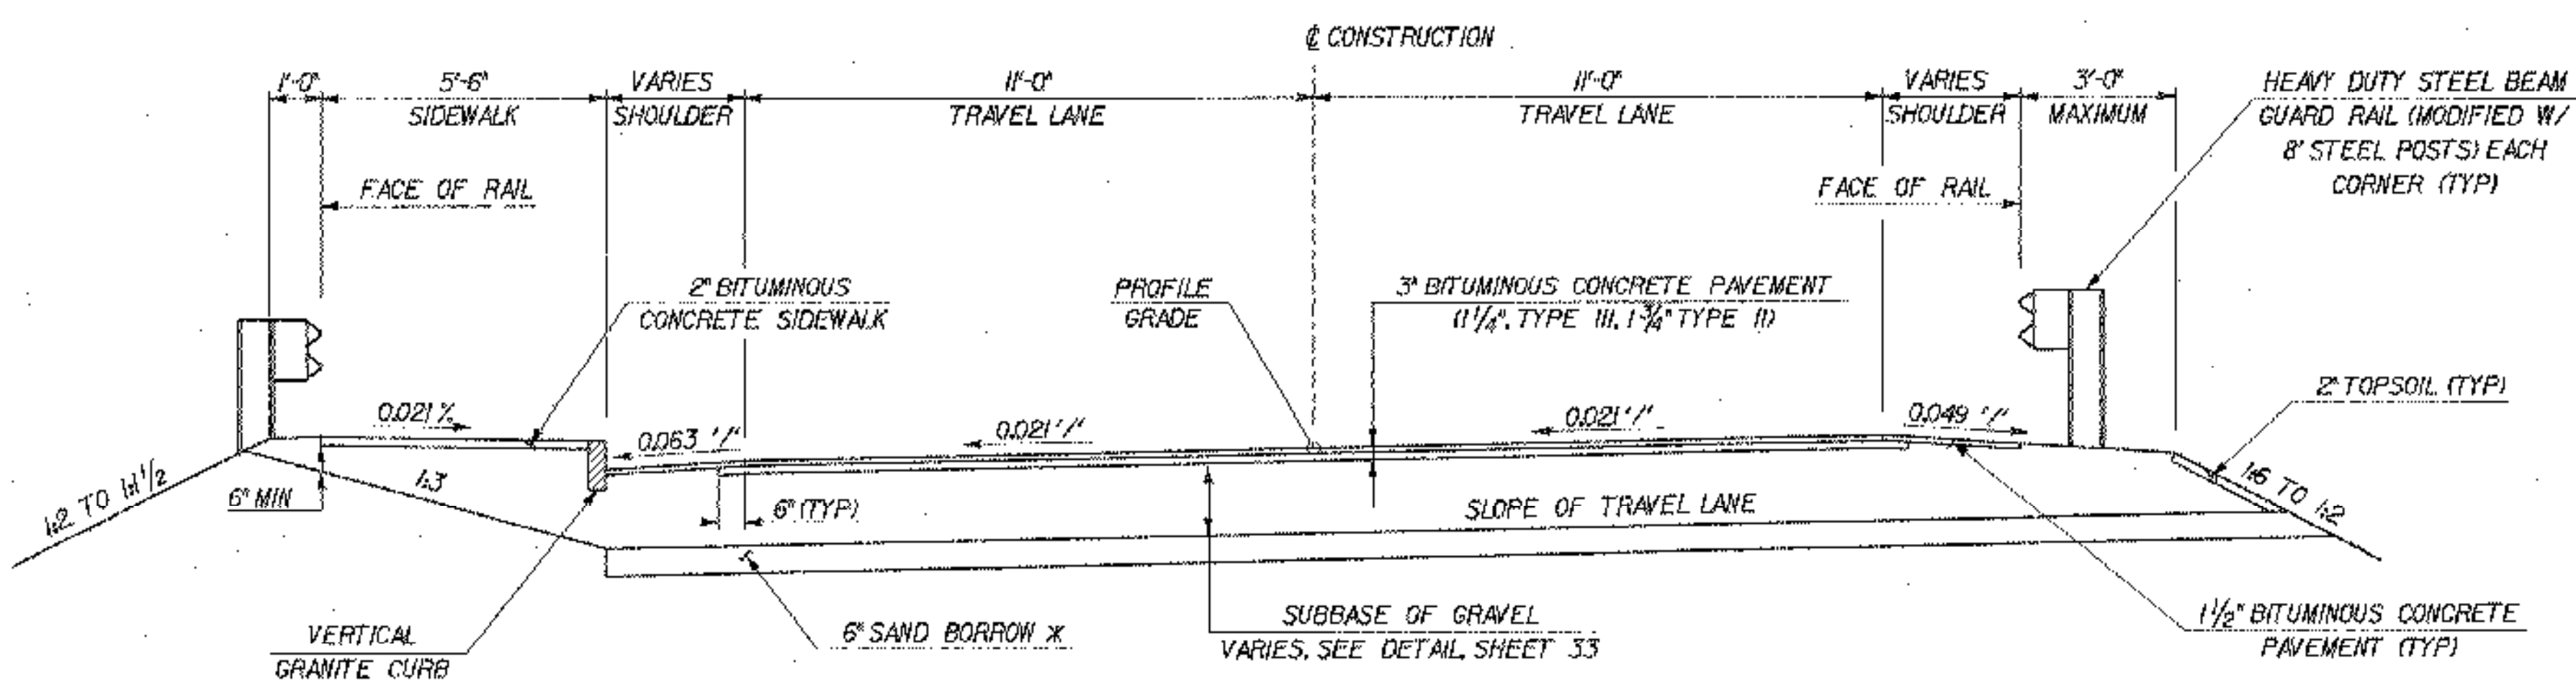

TYPICAL ROADWAY SECTION

SCALE: 3/8" = 1'-0"

* 6" SAND BORROW TO BE USED ONLY IF SO DIRECTED BY THE RESIDENT ENGINEER.

EXISTING STRUCTURE DATA

STRUCTURE TYPE: CONCRETE ABUTMENT WITH REINFORCED CONCRETE DECK ON ROLLED STEEL BEAMS.
THE BRIDGE RAIL IS AN ALUMINUM SPINDLE TYPE, SET ON STEEL POSTS. BUILT IN 1961.
OVERALL LENGTH: 172 FEET. INVENTORY RATING: 24.7 TDMS.
OVERALL DECK WIDTH: 38'-8".
SPAN LENGTH(S) CENTER TO CENTER OF BEARING: SPAN 1: 51'-11 15/16", SPAN 2: 81'-11 7/8", SPAN 3: 31'-11 15/16".
CLEAR SPAN LENGTH(S) NORMAL TO STREAM: 170'-0".
DISPOSITION OF STRUCTURE: REMOVE EXISTING CONCRETE DECK, RAILS, AND STEEL BEAMS. THE EXISTING ABUTMENTS AND PIERS ARE TO BE MODIFIED AS SHOWN. STEEL BEAMS AND RAIL TO BE DISPOSED OF BY CONTRACTOR.

NEW STRUCTURE DATA

STRUCTURE GEOMETRY
STRUCTURE TYPE: NEW STEEL ROLLED BEAMS WITH REINFORCED CONCRETE DECK.
OVERALL LENGTH: 172'-0" (MEASURED ALONG CENTERLINE CONSTRUCTION).
OVERALL DECK WIDTH: 38'-4".
SPAN LENGTH(S) CENTER TO CENTER OF BEARING: SPAN 1: 51'-11 15/16", SPAN 2: 81'-11 7/8", SPAN 3: 31'-11 15/16".
CLEAR SPAN LENGTH(S) NORMAL TO STREAM: 170'-0".
ARE PROVISIONS TO BE MADE FOR PUBLIC UTILITIES? NO.

HYDRAULIC DATA

NO CHANGE FROM EXISTING STRUCTURE.

DESIGN CRITERIA

- DESIGN LIVE LOAD AASHTO: HS 25
- DESIGN SPAN: 52-82-32
- ALLOWABLE LOAD FOR SPREAD FOOTINGS ON SOIL: N/A ON LEDGE: N/A
- ALLOWABLE LOAD FOR PILING: N/A TYPE: N/A ESTIMATED LENGTH: N/A
- STRUCTURAL STEEL AASHTO GRADE: M20, GR50W
- REINFORCING STEEL GRADE: 60
- CONCRETE HPC A: f'c = 4000 PSI
CONCRETE HPC B: f'c = 3500 PSI

TRAFFIC MAINTENANCE

TRAFFIC TO BE MAINTAINED BY DETOUR

LOADING LEVELS (LOAD FACTOR)	TRUCK						
	H	HS	352	6 AXLE	3A. STR.	4A. STR.	5A. SEMI
INVENTORY A=2.17, B=1.00	40	55					
POSTED A=1.55, B=1.40	56	76	91		70	72	83
OPERATING A=1.30, B=1.67		91	108	129	83	86	

STRENGTH RF = $\frac{0.95 F_y S_{LL+1} - M_{DL}}{A \times M_{LL+1}}$ SERVICEABILITY RF = $B \frac{0.95 F_y S_{LL+1} - M_{DL}}{1.67 M_{LL+1}}$

TRAFFIC DATA		ALT VT 122 BR 2	
2001 ADT	3,030 VPD	OK	50%
2021 ADT	4,030 VPD	TK	5.0%
2001 ADTT	150 VPD	DESIGN SPEED 35 MPH	
2021 ADTT	200 VPD	18 KIP ESALS (2 LANES)	
2001 DHV	370 VPH	20 YR - 746,150	
		40 YR - 1,671,144	

STATE OF VERMONT AGENCY OF TRANSPORTATION

Town Of	LYNDON	Bridge No.	2
Highway No.	ALT VT 122	Log Sta.	
CENTER STREET OVER PASSUMPSIC RIVER			
PRELIMINARY INFORMATION SHEET			
Designed By	T. GRANT / S. MERKMAN	Drawn By	S. DEUA / S. MERKMAN
Checked By	T. GRANT / R. WOOD	Date	10/01
		Bridge Design Supervisor	M. ZYDEL
PROJECT	LYNDON	PROJECT NO.	BHO 1447(26)
I.G.C. Info.	m:\549\03\600\rvz\238pl.dgn		
Bridge Sheet No.	Sheet 2 of 34		

