


PROFILE



<b>STATE OF VERMONT AGENCY OF TRANSPORTATION</b>			
Town Of	LYNDON	Bridge No.	2
Highway No.	ALT VT 122	Log Sta.	
		Surv. Sta.	
<b>CENTER STREET OVER PASSUMPSIC RIVER</b>			
<b>PROFILE</b>			
Designed By	T. GRANT	Drawn By	S. DELIA
Checked By	T. GRANT	Bridge Design Supervisor	M. ZYDEL
Date	10/01	Date	10/01
PROJECT	LYNDON	PROJECT NO.	BHO 1447(26)
I.G.C. Info.	m\549103\6cont\zj238prodgn		
Bridge Sheet No.	Sheet 5 of 34		

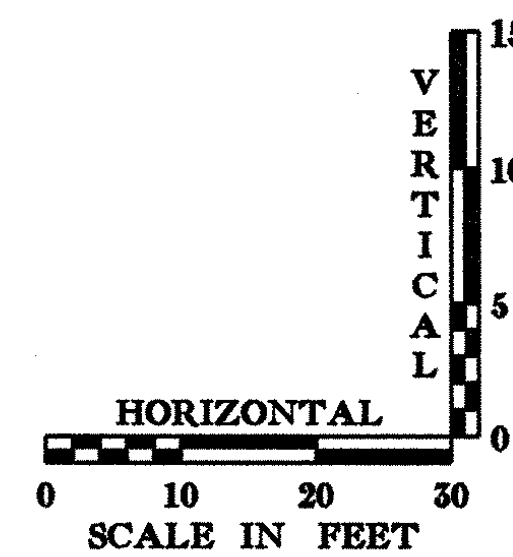