


PLAN
SCALE 1" = 10'-0"

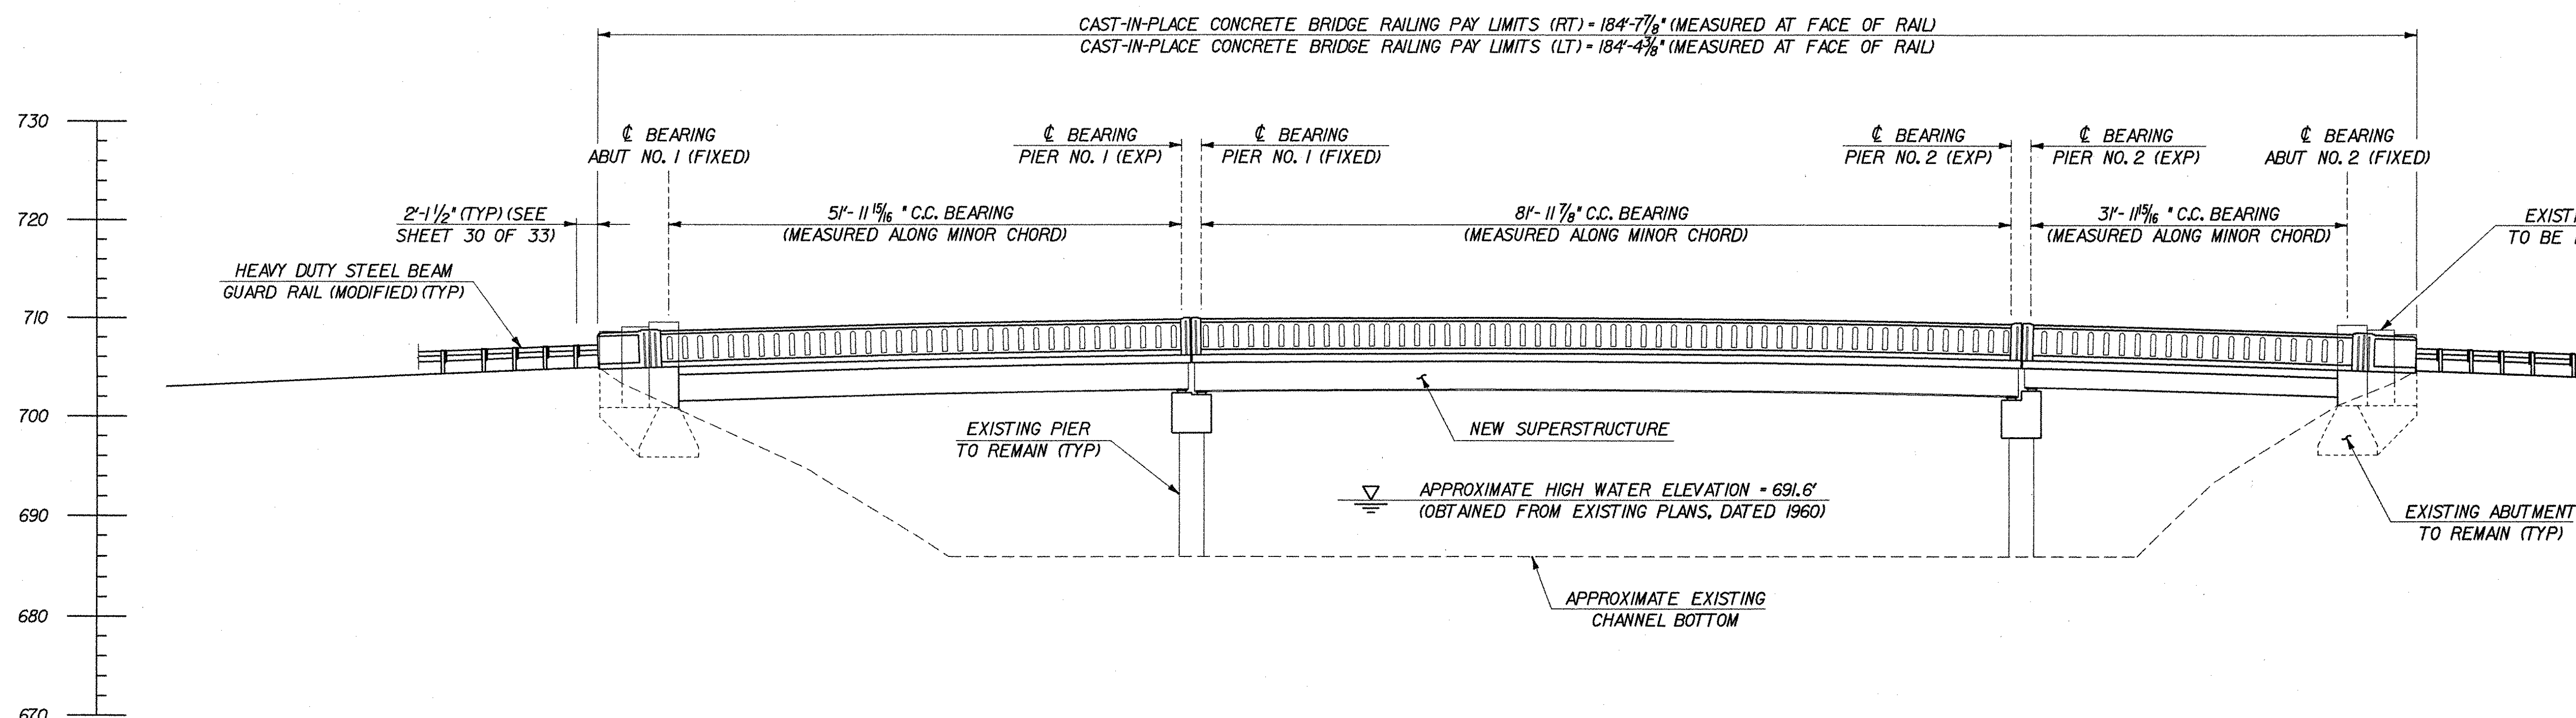

ELEVATION
SCALE 1" = 10'-0"

STATE OF VERMONT AGENCY OF TRANSPORTATION			
Town Of	LYNDON	Bridge No.	2
Highway No.	ALT VT 122	Log Sta.	
		Surv. Sta.	
CENTER STREET OVER PASSUMPSIC RIVER			
PLAN AND ELEVATION			
Designed By	T. GRANT	Drawn By	S. DELIA
Checked By	T. GRANT	Bridge Design Supervisor	M. ZYDEL
	Date 10/01	Date	10/01
PROJECT	LYNDON	PROJECT NO.	BHO 1447(26)
i.g.c. Info.	m:\549103\6cont\zj238gpe.dgn		
Bridge Sheet No.	Sheet 11 of 34		

