


SPAN NO.2 AND NO.3 PLAN

SCALE: 1/16" = 1'-0"
 (ESS07 NOT SHOWN IN PIER FOR CLARITY.
 SEE SHEET 22 OF 34 FOR LOCATION)

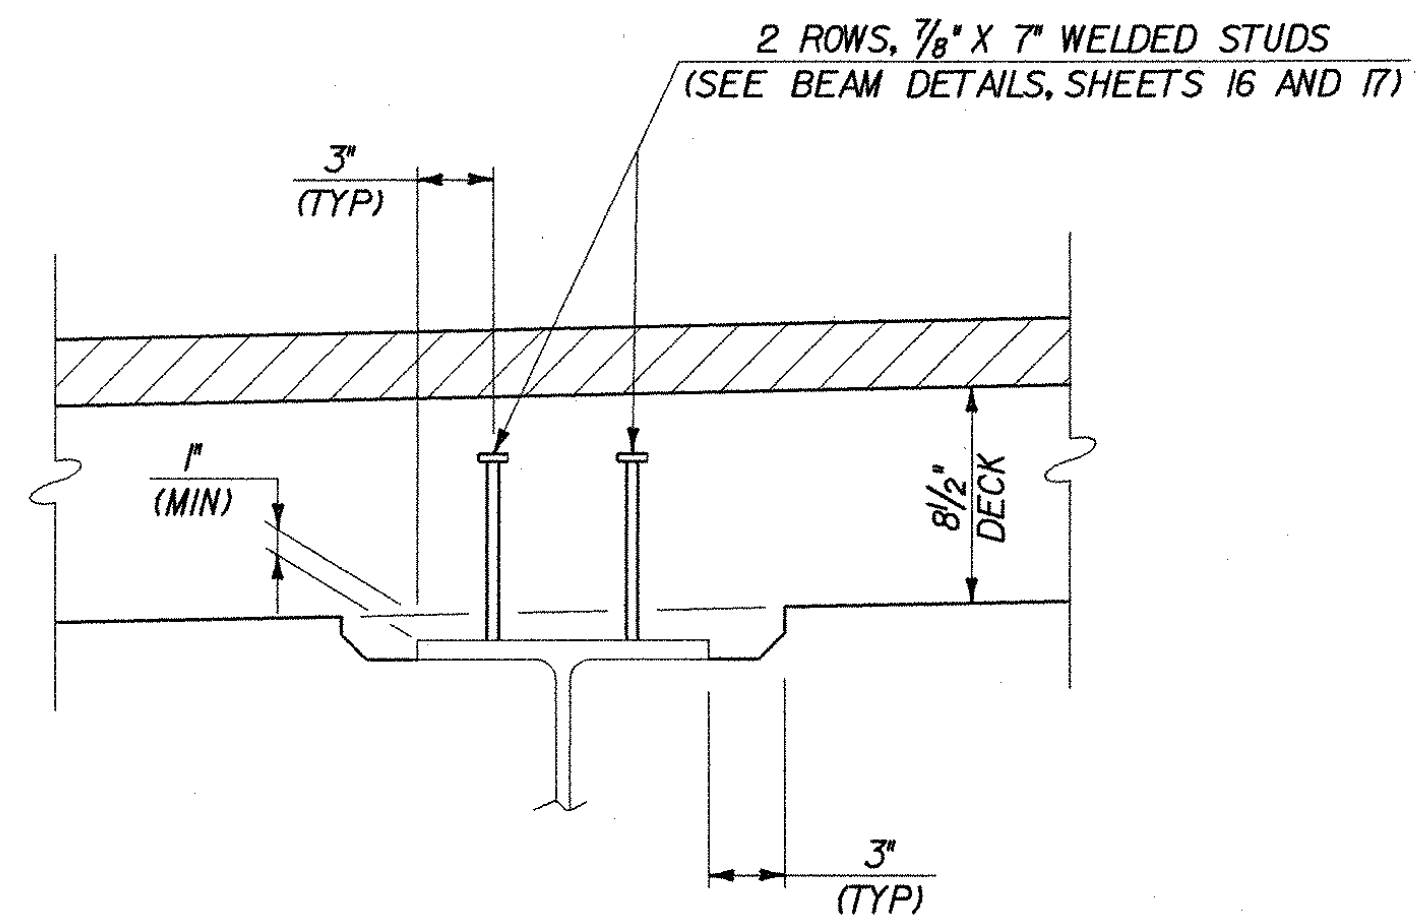

HAUNCH AND SHEAR CONNECTOR DETAILS

SCALE: 1/2" = 1'-0"

NOTE

1. SEE SHEET 13 OF 34 FOR REINFORCING NOTES.

STATE OF VERMONT AGENCY OF TRANSPORTATION	
Town Of LYNDON	Bridge No. 2
Highway No. ALT VT 122	Log Sta. Surv. Sta.
CENTER STREET OVER PASSUMPSIC RIVER DECK REINFORCING - 2	
Designed By T.GRANT	Drawn By S.DELIA
Checked By T.GRANT	Bridge Design Supervisor M.ZYDEL Date 10/01
PROJECT LYNDON	PROJECT NO. BHO 1447(26)
I.G.C. Info. m:\549103\6cont\z\238dr2.dgn	
Bridge Sheet No.	Sheet 14 of 34

