




103+00

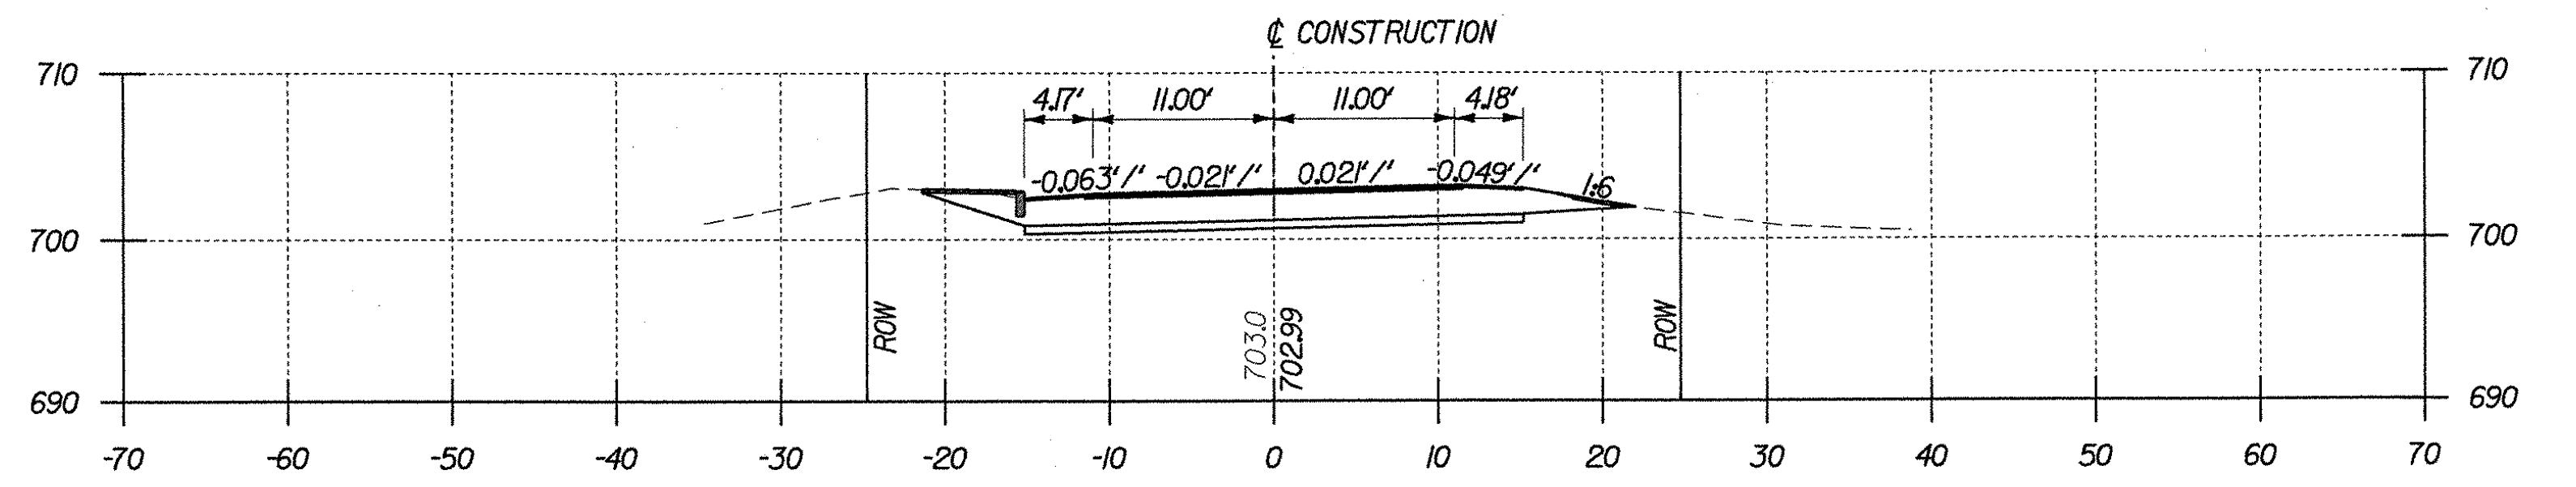


103+26
END PROJECT

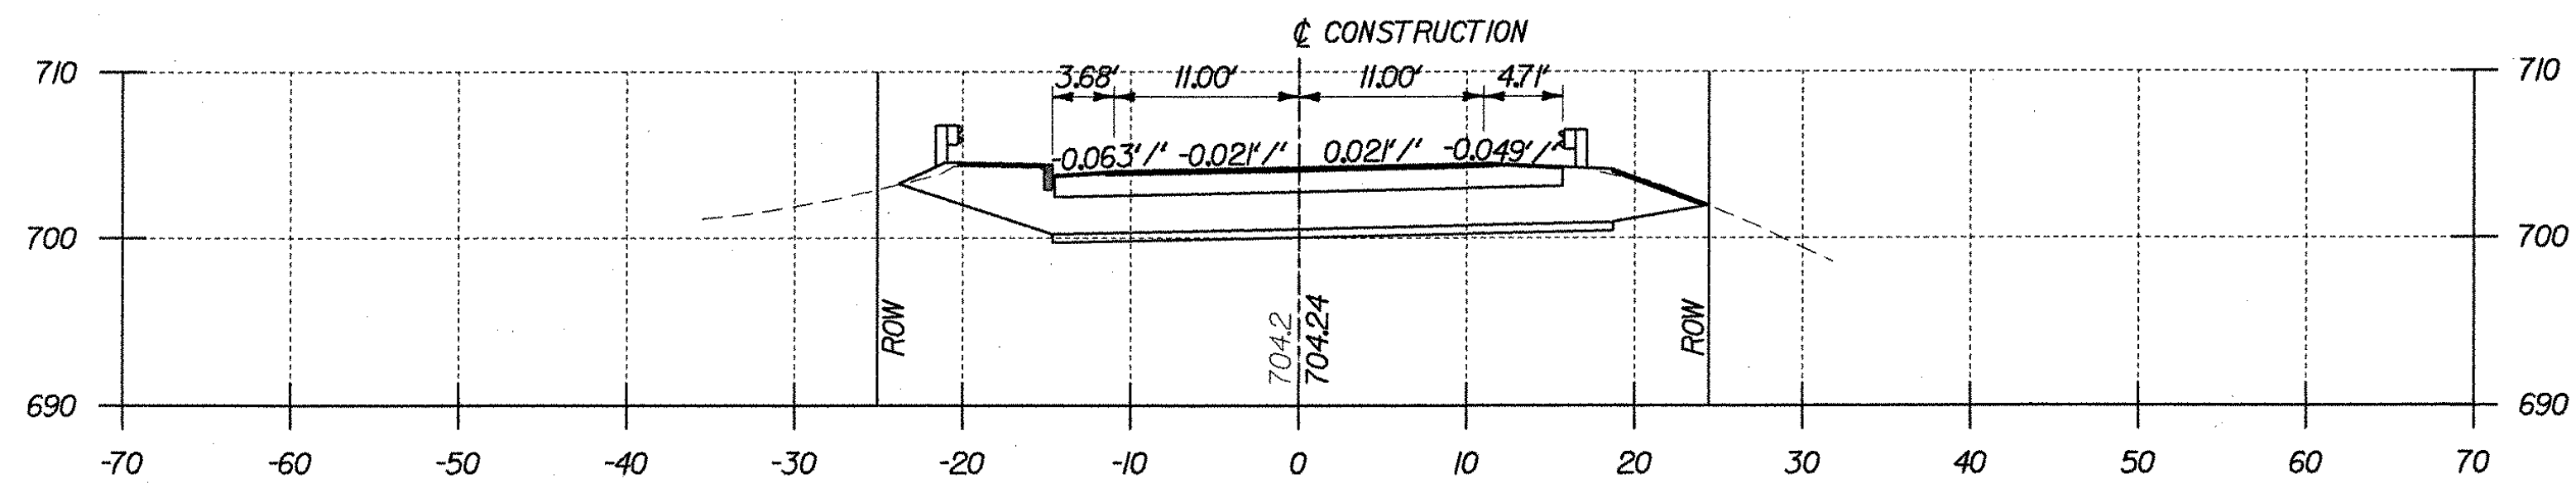


102+90

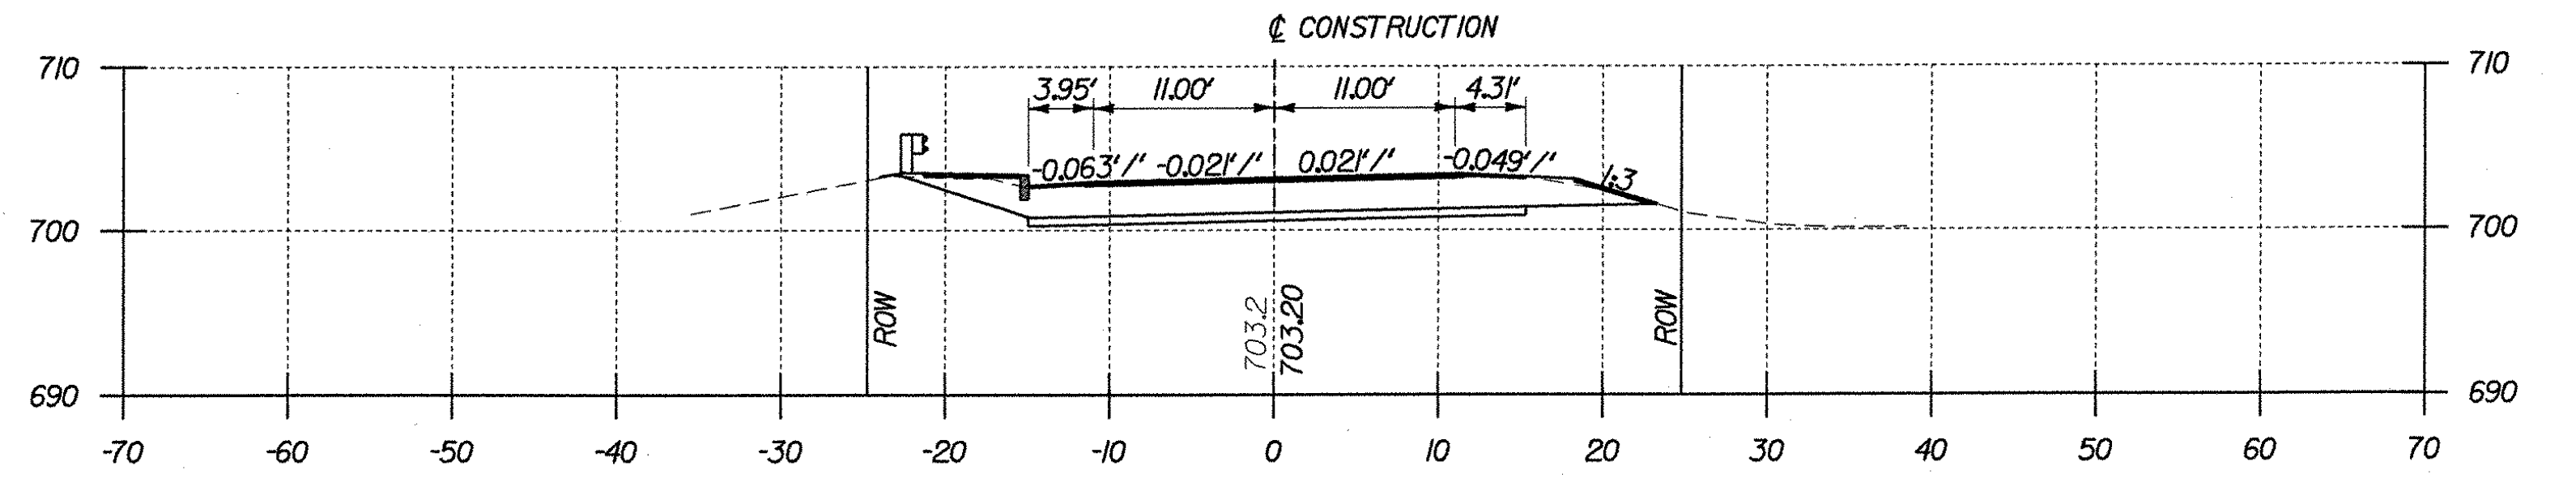


103+20

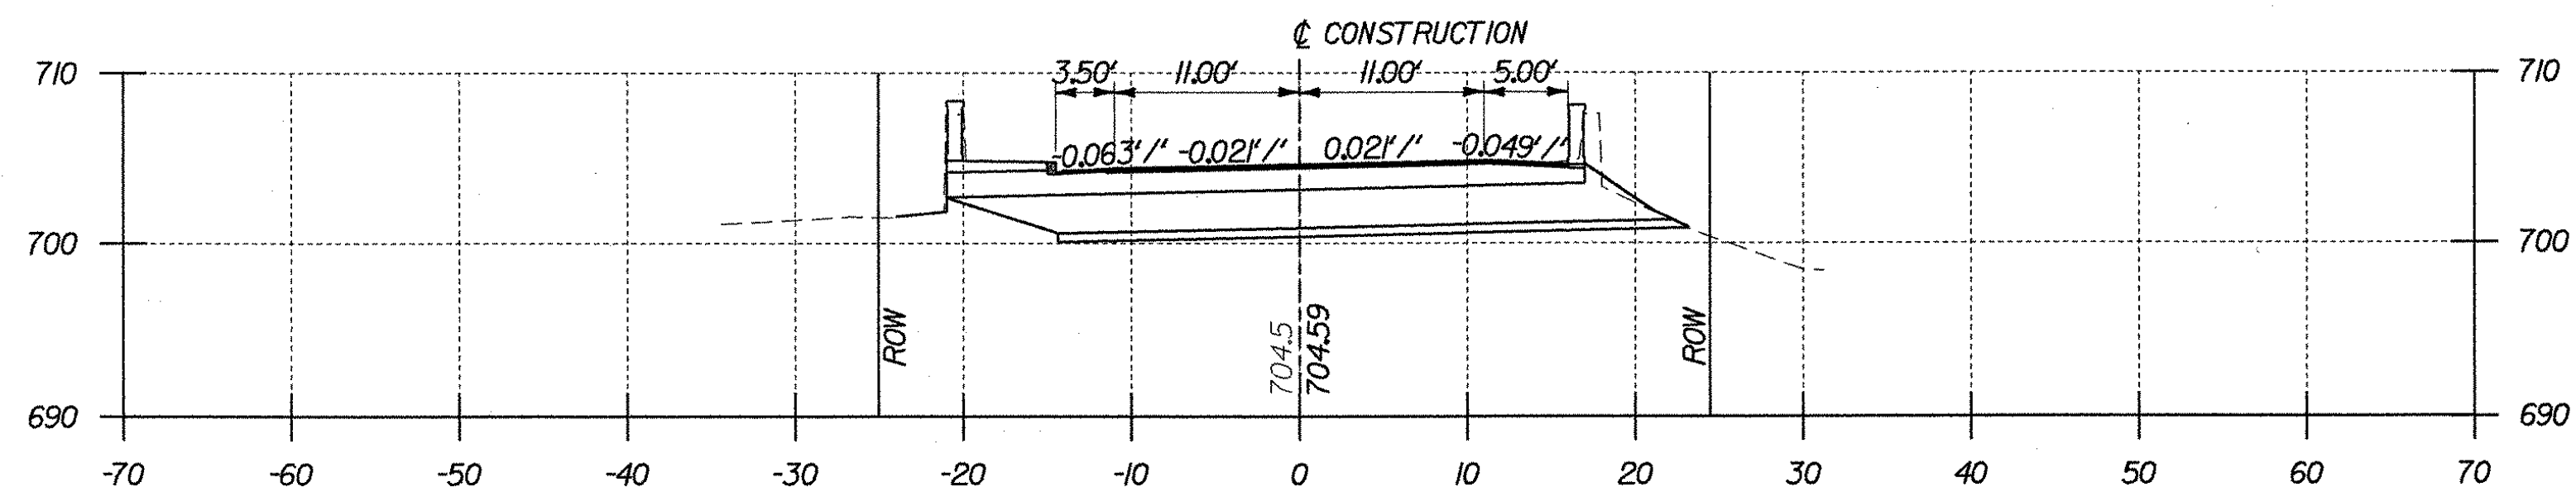

102+80

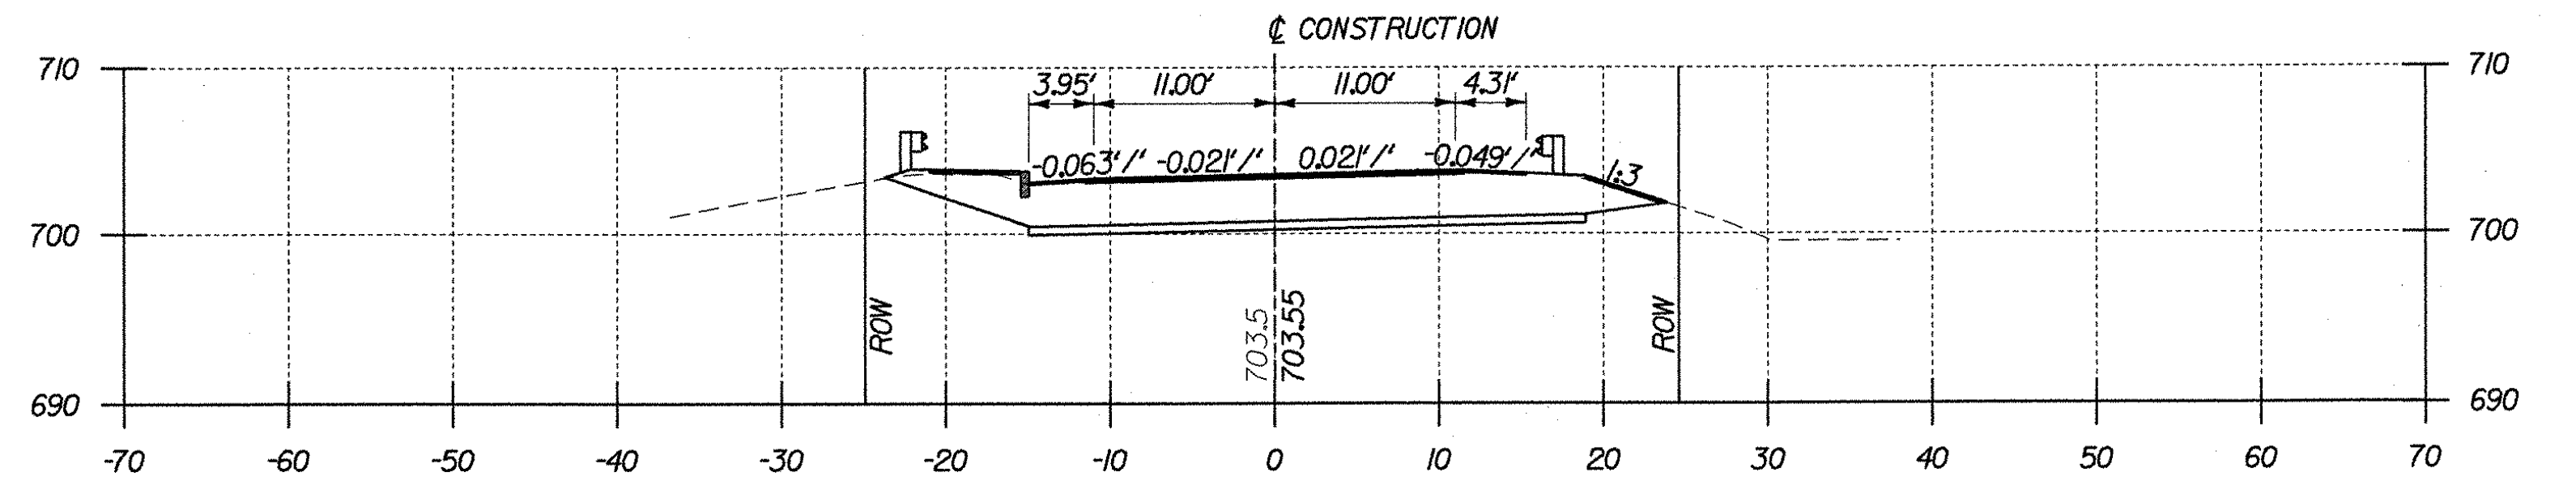

103+10

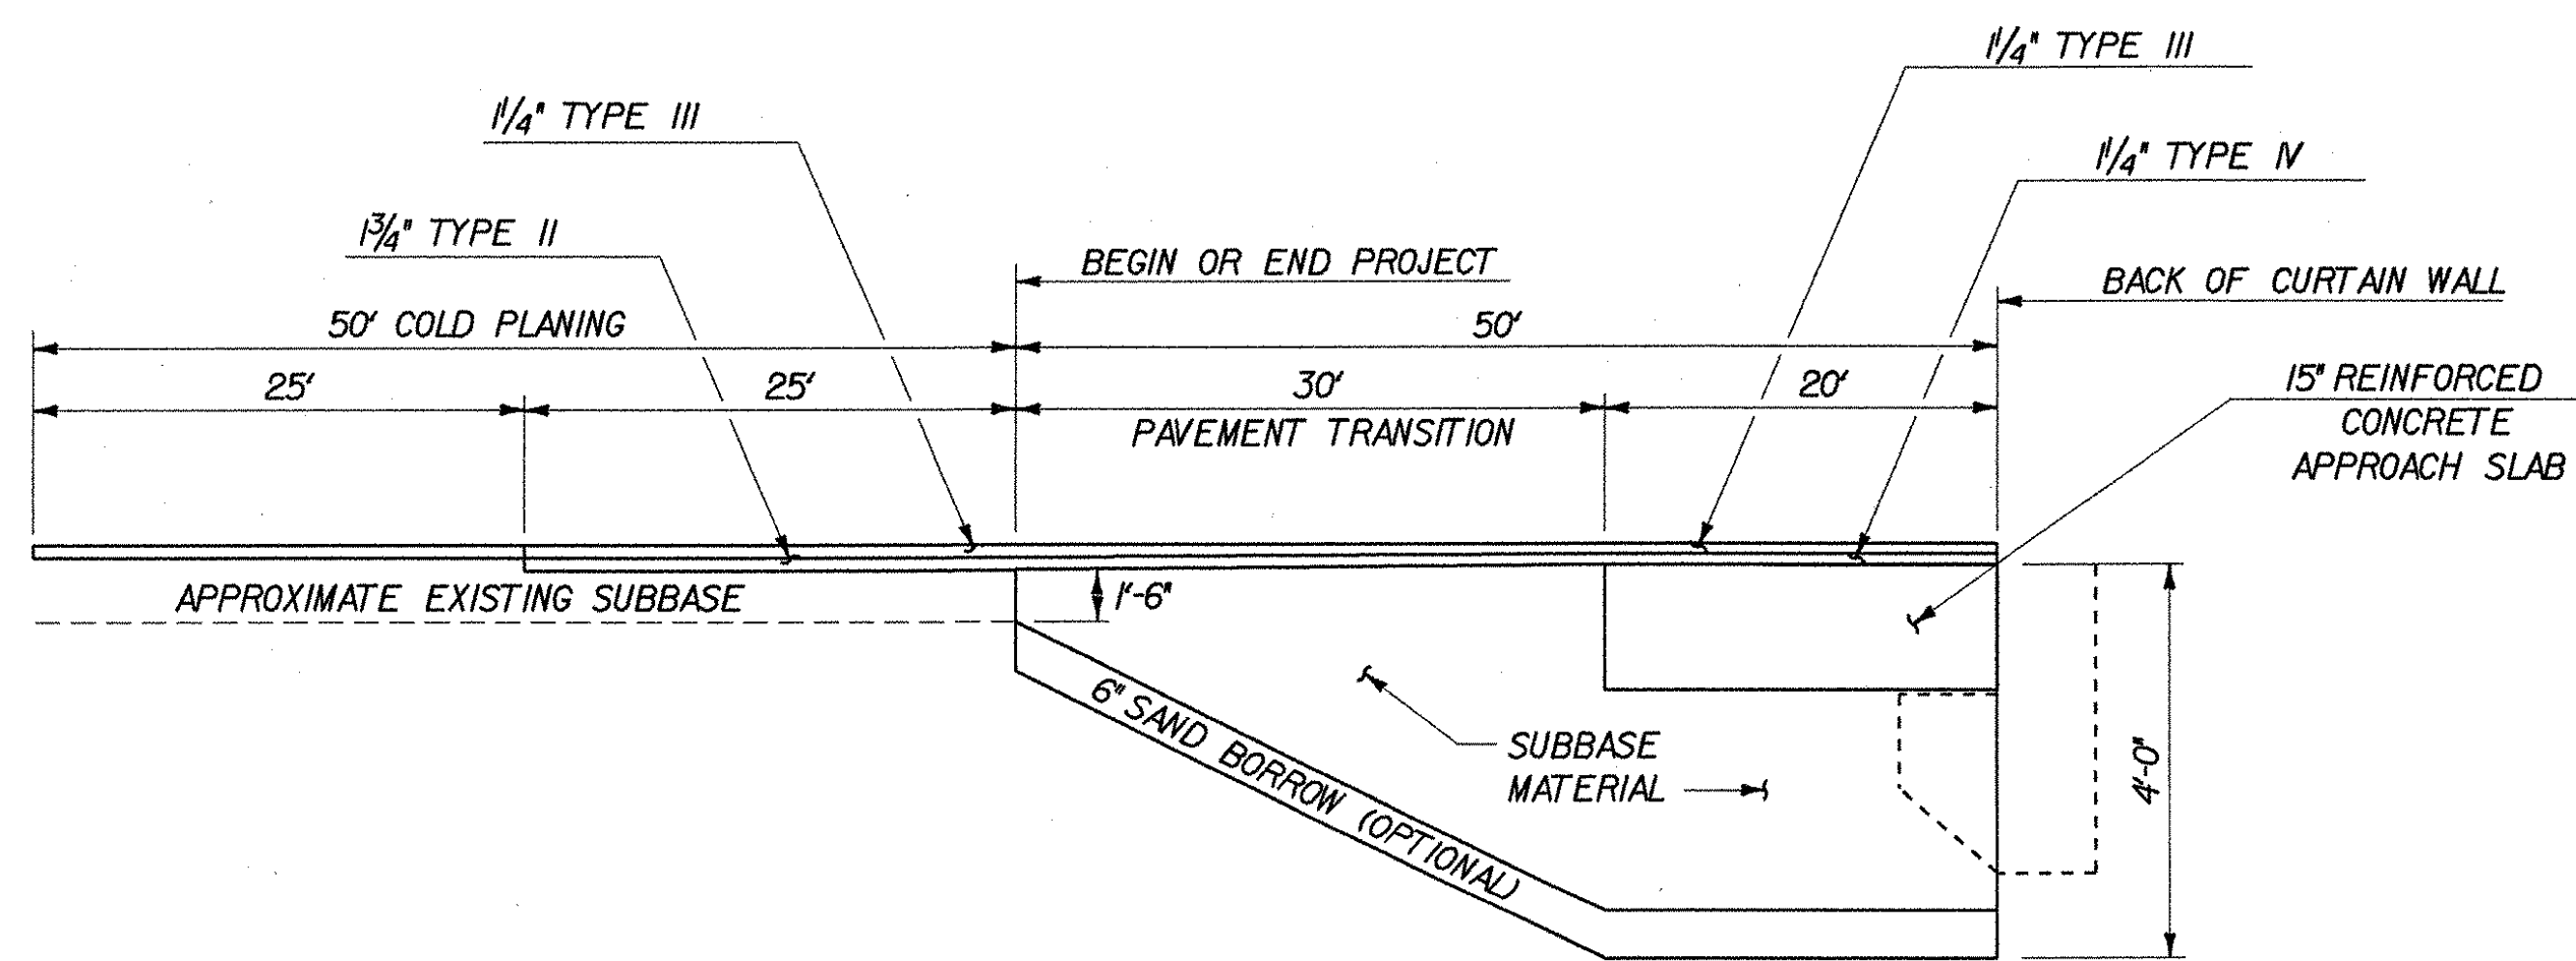

TRANSITION AT PROJECT LIMITS
AND SUBBASE DETAIL AT ABUTMENTS
N.T.S.

GENERAL NOTE

1. THE CONTRACTOR SHALL ENSURE FREE DRAINAGE OF THE ROADWAY SUBGRADE BEHIND THE ABUTMENTS TO THE SATISFACTION OF THE RESIDENT ENGINEER. THE RESIDENT ENGINEER WILL EXAMINE THE EXCAVATION TO DETERMINE IF THE EXISTING MATERIALS ALLOW ADEQUATE DRAINAGE OR IF A TRENCH FROM THE ABUTMENT TO A SIDESLOPE IS REQUIRED.

**STATE OF VERMONT
AGENCY OF TRANSPORTATION**

Town Of	LYNDON	Bridge No.	2
Highway No.	ALT VT 122	Log Sta.	
CENTER STREET OVER PASSUMPSIC RIVER		Surv. Sta.	
ROADWAY SECTIONS - 2			
Designed By	T. GRANT	Drawn By	S. DELIA
Checked By	T. GRANT	Bridge Design Supervisor	M. ZYDEL
Date	10/01	Date	10/01
PROJECT	LYNDON	PROJECT NO.	BHO 1447(26)
I.G.C. Info.	m:\549103\6cont\2\238sec.dgn		
Bridge Sheet No.	Sheet 34 of 34		

