


TEMPORARY AND DURABLE 4'' WHITE LINE
 STA. 114+00 TO STA. 129+00 SOLID LT. AND RT. (EDGE LINE)
 (WITH EDGE LINE BREAK FOR SIDE ROAD)
 STA. 124+00 TO STA. 129+00 DASHED RT. (PASSING LANE)

TEMPORARY AND DURABLE 4'' YELLOW LINE
 STA. 114+00 TO STA. 129+00 SOLID LT. AND RT.
 (WITH CENTERLINE BREAK FOR SIDE ROAD)
 STA. 120+07 LT. (COOK ROAD)

TEMPORARY AND DURABLE LETTER OR SYMBOL
 STA. 120+07 LT. 'STOP' (COOK ROAD)

TEMPORARY AND DURABLE 24'' STOP BAR
 STA. 120+07 LT. (COOK ROAD)

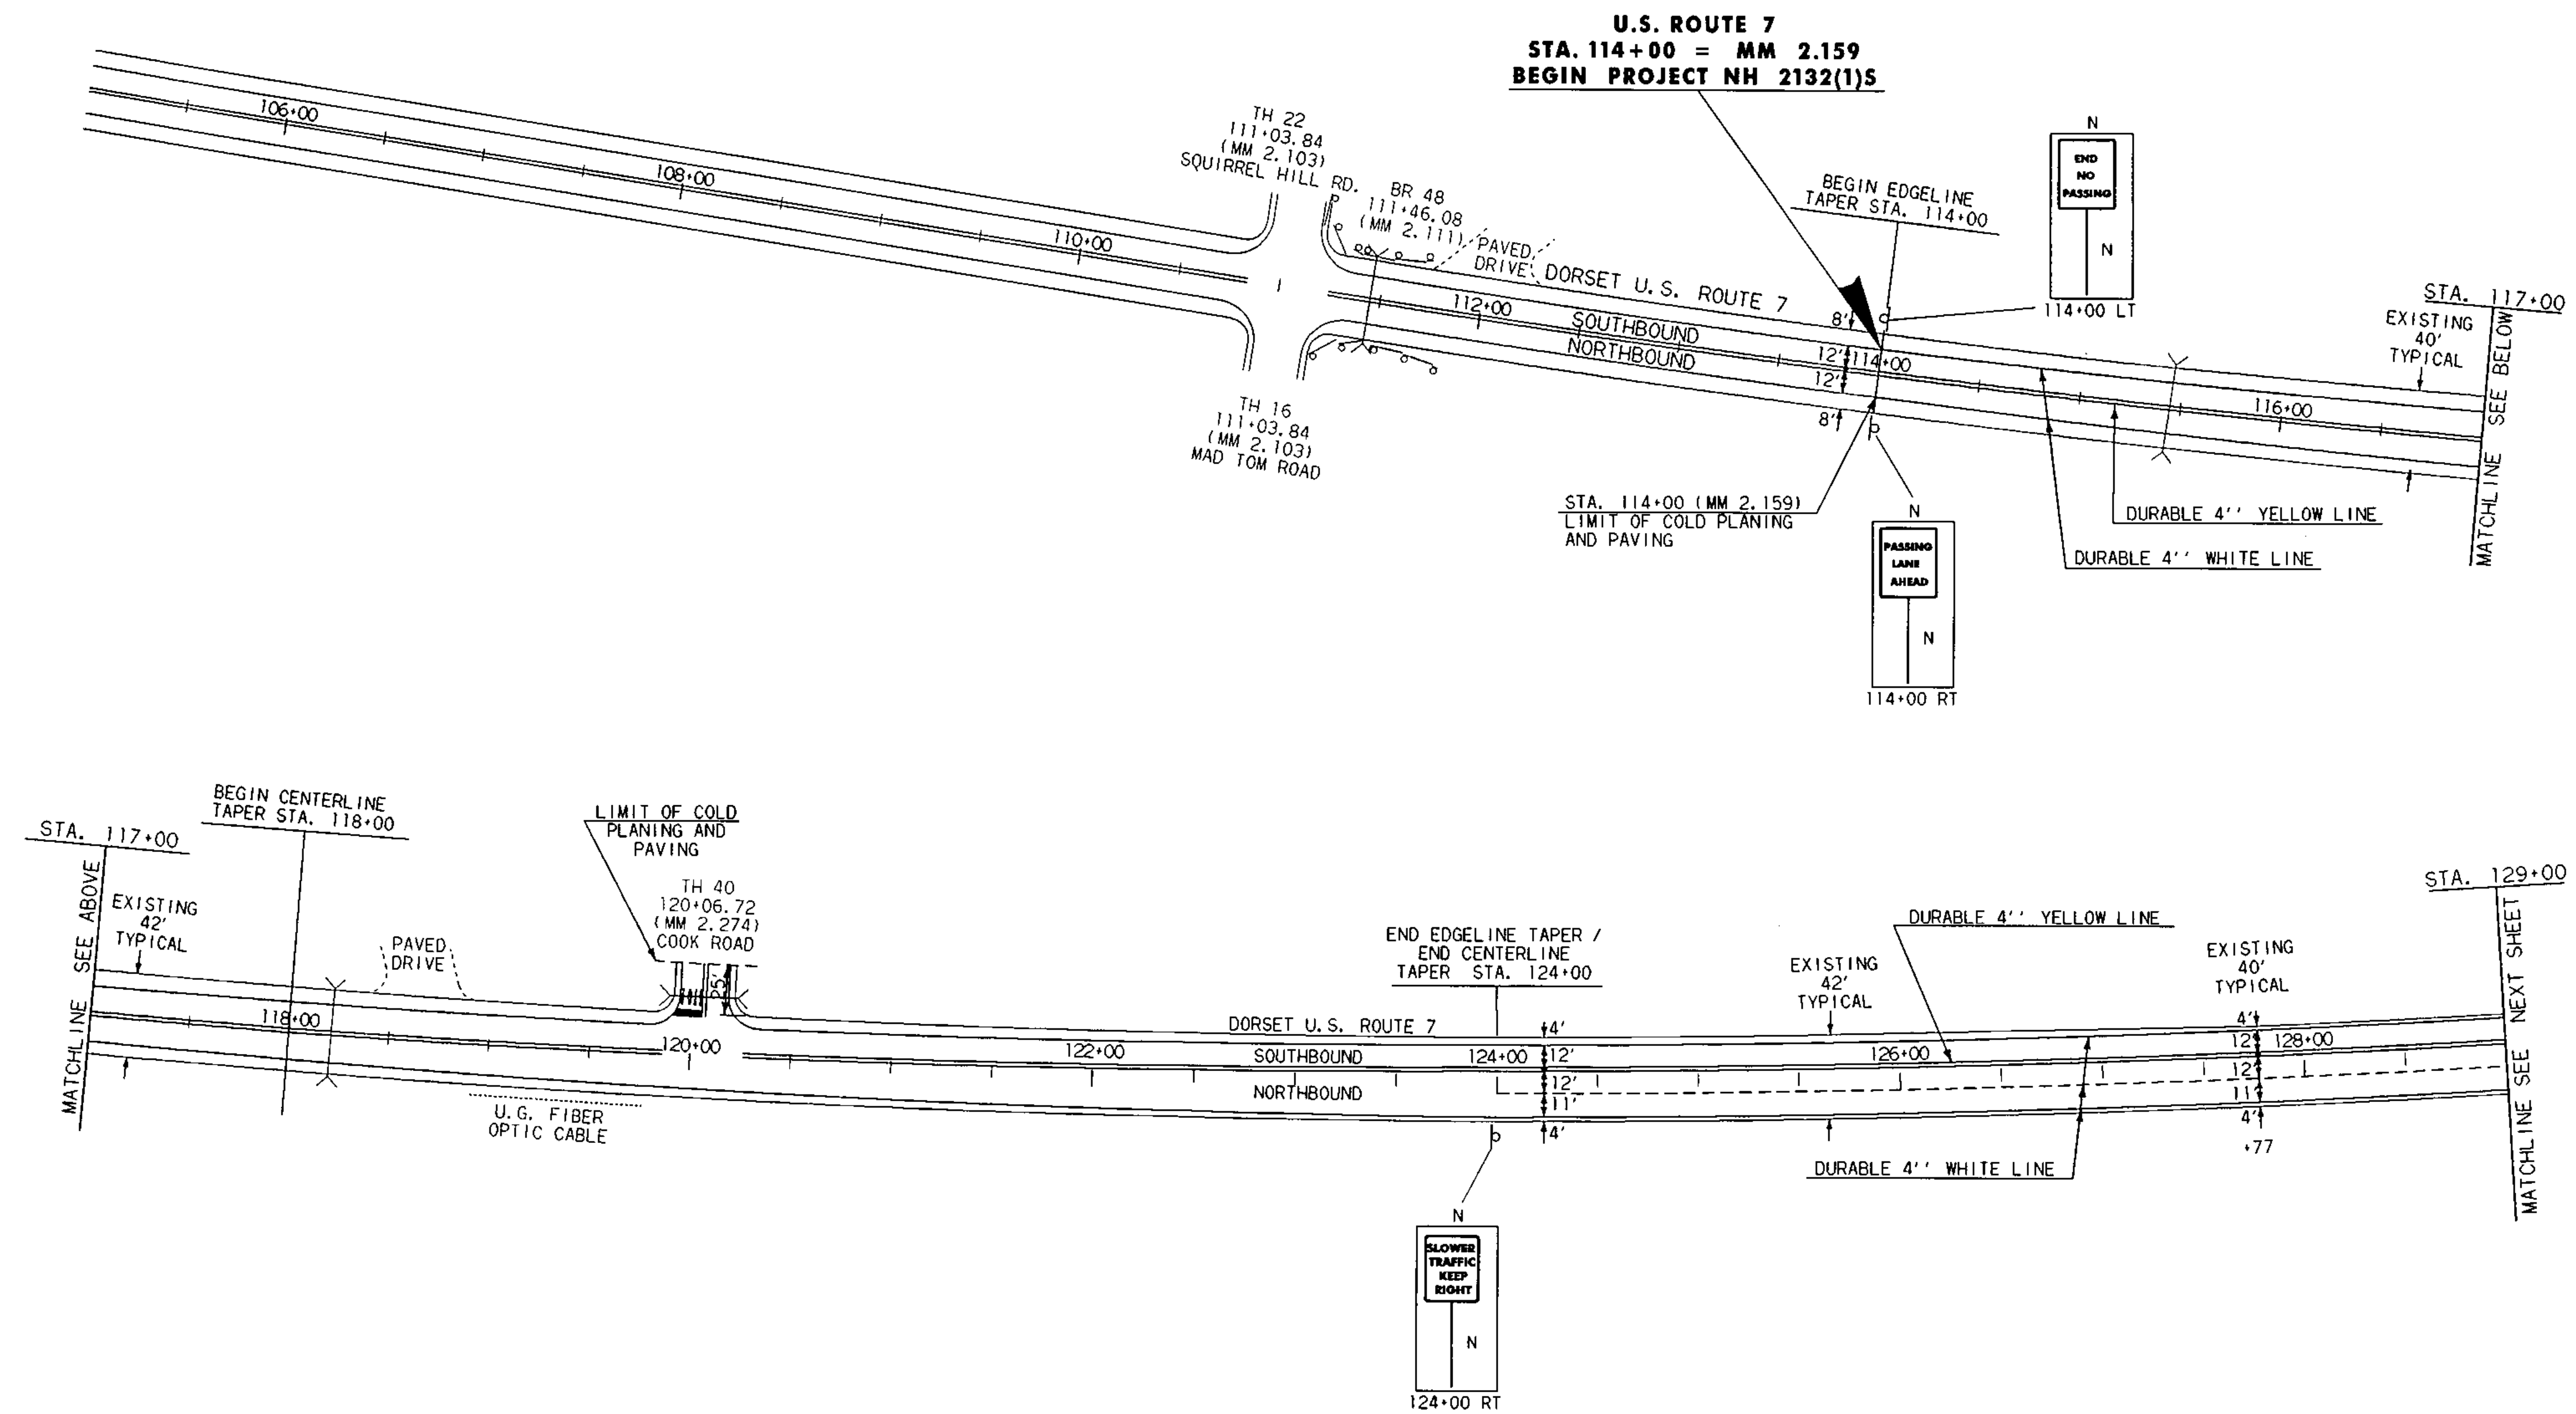

DATUM	
VERTICAL	N/A
HORIZONTAL	N/A

LEGEND
 N = NEW
 R = REMOVE
 R&S = REMOVE AND SALVAGE
 S = SALVAGE SIGN
 RET = RETAIN
 B - B = BACK TO BACK

PAVING PROJECT LAYOUT	PROJECT:	DORSET-MT TABOR-DANBY	PROJECT NO.:	NH 2132 (1) S
	DESIGN FILE NAME:	/pave/93b080a/pb080.dgn	PLOT DATE:	13-AUG-1999
	IPARM FILE NAME:	pb080i01.i	SURVEY DATE:	N/A
	SURVEYED BY:	N/A	DRAWN BY:	SJL
	SQUAD LEADER:	JAV	SHEET:	7 OF 19