

TEMPORARY AND DURABLE 4" WHITE LINE
 STA. 108+00 TO STA. 132+00 SOLID LT. AND RT. (EDGE LINE)
 STA. 111+00 TO STA. 132+00 DASHED LT. (PASSING LANE)

TEMPORARY AND DURABLE 4" YELLOW LINE
 STA. 108+00 TO STA. 132+00 SOLID LT. AND RT.

STEEL BEAM GUARD RAIL
 STA. 115+53 TO STA. 115+78 RT.
 STA. 125+04 TO STA. 125+29 LT.
 STA. 125+04 TO STA. 125+29 RT.

REMOVAL AND DISPOSAL OF GUARD RAIL

STA. 114+75 TO STA. 115+12.5 LT.
 STA. 115+53 TO STA. 115+78 RT.
 STA. 115+62.5 TO STA. 116+00 LT.
 STA. 114+90.5 TO STA. 115+28 RT.
 STA. 116+03 TO STA. 116+40.5 RT.
 STA. 124+41.5 TO STA. 124+79 LT.
 STA. 125+04 TO STA. 125+29 LT.
 STA. 125+04 TO STA. 125+29 RT.
 STA. 125+54 TO STA. 125+91.5 LT.
 STA. 124+41.5 TO STA. 124+79 RT.
 STA. 125+54 TO STA. 125+91.5 RT.

MANUFACTURED TERMINAL SECTION (FLARED)

STA. 114+75 TO STA. 115+12.5 LT.
 STA. 115+62.5 TO STA. 116+00 LT.
 STA. 114+90.5 TO STA. 115+28 RT.
 STA. 116+03 TO STA. 116+40.5 RT.
 STA. 124+41.5 TO STA. 124+79 LT.
 STA. 125+54 TO STA. 125+91.5 LT.
 STA. 124+41.5 TO STA. 124+79 RT.
 STA. 125+54 TO STA. 125+91.5 RT.

REMOVE AND RESET GUARD RAIL


STA. 115+12.5 TO STA. 115+62.5 LT.
 STA. 115+28 TO STA. 115+53 RT.
 STA. 115+78 TO STA. 116+03 RT.
 STA. 124+79 TO STA. 125+04 LT.
 STA. 124+79 TO STA. 125+04 RT.
 STA. 125+29 TO STA. 125+54 LT.
 STA. 125+29 TO STA. 125+54 RT.

REMOVING SIGNS

6 -- AS SHOWN

ERECTING SALVAGED SIGNS

6 -- AS SHOWN

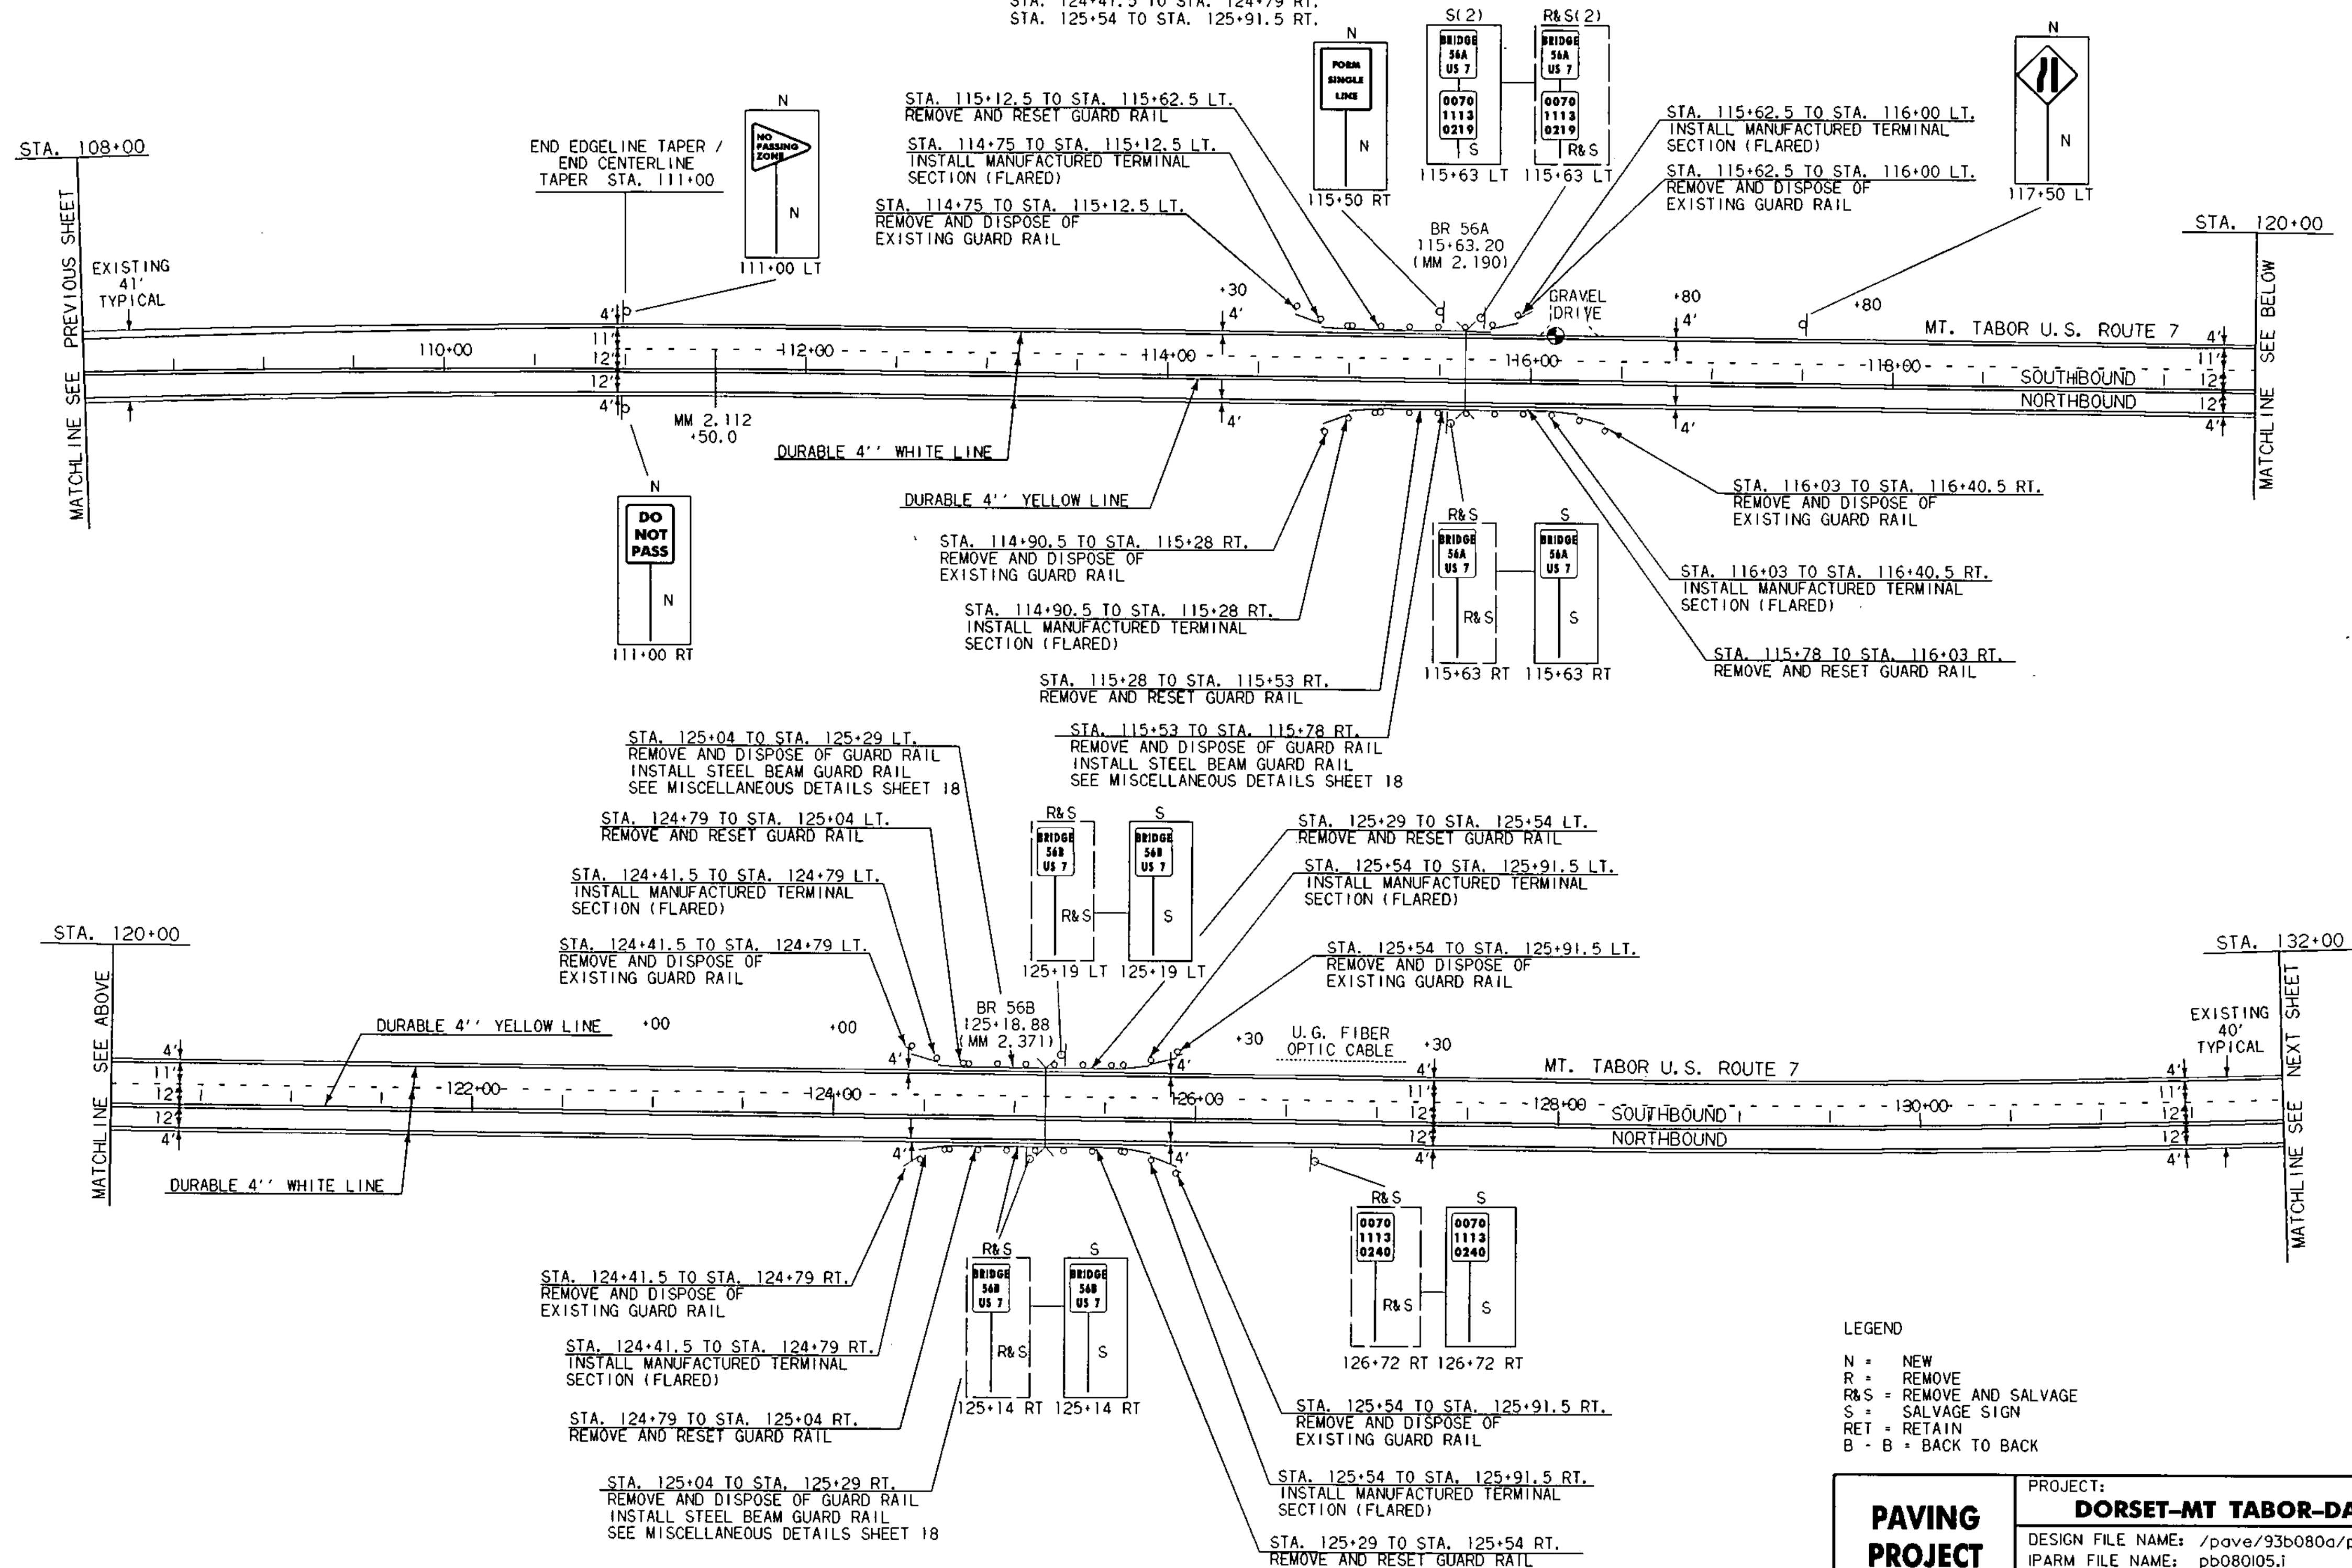

LEGEND
 N = NEW
 R = REMOVE
 R&S = REMOVE AND SALVAGE
 S = SALVAGE SIGN
 RET = RETAIN
 B = BACK TO BACK

DATUM	
VERTICAL	N/A
HORIZONTAL	N/A

PAVING PROJECT LAYOUT	PROJECT: DORSET-MT TABOR-DANBY	PROJECT NO.: NH 2132 (1) S
	DESIGN FILE NAME: /pave/93b080a/pb080.dgn	PLOT DATE: 13-AUG-1999
	IPARM FILE NAME: pb080i05.1	SURVEY DATE: N/A
	SURVEYED BY: N/A	DRAWN BY: SJL
	SQUAD LEADER: JAV	SHEET: 11 OF 19