

621.20 STEEL BEAM GUARDRAIL, GALVANIZED  
 STA. 121+50.00 RT - 122+18.50 RT  
 STA. 121+50.00 LT - 122+26.78 LT

621.50 MANUFACTURED TERMINAL SECTION, FLARED  
 STA. 122+18.50 RT - STA. 122+56.00 RT  
 STA. 122+26.78 LT - STA. 122+64.28 LT

621.80 REMOVAL AND DISPOSAL OF GUARDRAIL  
 STA. 121+50.00 RT - STA. 122+59.53 RT  
 STA. 121+50.00 LT - STA. 122+64.28 LT


646.402 DURABLE 4" WHITE LINE, THERMOPLASTIC  
 STA. 121+50 - STA. 137+50 (SOLID LT AND RT)  
 STA. 134+00 - STA. 136+00 (DOTTED RT)  
 STA. 136+00 - STA. 137+50 (SOLID RT)  
 (WITH EDGELINE BREAKS FOR TOWN ROADS)

646.412 DURABLE 4" YELLOW LINE, THERMOPLASTIC  
 STA. 121+50 - STA. 127+00 (SOLID RT AND DASHED LT)  
 STA. 127+00 - STA. 129+00 (SOLID LT AND RT)  
 STA. 129+00 - STA. 136+00 (SOLID LT AND RT)  
 STA. 136+00 - STA. 137+50 (SOLID LT AND RT)  
 (WITH CENTERLINE BREAKS FOR TOWN ROADS)


646.452 DURABLE 8" YELLOW LINE, THERMOPLASTIC  
 STA. 129+00 - STA. 130+16 (SOLID DIAGONALS)  
 STA. 130+61 - STA. 136+00 (SOLID DIAGONALS)

646.482 DURABLE 24" STOP BAR, THERMOPLASTIC  
 STA. 130+15 LT - STA. 130+30 LT (WIGHTMAN RD)

646.492 DURABLE LETTER OR SYMBOL, THERMOPLASTIC  
 STA. 130+23 LT "STOP" (WIGHTMAN RD.)  
 STA. 136+11 "ARROW"  
 STA. 136+61 "ONLY"  
 STA. 137+11 "ARROW"

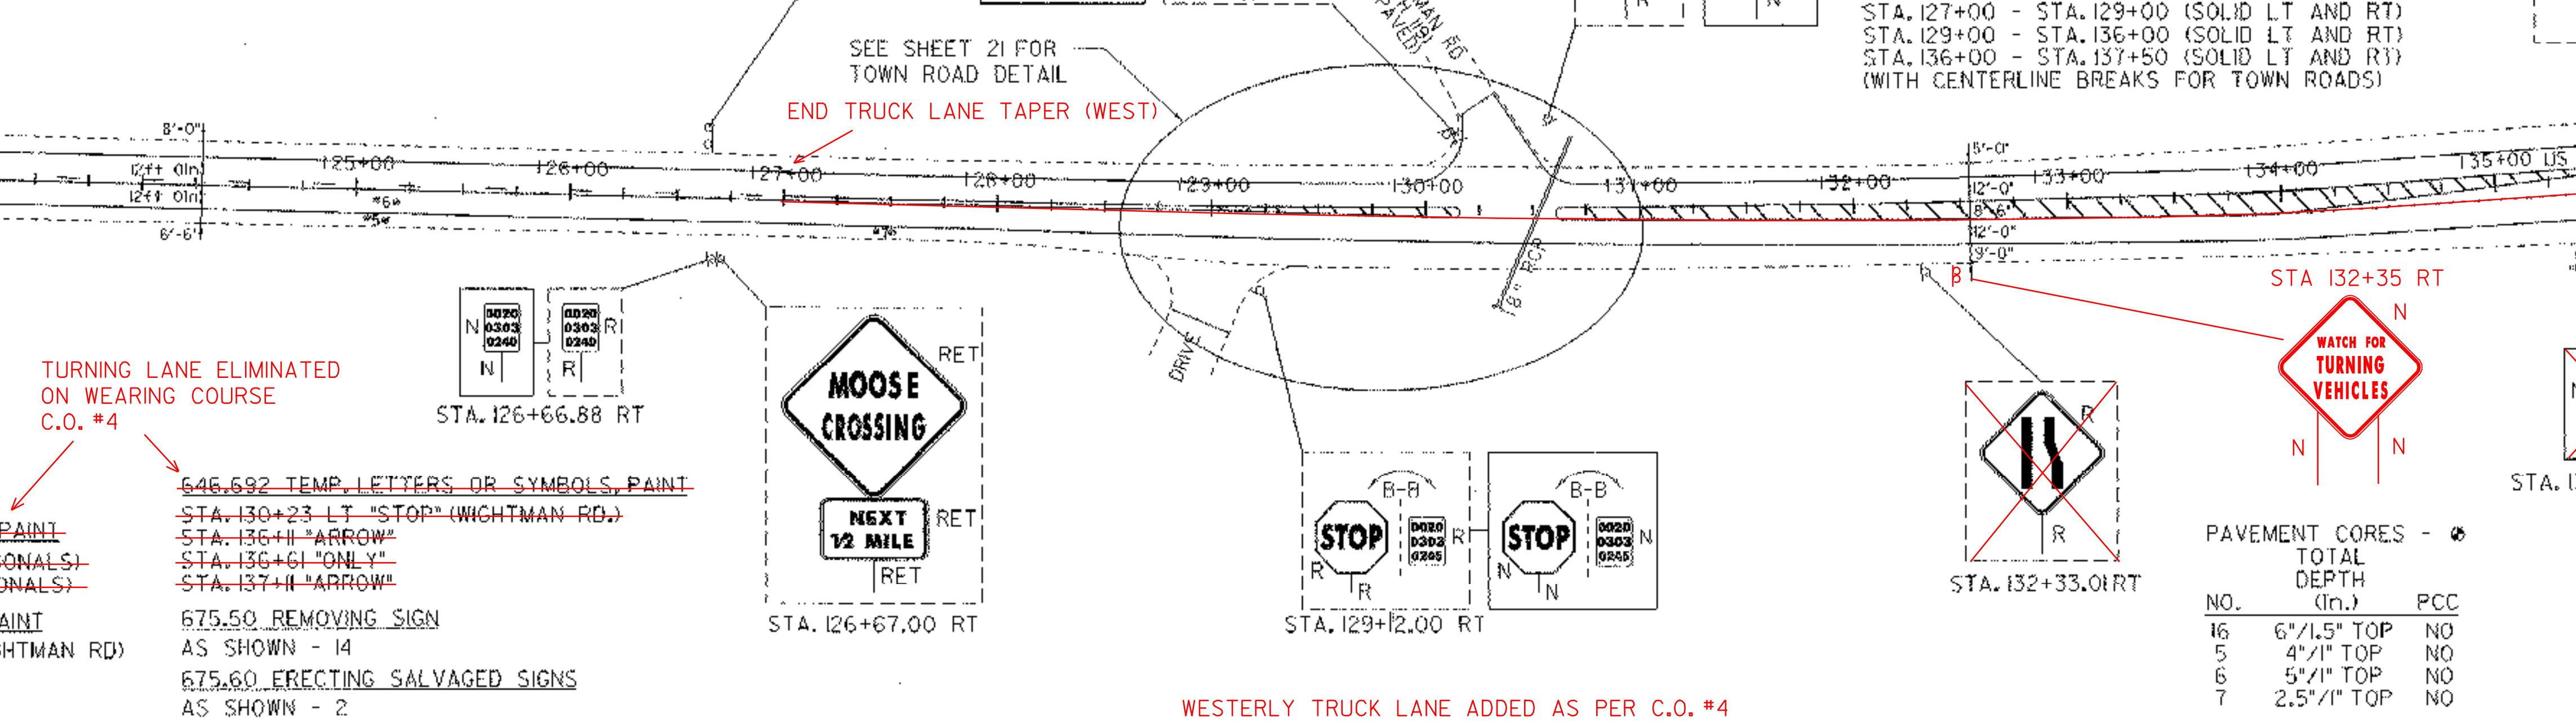

WESTERLY TRUCK LANE ADDED AS PER C.O. #4  
 127+00 TO 146+50 LT

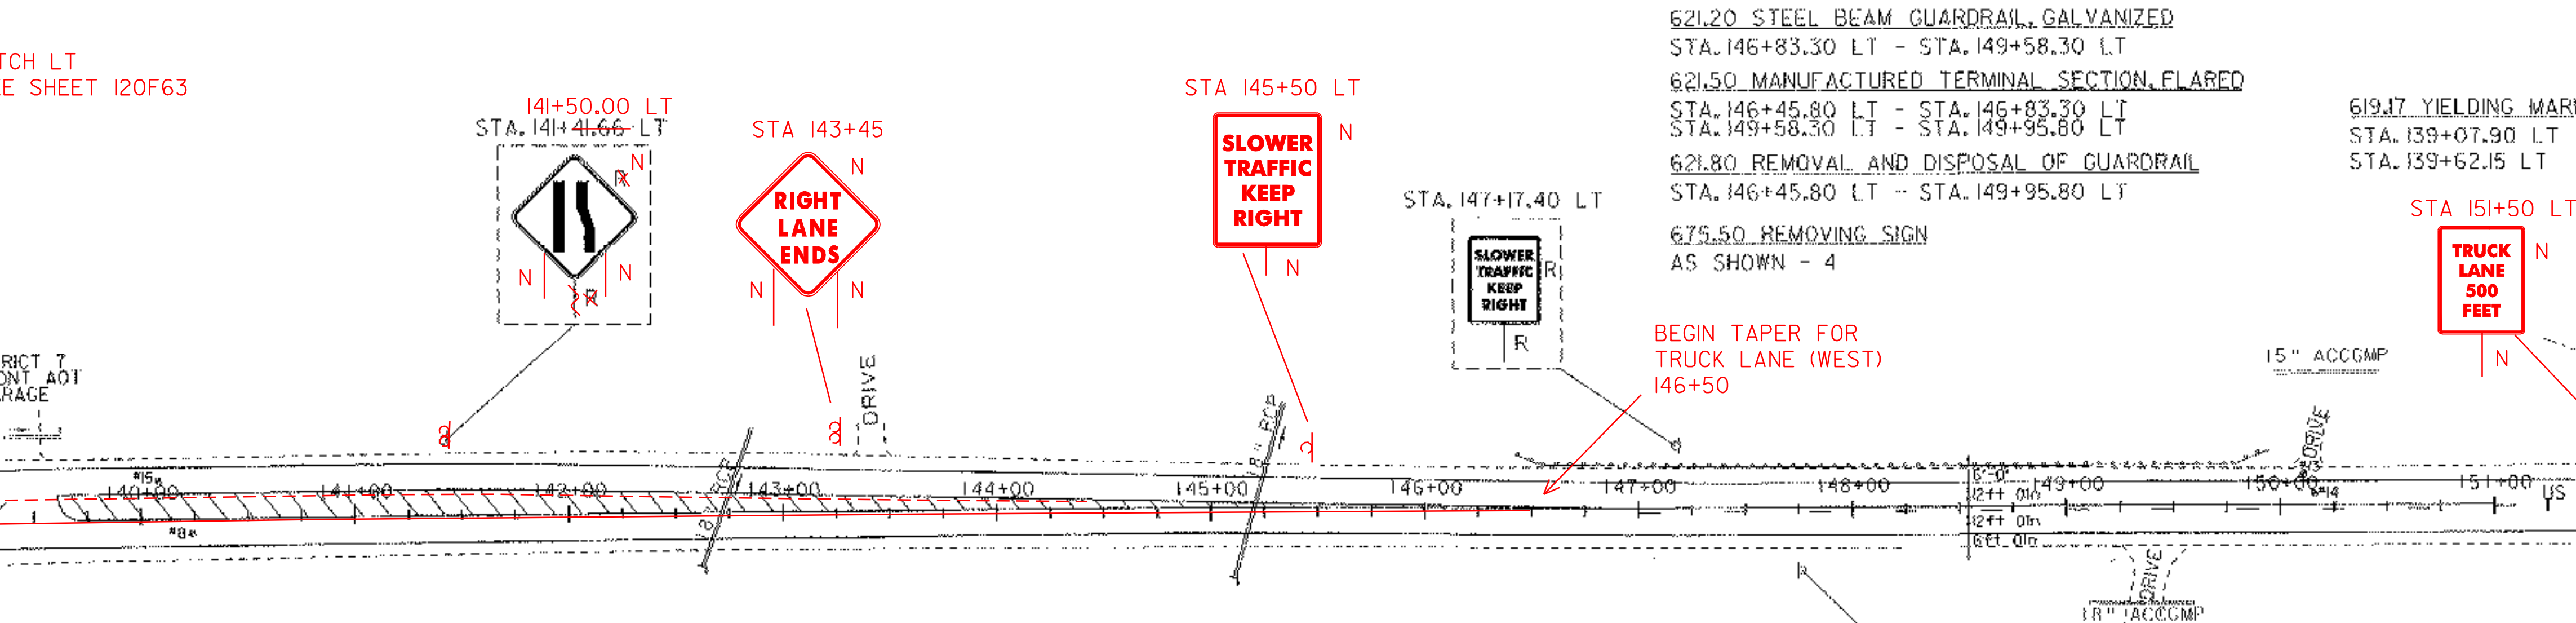

646.402 DURABLE 4" WHITE LINE, THERMOPLASTIC  
 STA. 137+50 - STA. 153+50 (SOLID LT AND RT)  
 STA. 137+50 - STA. 139+37 (SOLID RT)

646.412 DURABLE 4" YELLOW LINE, THERMOPLASTIC  
 STA. 137+50 - STA. 139+21 (SOLID LT AND RT)  
 STA. 139+60 - STA. 147+00 (SOLID LT AND RT)  
 STA. 147+00 - STA. 151+00 (SOLID LT, DASHED RT)  
 STA. 151+00 - STA. 153+50 (DASHED CENTER)

646.492 DURABLE LETTER OR SYMBOL, THERMOPLASTIC  
 STA. 137+66 "ONLY"  
 STA. 138+09 "ARROW"  
 STA. 138+71 "ONLY"  
 STA. 139+11 "ARROW"

646.602 TEMPORARY 4" WHITE LINE, PAINT  
 STA. 137+50 - STA. 153+50 (SOLID LT AND RT)  
 STA. 137+50 - STA. 139+37 (SOLID RT)

646.612 TEMPORARY 4" YELLOW LINE, PAINT  
 STA. 137+50 - STA. 139+21 (SOLID LT AND RT)  
 STA. 139+60 - STA. 147+00 (SOLID LT AND RT)  
 STA. 147+00 - STA. 151+00 (SOLID LT, DASHED RT)  
 STA. 151+00 - STA. 153+50 (DASHED CENTER)

646.652 TEMPORARY 8" YELLOW LINE, PAINT  
 STA. 139+60 - STA. 147+00 (SOLID DIAGONALS)

PAVEMENT CORES -		
NO.	TOTAL DEPTH (in.)	PCC
15	5 1/2"	NO
8	5 1/2"	NO
13	1.5"	NO
14	5 1/2"	NO

DATUM  
 VERTICAL N/A  
 HORIZONTAL N/A

<b>PROJECT LAYOUT SHEET 2</b>	PROJECT NAME: DANVILLE	PLOT DATE: 12-JAN-2007
	PROJECT NUMBER: NH 2205 (1)S	DRAWN BY: SJB
	FILE NAME: pave/99b162/99b162	CHECKED BY: EPD
	DESIGNED BY: JDA	SHEET 14 OF 63

