

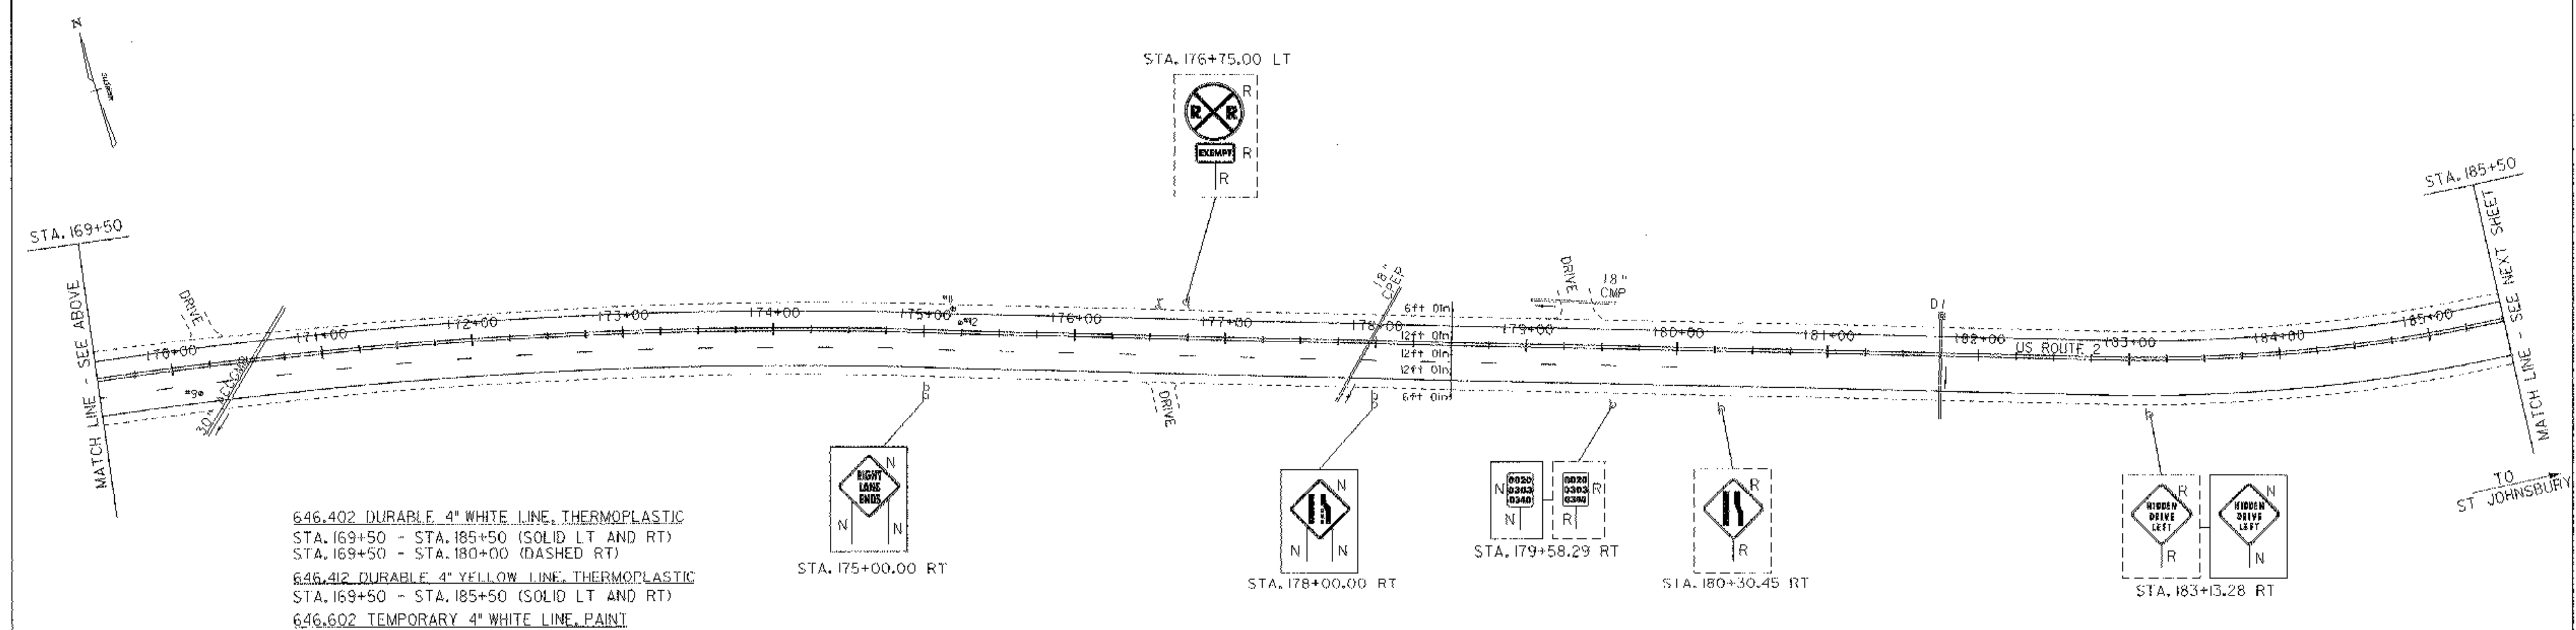


TRUCK LANE ADDED (WESTERLY LANE) AS PER C.O. #4
127+00 TO 146+50 LT

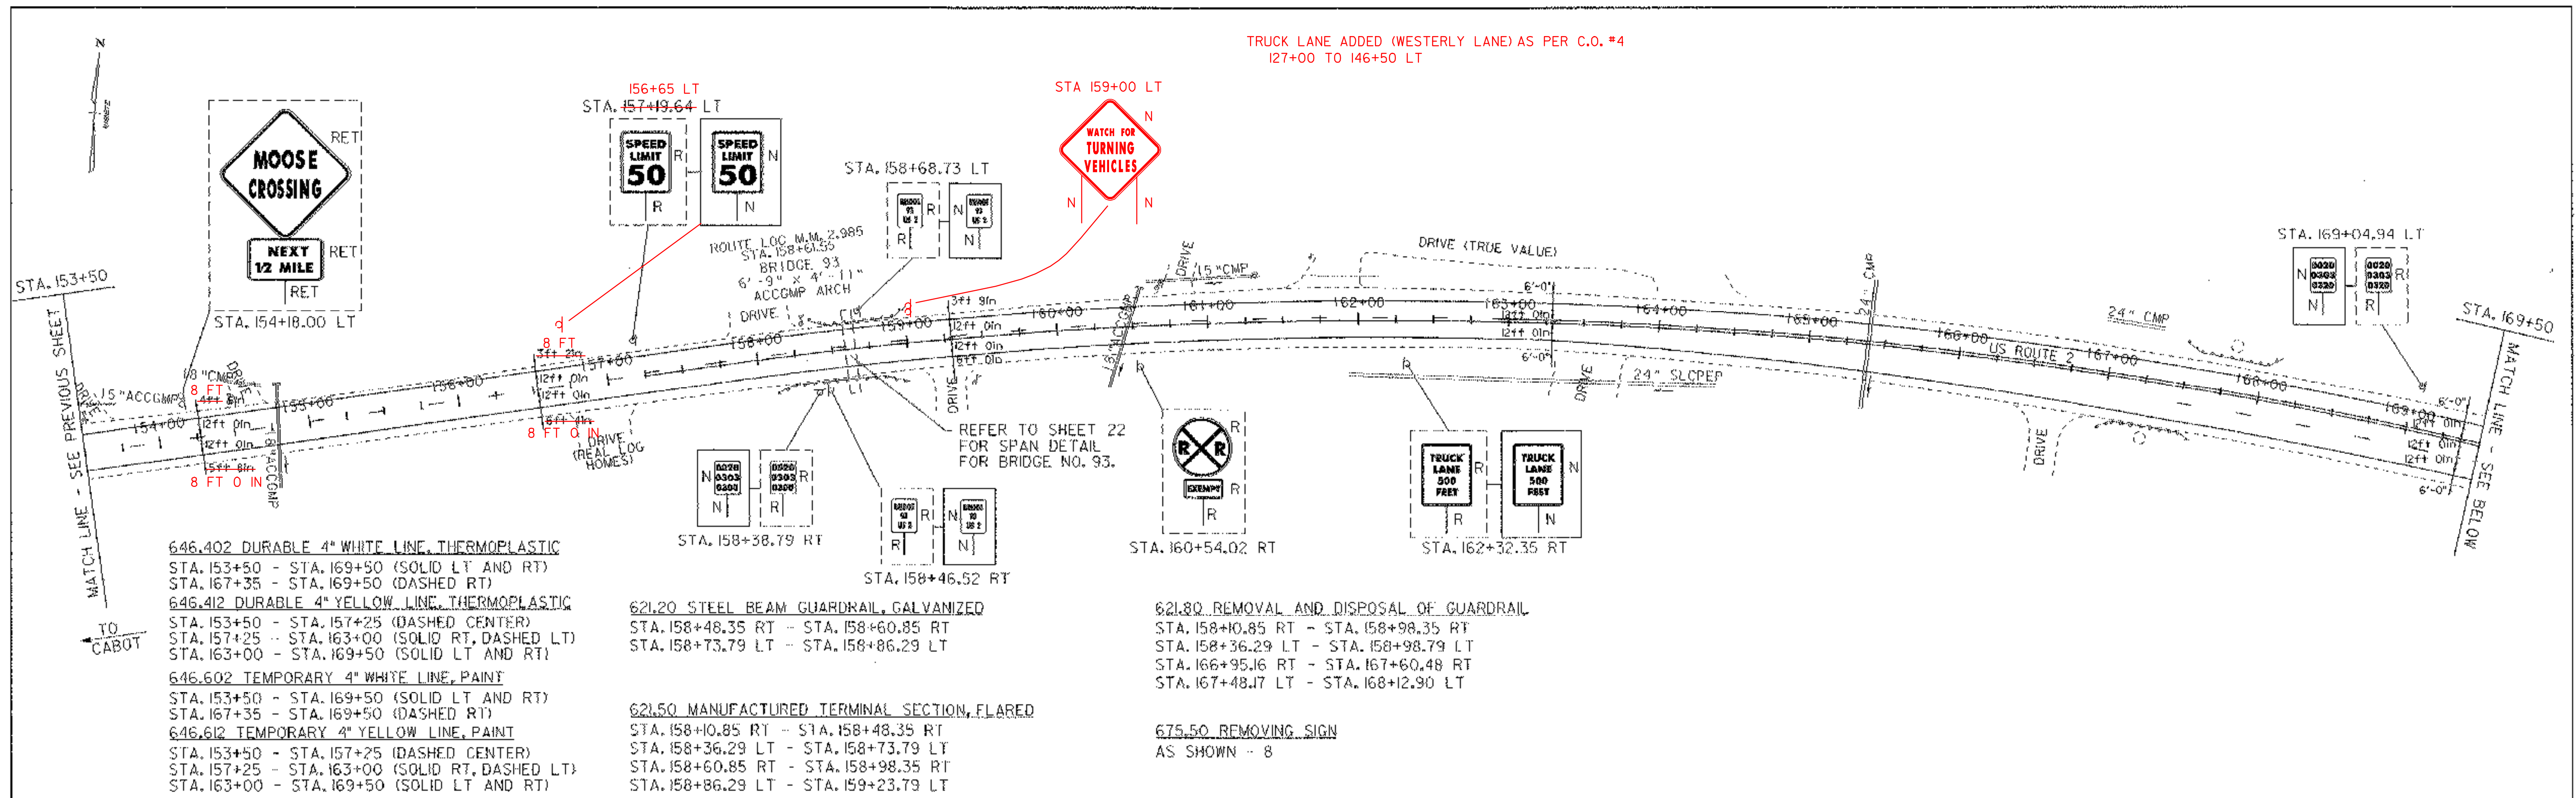

DATUM

VERTICAL	N/A
HORIZONTAL	N/A

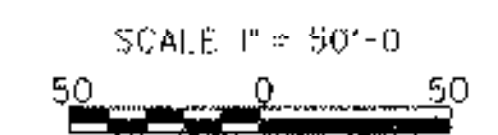

PROJECT LAYOUT SHEET 3	PROJECT NAME: DANVILLE	PLOT DATE: 12-JAN-2007
	PROJECT NUMBER: NH 2205 (1)S	DRAWN BY: SJB
	FILE NAME: pave/99b162/99b162	CHECKED BY: EPD
	DESIGNED BY: JDA	SHEET 15 OF 63