


616.47 BITUMINOUS CONCRETE GUTTERS AND TRAFFIC ISLANDS
 STA. 273+80 - STA. 274+37 LT
 STA. 284+29 - STA. 284+60 LT
 621.50 MANUFACTURED TERMINAL SECTION, FLARED
 STA. 274+97.49 LT - STA. 275+34.99 LT
 STA. 278+84.99 LT - STA. 279+22.49 LT
 STA. 286+02.13 RT - STA. 286+39.63 RT
 621.80 REMOVAL AND DISPOSAL OF GUARDRAIL
 STA. 274+97.49 LT - STA. 275+34.99 LT
 STA. 278+84.99 LT - STA. 279+22.49 LT
 STA. 286+02.13 RT - STA. 286+39.63 RT
 646.402 DURABLE 4" WHITE LINE, THERMOPLASTIC
 STA. 272+50 - STA. 287+50 (SOLID LT & RT)
 STA. 274+46 - STA. 287+50 (DASHED RT)

646.412 DURABLE 4" YELLOW LINE, THERMOPLASTIC
 STA. 272+50 - STA. 287+50 (SOLID LT AND RT)
 646.602 TEMPORARY 4" WHITE LINE, PAINT
 STA. 272+50 - STA. 287+50 (SOLID LT & RT)
 STA. 274+46 - STA. 287+50 (DASHED RT)
 646.612 TEMPORARY 4" YELLOW LINE, PAINT
 STA. 272+50 - STA. 287+50 (SOLID LT AND RT)

675.50 REMOVING SIGNS
 AS SHOWN - II


621.20 STEEL BEAM GUARD RAIL, GALV.
 272.50 RT - 286.02.13 RT
 275+34.99 LT - 278+84.99 LT

621.80 REMOVAL & DISPOSAL OF GUARD RAIL
 272+50 RT - 286+02.13 RT
 275+34.99 LT - 278+84.99 LT

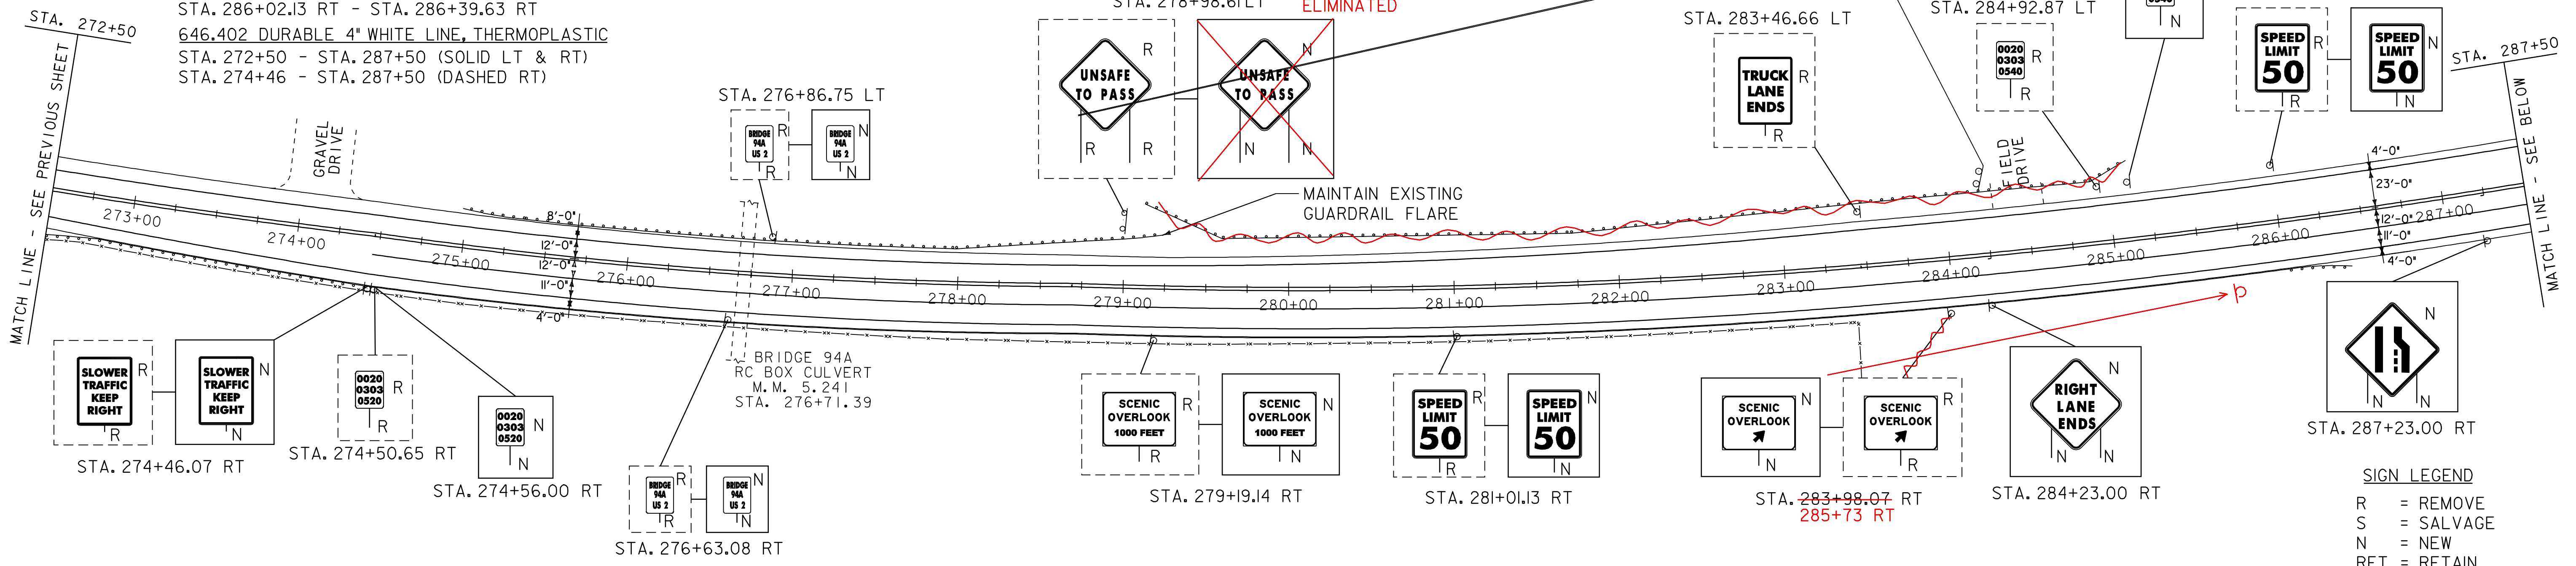

ALL STEEL GUARD RAIL IN THIS AREA REMOVED & REPLACED AS PER C.O. #1

SIGN LEGEND
 R = REMOVE
 S = SALVAGE
 N = NEW
 RET = RETAIN
 B-B = BACK TO BACK

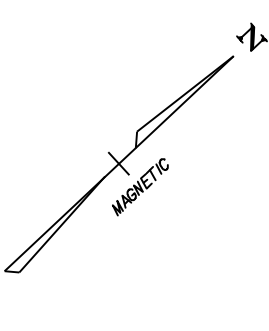


604.412 REHAB. DROP INLETS, CATCH BASINS,
 OR MANHOLES, CLASS
 STA. 293+48.77 RT
 STA. 296+00.61 RT
 STA. 297+98.39 RT
 STA. 301+48.78 RT
 616.40 REMOVING AND RESETTING CURB
 STA. 289+90.00 RT - 291+47.00 RT

616.47 BITUMINOUS CONCRETE GUTTERS AND TRAFFIC ISLANDS
 STA. 288+45 - STA. 288+84 RT
 STA. 288+95 - STA. 289+48 LT
 STA. 290+77 - STA. 291+15 LT
 STA. 293+58 - STA. 294+36 LT
 STA. 294+91 - STA. 295+38 LT
 STA. 298+14 - STA. 298+46 LT
 STA. 302+24 - STA. 302+50 LT

621.51 MANUFACTURED TERMINAL SECTION, TANGENT
 STA. 289+99.44 RT - STA. 290+36.94 RT
 621.80 REMOVAL AND DISPOSAL OF GUARDRAIL
 STA. 289+99.44 RT - STA. 290+36.94 RT

646.402 DURABLE 4" YELLOW LINE, THERMOPLASTIC
 STA. 287+50 - STA. 302+50 (SOLID LT & RT)
 STA. 287+50 - STA. 288+92 (DASHED RT)
 (WITH EDGELINE BREAKS FOR SIDE ROADS)
 646.412 DURABLE 4" YELLOW LINE, THERMOPLASTIC
 STA. 287+50 - STA. 302+50 (SOLID LT AND RT)
 (WITH CENTERLINE BREAKS FOR SIDE ROADS)
 PENNY LANE CENTERLINE
 646.426 DURABLE 6" WHITE LINE, RECESSED
 STA. 289+19 - STA. 302+50 (DASHED LT)
 646.482 DURABLE 24" STOP BAR, THERMOPLASTIC
 STA. 298+47 - STA. 298+64 RT

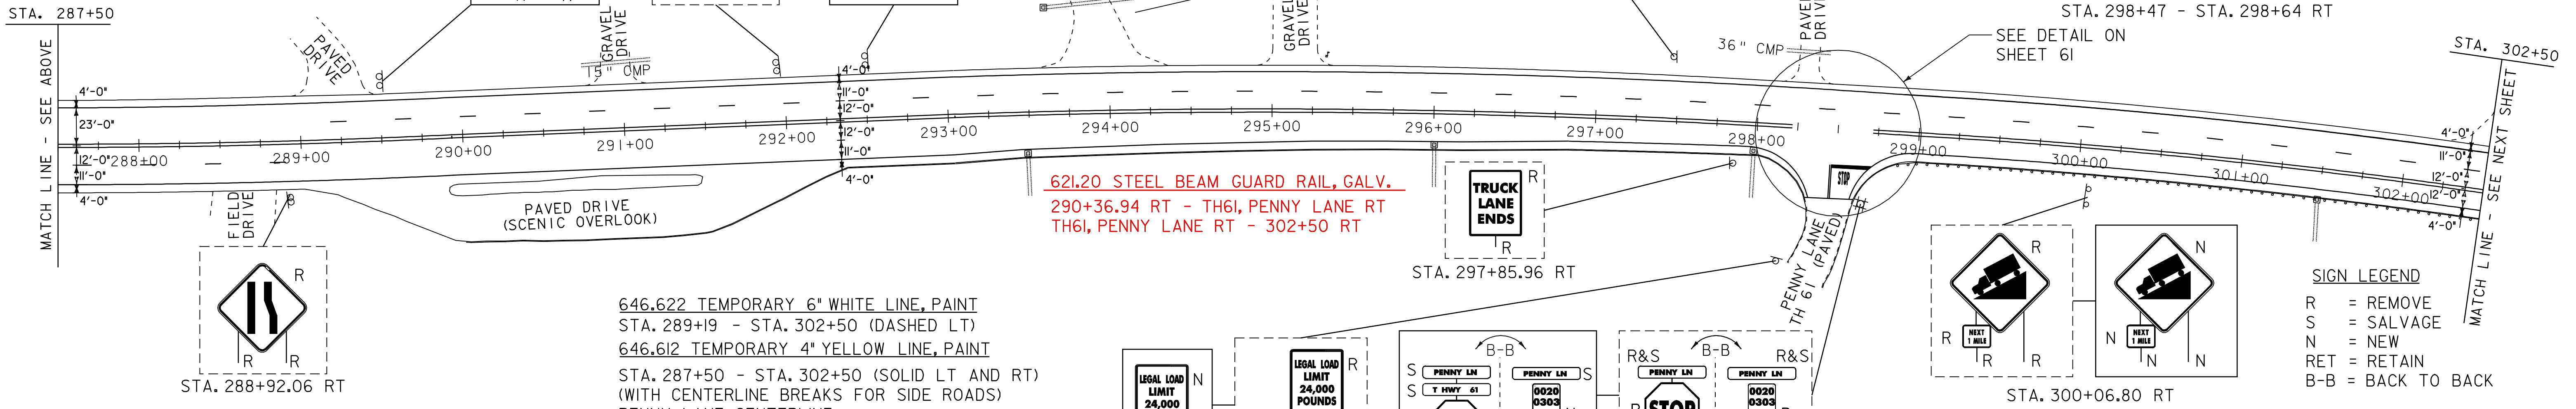

621.20 STEEL BEAM GUARD RAIL, GALV.
 290+36.94 RT - TH61, PENNY LANE RT
 TH61, PENNY LANE RT - 302+50 RT


SIGN LEGEND
 R = REMOVE
 S = SALVAGE
 N = NEW
 RET = RETAIN
 B-B = BACK TO BACK

DATUM

VERTICAL	N/A
HORIZONTAL	N/A

646.492 DURABLE LETTER OR SYMBOL, THERMOPLASTIC
 STA. 298+53 RT "STOP"
 646.602 TEMPORARY 4" WHITE LINE, PAINT
 STA. 287+50 - STA. 302+50 (SOLID LT & RT)
 STA. 287+50 - STA. 288+92 (DASHED RT)
 (WITH EDGELINE BREAKS FOR SIDE ROADS)

646.622 TEMPORARY 6" WHITE LINE, PAINT
 STA. 289+19 - STA. 302+50 (DASHED LT)
 646.612 TEMPORARY 4" YELLOW LINE, PAINT
 STA. 287+50 - STA. 302+50 (SOLID LT AND RT)
 (WITH CENTERLINE BREAKS FOR SIDE ROADS)
 PENNY LANE CENTERLINE
 646.682 TEMPORARY 24" STOP BAR, PAINT
 STA. 298+47 - STA. 298+64 RT
 646.692 TEMPORARY LETTER OR SYMBOLS, PAINT
 STA. 298+53 RT "STOP"
 675.50 REMOVING SIGNS
 AS SHOWN - I3

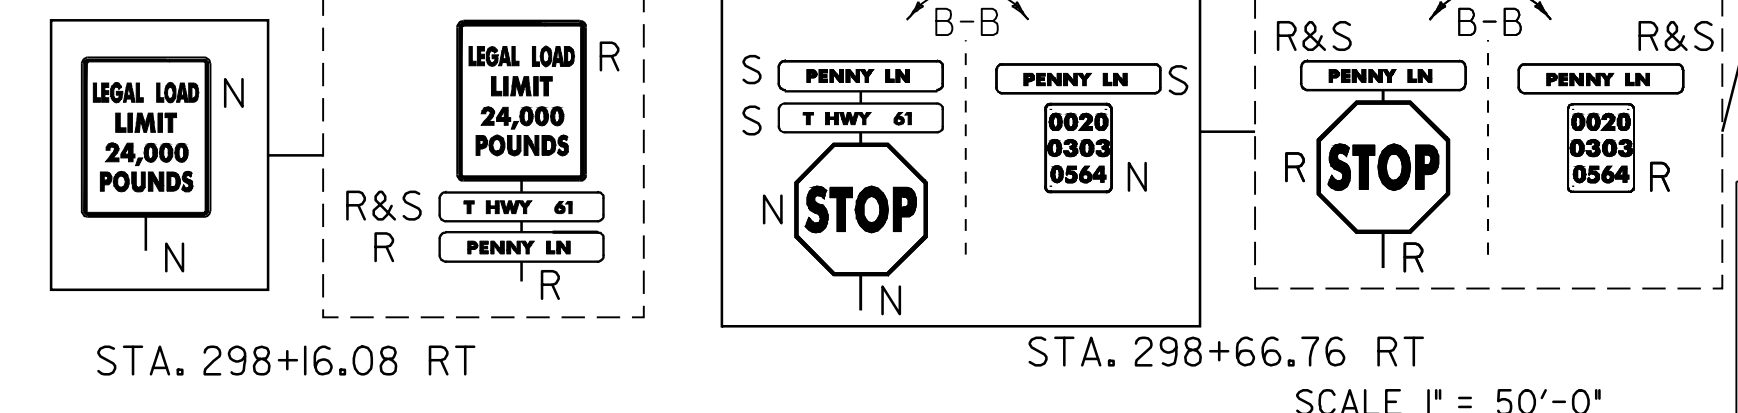

ALL STEEL BEAM GUARD RAIL IN THIS AREA REMOVED & REPLACED AS PER C.O. #1

SCALE 1" = 50'-0"
 50 0 50

PROJECT LAYOUT SHEET 2

PROJECT NAME:
 PROJECT NUMBER: NH 2501(I)S
 FILE NAME: pave/05b034/05b034
 PROJECT LEADER: EPD
 DESIGNED BY: JDA
 PLOT FILE: 05b034p02.i
 PLOT DATE: 19-JUN-2009 16:17
 DRAWN BY: JAR
 CHECKED BY: EPD
 SHEET 34 OF 63