

604.412 REHAB. DROP INLETS, CATCH BASINS,
OR MANHOLES, CLASS I

STA. 102+75 LT
616.35 TREATED TIMBER CURB
STA. 96+97 LT - STA. 102+72 LT
STA. 100+69 RT - STA. 103+50 RT

621.20 STEEL BEAM GUARD RAIL, GALVANIZED
STA. 92+70.30 LT - STA. 96+45.30 LT
STA. 96+97.45 LT - STA. 102+93.70 LT
STA. 100+69.02 RT - STA. 103+50.00 RT
STA. 102+45.00 RT - LT

621.60 ANCHOR FOR STEEL BEAM RAIL
STA. 92+70.30 LT

621.80 REMOVAL AND DISPOSAL OF GUARDRAIL
STA. 92+70.30 LT - STA. 96+45.30 LT
STA. 96+97.45 LT - STA. 102+93.70 LT
STA. 100+69.02 RT - STA. 103+50.00 RT

646.426 DURABLE 6" WHITE LINE, RECESSED

STA. 89+50 - STA. 92+59 (SOLID RT RAMP A)
STA. 89+50 - STA. 91+12 (DOTTED RT)
STA. 92+44 - STA. 99+20 (SOLID RT)
STA. 99+47 - STA. 100+76 (SOLID RT)
STA. 102+08 - STA. 103+50 (DASHED RT)
STA. 99+42 - STA. 99+47 (SOLID RT RAMP H)
STA. 100+59 - STA. 103+50 (SOLID RT RAMP C)
STA. 89+50 - STA. 97+12 (SOLID LT)
STA. 89+50 - STA. 103+50 (DASHED LT)
STA. 99+42 - STA. 99+53 (SOLID LT TO RT MEDIAN)
STA. 89+50 - STA. 103+50 (DASHED LT)
STA. 96+88 - STA. 103+50 (SOLID LT RAMP E)
STA. 98+41 - STA. 103+50 (DASHED LT)

646.436 DURABLE 6" YELLOW LINE, RECESSED



STA. 92+36 - STA. 92+63 (SOLID RT RAMP A)
STA. 99+20 - STA. 99+25 (SOLID RT RAMP H)
STA. 100+47 - STA. 100+76 (SOLID LT RAMP C)
STA. 89+50 - STA. 99+03 (SOLID LT)
STA. 89+50 - STA. 99+15 (SOLID RT)
STA. 99+53 - STA. 103+50 (SOLID RT)
STA. 99+03 - STA. 99+15 (SOLID LT TO RT MEDIAN)
STA. 96+82 - STA. 97+09 (SOLID LT RAMP E)
STA. 99+42 - STA. 103+50 (SOLID LT)

646.482 DURABLE 24" STOP BAR, THERMOPLASTIC

STA. 99+08 - STA. 99+37 LT
STA. 99+25 - STA. 99+42 RT
646.492 DURABLE LETTER OR SYMBOL, THERMOPLASTIC
STA. 99+24 LT "STOP"
STA. 99+33 RT "STOP"

646.466 DURABLE 12" WHITE LINE, RECESSED

STA. 91+12 - STA. 92+36 (SOLID RT RAMP A)
STA. 91+12 - STA. 92+44 (SOLID RT HATCHED)
STA. 91+12 - STA. 92+44 (SOLID RT)
STA. 100+76 - STA. 101+58 (SOLID RT RAMP C)
STA. 97+12 - STA. 98+41 (SOLID LT)
STA. 97+09 - STA. 97+91 (HATCHED LT)
STA. 97+09 - STA. 97+91 (SOLID LT RAMP E)

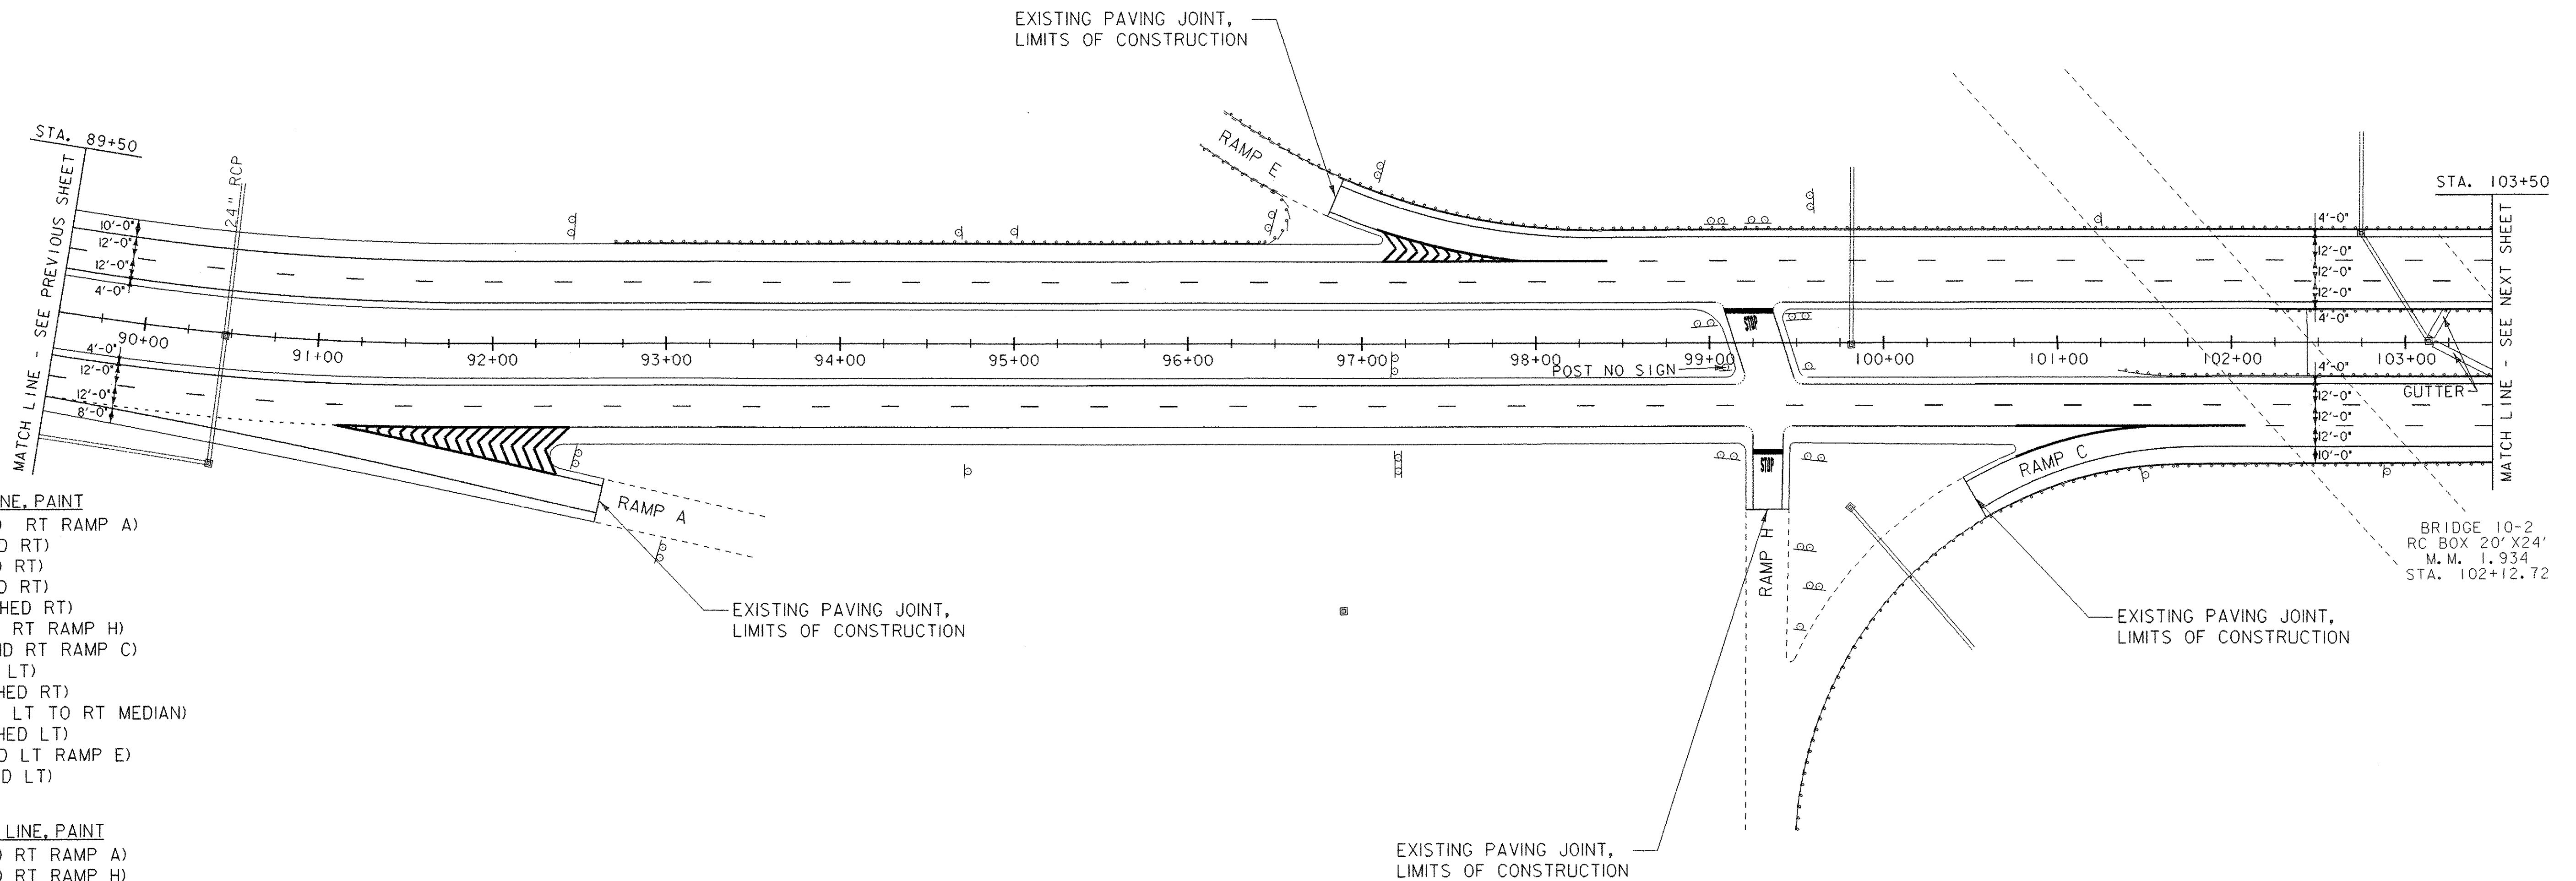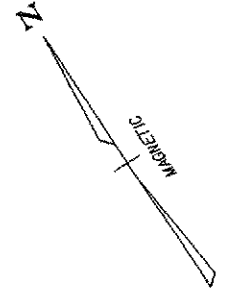

646.622 TEMPORARY 6" WHITE LINE, PAINT

STA. 89+50 - STA. 92+59 (SOLID RT RAMP A)
STA. 89+50 - STA. 91+12 (DOTTED RT)
STA. 92+44 - STA. 99+20 (SOLID RT)
STA. 99+47 - STA. 100+76 (SOLID RT)
STA. 102+08 - STA. 103+50 (DASHED RT)
STA. 99+42 - STA. 99+47 (SOLID RT RAMP H)
STA. 100+59 - STA. 103+50 (SOLID RT RAMP C)
STA. 89+50 - STA. 97+12 (SOLID LT)
STA. 89+50 - STA. 103+50 (DASHED RT)
STA. 99+42 - STA. 99+53 (SOLID LT TO RT MEDIAN)
STA. 89+50 - STA. 103+50 (DASHED LT)
STA. 96+88 - STA. 103+50 (SOLID LT RAMP E)
STA. 98+41 - STA. 103+50 (DASHED LT)

646.632 TEMPORARY 6" YELLOW LINE, PAINT

STA. 92+36 - STA. 92+63 (SOLID RT RAMP A)
STA. 99+20 - STA. 99+25 (SOLID RT RAMP H)
STA. 100+47 - STA. 100+76 (SOLID LT RAMP C)
STA. 89+50 - STA. 99+03 (SOLID LT)
STA. 89+50 - STA. 99+15 (SOLID RT)
STA. 99+53 - STA. 103+50 (SOLID RT)
STA. 99+03 - STA. 99+15 (SOLID LT TO RT MEDIAN)
STA. 96+82 - STA. 97+09 (SOLID LT RAMP E)
STA. 99+42 - STA. 103+50 (SOLID LT)

646.662 TEMPORARY 12" WHITE LINE, PAINT

STA. 91+12 - STA. 92+36 (SOLID RT RAMP A)
STA. 91+12 - STA. 92+44 (SOLID RT HATCHED)
STA. 91+12 - STA. 92+44 (SOLID RT)
STA. 100+76 - STA. 101+58 (SOLID RT)
STA. 100+76 - STA. 101+58 (SOLID RT RAMP C)
STA. 97+12 - STA. 98+41 (SOLID LT)
STA. 97+09 - STA. 97+91 (HATCHED LT)
STA. 97+09 - STA. 97+91 (SOLID LT RAMP E)

646.682 TEMPORARY 24" STOP BAR, PAINT

STA. 99+08 - STA. 99+37 LT
STA. 99+25 - STA. 99+42 RT

646.692 TEMPORARY LETTER OR SYMBOLS, PAINT

STA. 99+24 LT "STOP"
STA. 99+33 RT "STOP"

DATUM
VERTICAL N/A
HORIZONTAL N/A

SCALE 1" = 50'-0"
50 0 50

PROJECT LAYOUT SHEET 12

PROJECT NAME:
PROJECT NUMBER: NH 2501(I)S

FILE NAME: pave/05b034/05b034
PROJECT LEADER: EPD
DESIGNED BY: JDA
PLOT FILE: 05b034pl2.i

PLOT DATE: 12-JAN-2007
DRAWN BY: JAR
CHECKED BY: EPD
SHEET 44 OF 63

SIGN LEGEND

R = REMOVE
S = SALVAGE
N = NEW
RET = RETAIN
B-B = BACK TO BACK