

604.412 REHAB, DROP INLETS, CATCH BASINS,
OR MANHOLES, CLASS J

STA. 104+04.54 RT
STA. 107+64.02 LT
STA. 108+18.69 RT
STA. 113+43.91 RT

616.35 TREATED TIMBER CURB

STA. 103+50 RT - STA. 104+00 RT

621.20 STEEL BEAM GUARD RAIL, GALVANIZED

STA. 103+50.00 RT - STA. 104+06.52 RT
STA. 107+85.55 RT - STA. 113+85.55 RT
STA. 108+30.00 RT - LT

621.60 ANCHOR FOR STEEL BEAM RAIL


STA. 113+85.55 RT

621.80 REMOVAL AND DISPOSAL OF GUARDRAIL

STA. 103+50.00 RT - STA. 104+06.52 RT
STA. 107+85.55 RT - STA. 113+85.55 RT

EXISTING PAVING JOINT,
LIMITS OF CONSTRUCTION

EXISTING PAVING JOINT,
LIMITS OF CONSTRUCTION

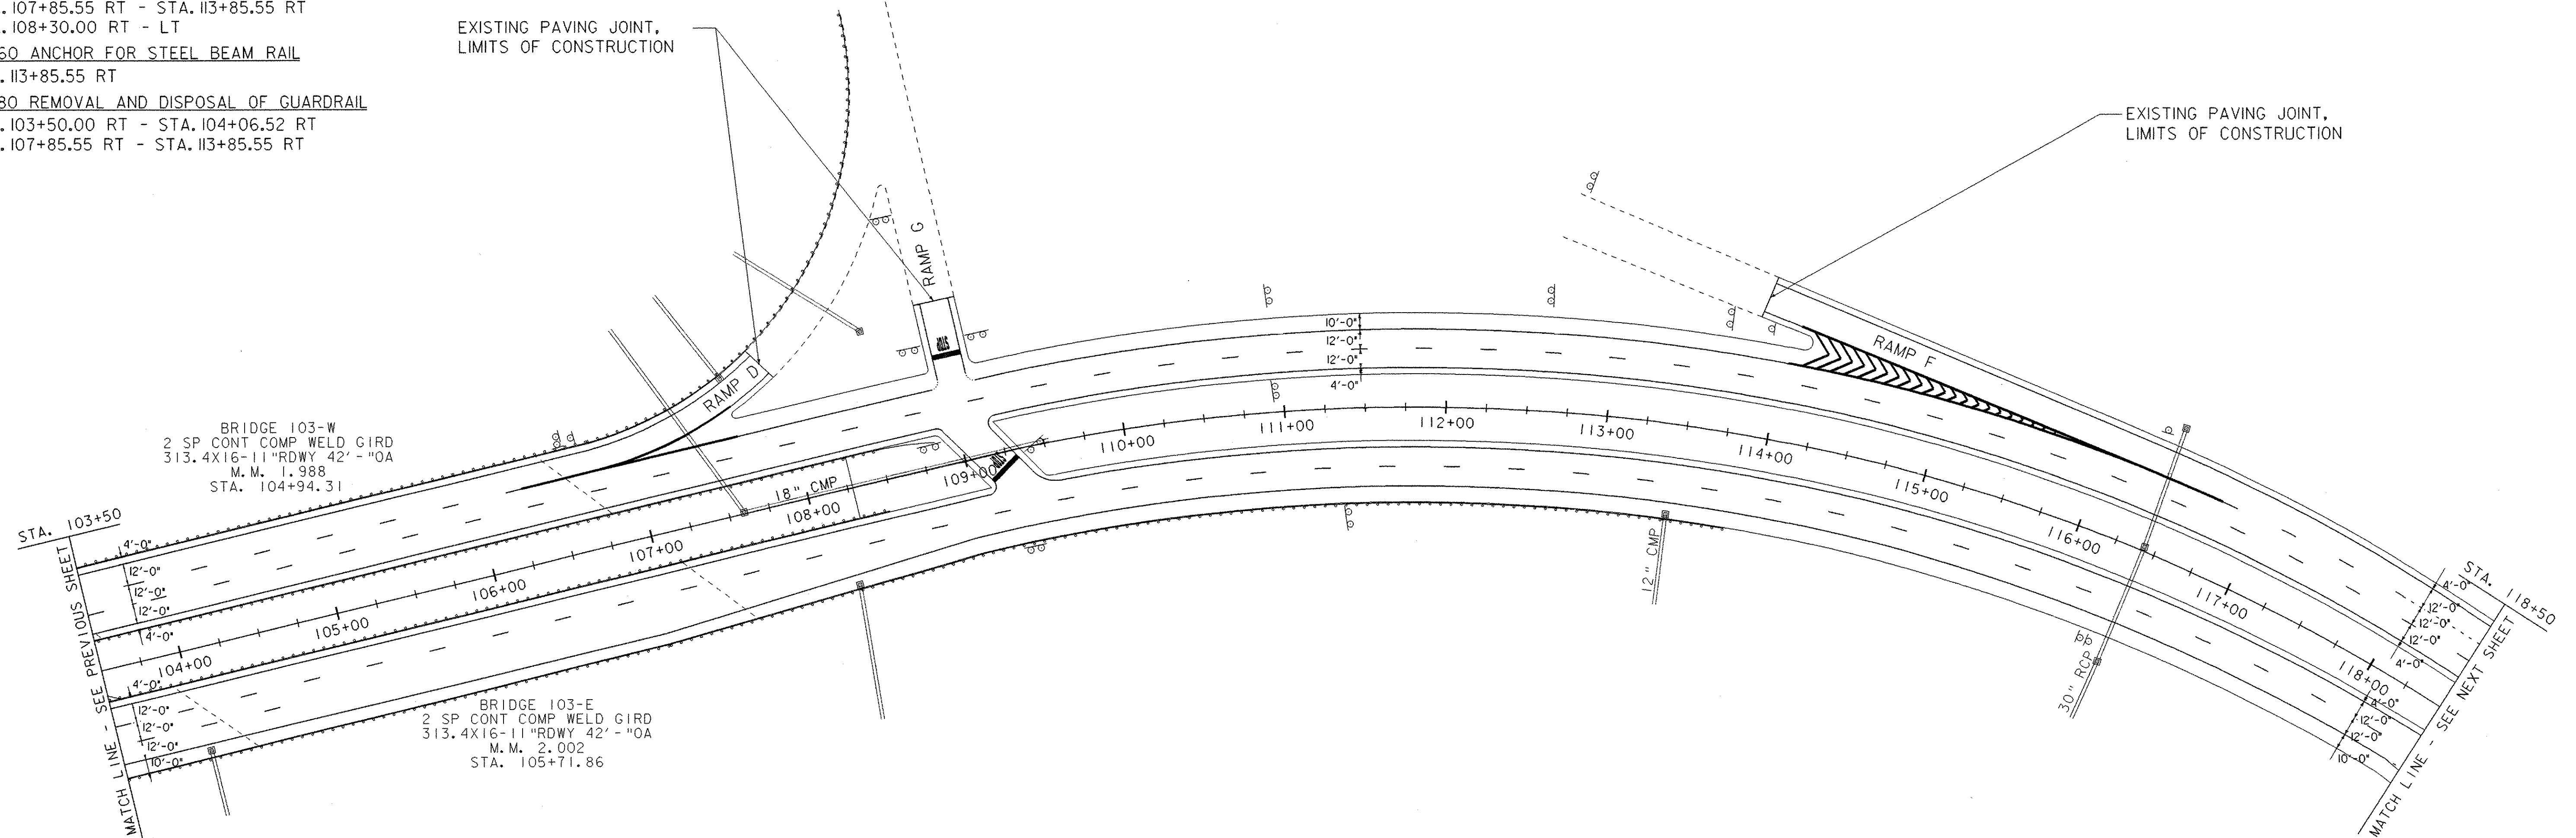

646.426 DURABLE 6" WHITE LINE, RECESSED

STA. 103+50 - STA. 118+50 (SOLID RT)
STA. 103+50 - STA. 118+50 (DASHED RT & LT)
STA. 103+50 - STA. 104+52 (DASHED RT)
STA. 108+86 - STA. 109+10 (SOLID LT - RT MEDIAN)
STA. 103+50 - STA. 106+29 (DASHED LT)
STA. 103+50 - STA. 107+86 (SOLID LT - RAMP D)
STA. 107+66 - STA. 108+90 (SOLID LT)
STA. 109+17 - STA. 114+04 (SOLID LT)
STA. 116+76 - STA. 117+96 (DASHED LT)
STA. 117+96 - STA. 118+50 (DOTTED LT)
STA. 108+90 - STA. 108+95 (SOLID LT RAMP G)
STA. 113+89 - STA. 118+50 (SOLID LT RAMP F)

646.436 DURABLE 6" YELLOW LINE, RECESSED

STA. 103+50 - STA. 109+10 (SOLID RT)
STA. 109+56 - STA. 118+50 (SOLID RT)
STA. 103+50 - STA. 108+86 (SOLID LT)
STA. 109+24 - STA. 118+50 (SOLID LT)
STA. 109+24 - STA. 109+56 (SOLID LT - RT MEDIAN)
STA. 107+66 - STA. 107+96 (SOLID LT RAMP D)
STA. 109+12 - STA. 109+17 (SOLID LT RAMP G)
STA. 113+85 - STA. 114+08 (SOLID LT - RAMP F)

646.466 DURABLE 12" WHITE LINE, RECESSED

STA. 106+29 - STA. 107+66 (SOLID LT)
STA. 106+79 - STA. 107+66 (SOLID LT RAMP D)
STA. 114+04 - STA. 116+76 (SOLID LT)
STA. 114+08 - STA. 116+28 (SOLID LT RAMP F)
STA. 114+04 - STA. 116+28 (HATCHED LT RAMP F)

646.482 DURABLE 24" STOP BAR, THERMOPLASTIC

STA. 108+95 - STA. 109+12 LT
STA. 109+14 - STA. 109+33 RT

646.492 DURABLE LETTER OR SYMBOL, THERMOPLASTIC

STA. 109+03 LT "STOP"
STA. 109+20 RT "STOP"

646.622 TEMPORARY 6" WHITE LINE, PAINT

STA. 103+50 - STA. 118+50 (SOLID RT)
STA. 103+50 - STA. 118+50 (DASHED RT & LT)
STA. 103+50 - STA. 104+52 (DASHED RT)
STA. 108+86 - STA. 109+10 (SOLID LT - RT MEDIAN)
STA. 103+50 - STA. 106+29 (DASHED LT)
STA. 103+50 - STA. 107+86 (SOLID LT - RAMP D)
STA. 107+66 - STA. 108+90 (SOLID LT)
STA. 109+17 - STA. 114+04 (SOLID LT)
STA. 116+76 - STA. 117+96 (DASHED LT)
STA. 117+96 - STA. 118+50 (DOTTED LT)
STA. 108+90 - STA. 108+95 (SOLID LT RAMP G)
STA. 113+89 - STA. 118+50 (SOLID LT RAMP F)

646.632 TEMPORARY 6" YELLOW LINE, PAINT

STA. 103+50 - STA. 109+10 (SOLID RT)
STA. 109+56 - STA. 118+50 (SOLID RT)
STA. 103+50 - STA. 108+86 (SOLID LT)
STA. 109+24 - STA. 118+50 (SOLID LT)
STA. 109+24 - STA. 109+56 (SOLID LT - RT MEDIAN)
STA. 107+66 - STA. 107+96 (SOLID LT RAMP D)
STA. 109+12 - STA. 109+17 (SOLID LT RAMP G)
STA. 113+85 - STA. 114+08 (SOLID LT - RAMP F)

646.662 TEMPORARY 12" WHITE LINE, PAINT

STA. 106+29 - STA. 107+66 (SOLID LT)
STA. 106+79 - STA. 107+66 (SOLID LT RAMP D)
STA. 114+04 - STA. 116+76 (SOLID LT)
STA. 114+08 - STA. 116+28 (SOLID LT RAMP F)
STA. 114+04 - STA. 116+28 (HATCHED LT RAMP F)

646.682 TEMPORARY 24" STOP BAR, PAINT

STA. 108+95 - STA. 109+12 LT
STA. 109+14 - STA. 109+33 RT

646.692 TEMPORARY LETTER OR SYMBOLS, PAINT


STA. 109+03 LT "STOP"
STA. 109+20 RT "STOP"

SIGN LEGEND

R = REMOVE
S = SALVAGE
N = NEW
RET = RETAIN
B-B = BACK TO BACK

DATUM	
VERTICAL	N/A
HORIZONTAL	N/A

**PROJECT
LAYOUT
SHEET 13**

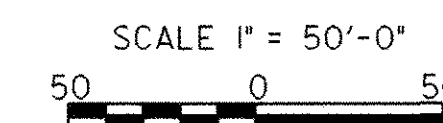

PROJECT NAME:
PROJECT NUMBER: NH 2501(1)S

FILE NAME: pave/05b034/05b034
PROJECT LEADER: EPD
DESIGNED BY: JDA
PLOT FILE: 05b034p13.i

PLOT DATE: 12-JAN-2007
DRAWN BY: JAR
CHECKED BY: EPD
SHEET 45 OF 63