


TRAFFIC SIGN SUMMARY SHEET 2

MILEMARKER, STATION, OR SIGN NUMBER	SIGN LEGEND	SIGN DIMENSIONS		NEW & SALVAGED SIGNS				EXIST POST RETAIN	NO. OF POSTS	NEW SIGN POSTS																REMARKS	SIGN DETAIL				
		E A	WIDTH (in)	HEIGHT (in)	"A"	"B"	SALV SIGN			SALV TIS	FLANGED CHANNEL			SQUARE STEEL (in)			TUBULAR ALUMINUM (in)			TUBULAR STEEL (in)				W-SHAPE STEEL			DETAIL ON SHEET NUMBER	STD. SHEET NUMBER			
											lb/ft			1.75	2.0	2.5	3.0	4.0	4.0 MOD	FOUND-ATION	3.0	3.5	4.0	5.0	FTG. SIZE				WEIGHT	POST SIZE	
											1.12	2.0	3.0	1.88	2.16	3.35	1.3	1.7	1.7		7.6	9.0	10.8	14.6	24"						30"
STA. 276+86.75 LT		I	6	8	0.33				1	X		X														VD-701	E-134				
STA. 278+98.61 LT		I	36	36	9.00				2		X	X														VW-092	E-150				
STA. 279+19.14 RT		I	30	24	5.00				1		X	X														59					
STA. 281+01.13 RT		I	24	30	5.00				1		X	X														R2-1	E-142				
STA. 283+98.07 RT		I	30	24	5.00				1		X	X														59					
STA. 284+23.00 RT		I	36	36	9.00				2		X	X														W9-IR	60				
STA. 285+12.00 LT		I	6	10	0.42				1	X		X															E-138				
STA. 285+99.20 LT		I	24	30	5.00				1		X	X														R2-1	E-142				
STA. 287+23.00 RT		I	36	36	9.00				2		X	X														W4-2	E-151				
STA. 289+50.00 LT		I	36	36	9.00				2		X	X														W4-2	E-151				
STA. 292+50.00 LT		I	36	36	9.00				2		X	X														W9-IR	60				
STA. 297+46.90 LT		I	30	24	5.00				1		X	X														59					
STA. 298+16.08 RT		I	24	30	5.00				1		X	X														VR-017	E-141				
STA. 298+66.76 RT		I	30	30	6.25				1		X	X														RI-1 MOUNT REF. PLAQUE BACK TO BACK W/ STOP SIGN. MOUNT STREET SIGN OVER STOP SIGN. POST TOP MOUNTING BRACKET REQUIRED FOR FLANGED CHANNEL POST OPTION.	E-143				
		I	6	10	0.42																						E-138				

FINAL POST LENGTHS ARE TO BE DETERMINED IN THE FIELD. POST SIZES ARE COMPUTED BASED ON INFORMATION FURNISHED ON THE STANDARD SHEETS AND THE TRAFFIC & SAFETY DIVISION'S "SIGN POST DESIGN GUIDELINE."

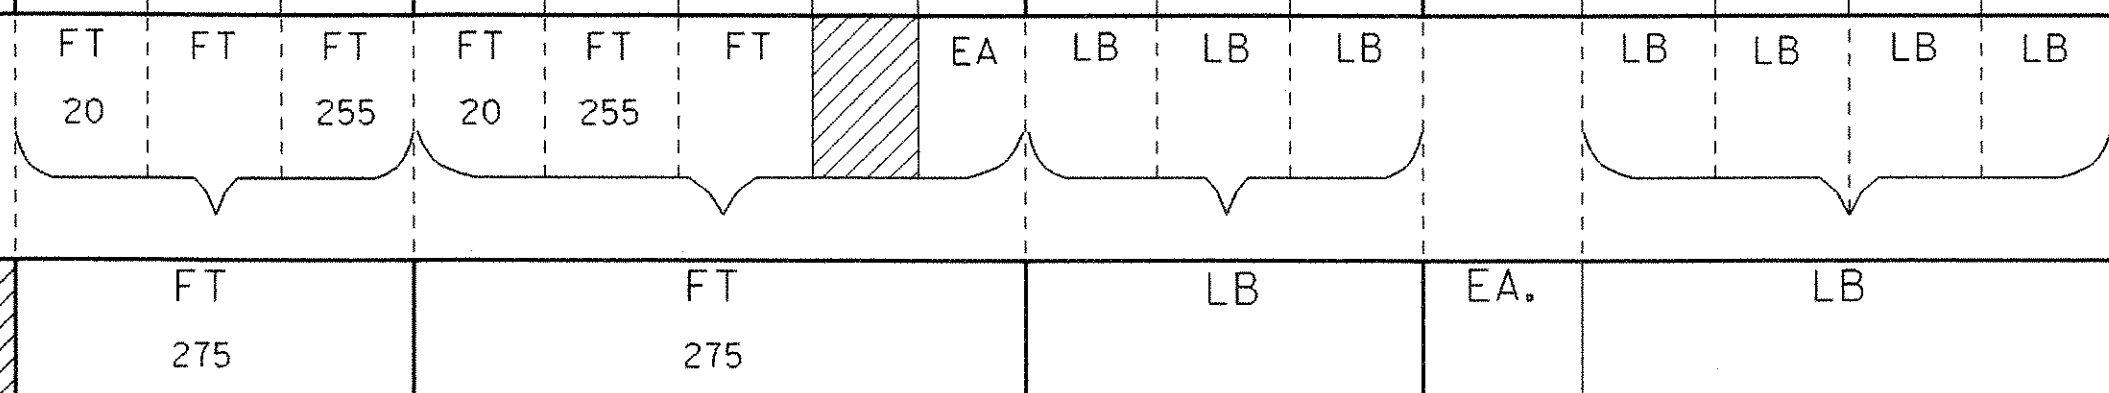

TRAFFIC SIGN SUMMARY SHEET 2

PROJECT NAME: DANVILLE - ST. JOHNSBURY
PROJECT NUMBER: NH 2501(1)S
FILE NAME: pave/05b034/05b034
PROJECT LEADER: EPD
DESIGNED BY: JDA
PLOT FILE: 05b034+s02.1
PLOT DATE: 12-JAN-2007
DRAWN BY: JAR
CHECKED BY: EPD
SHEET 49 OF 63