




U.S. 2 / PENNY LANE INTERSECTION

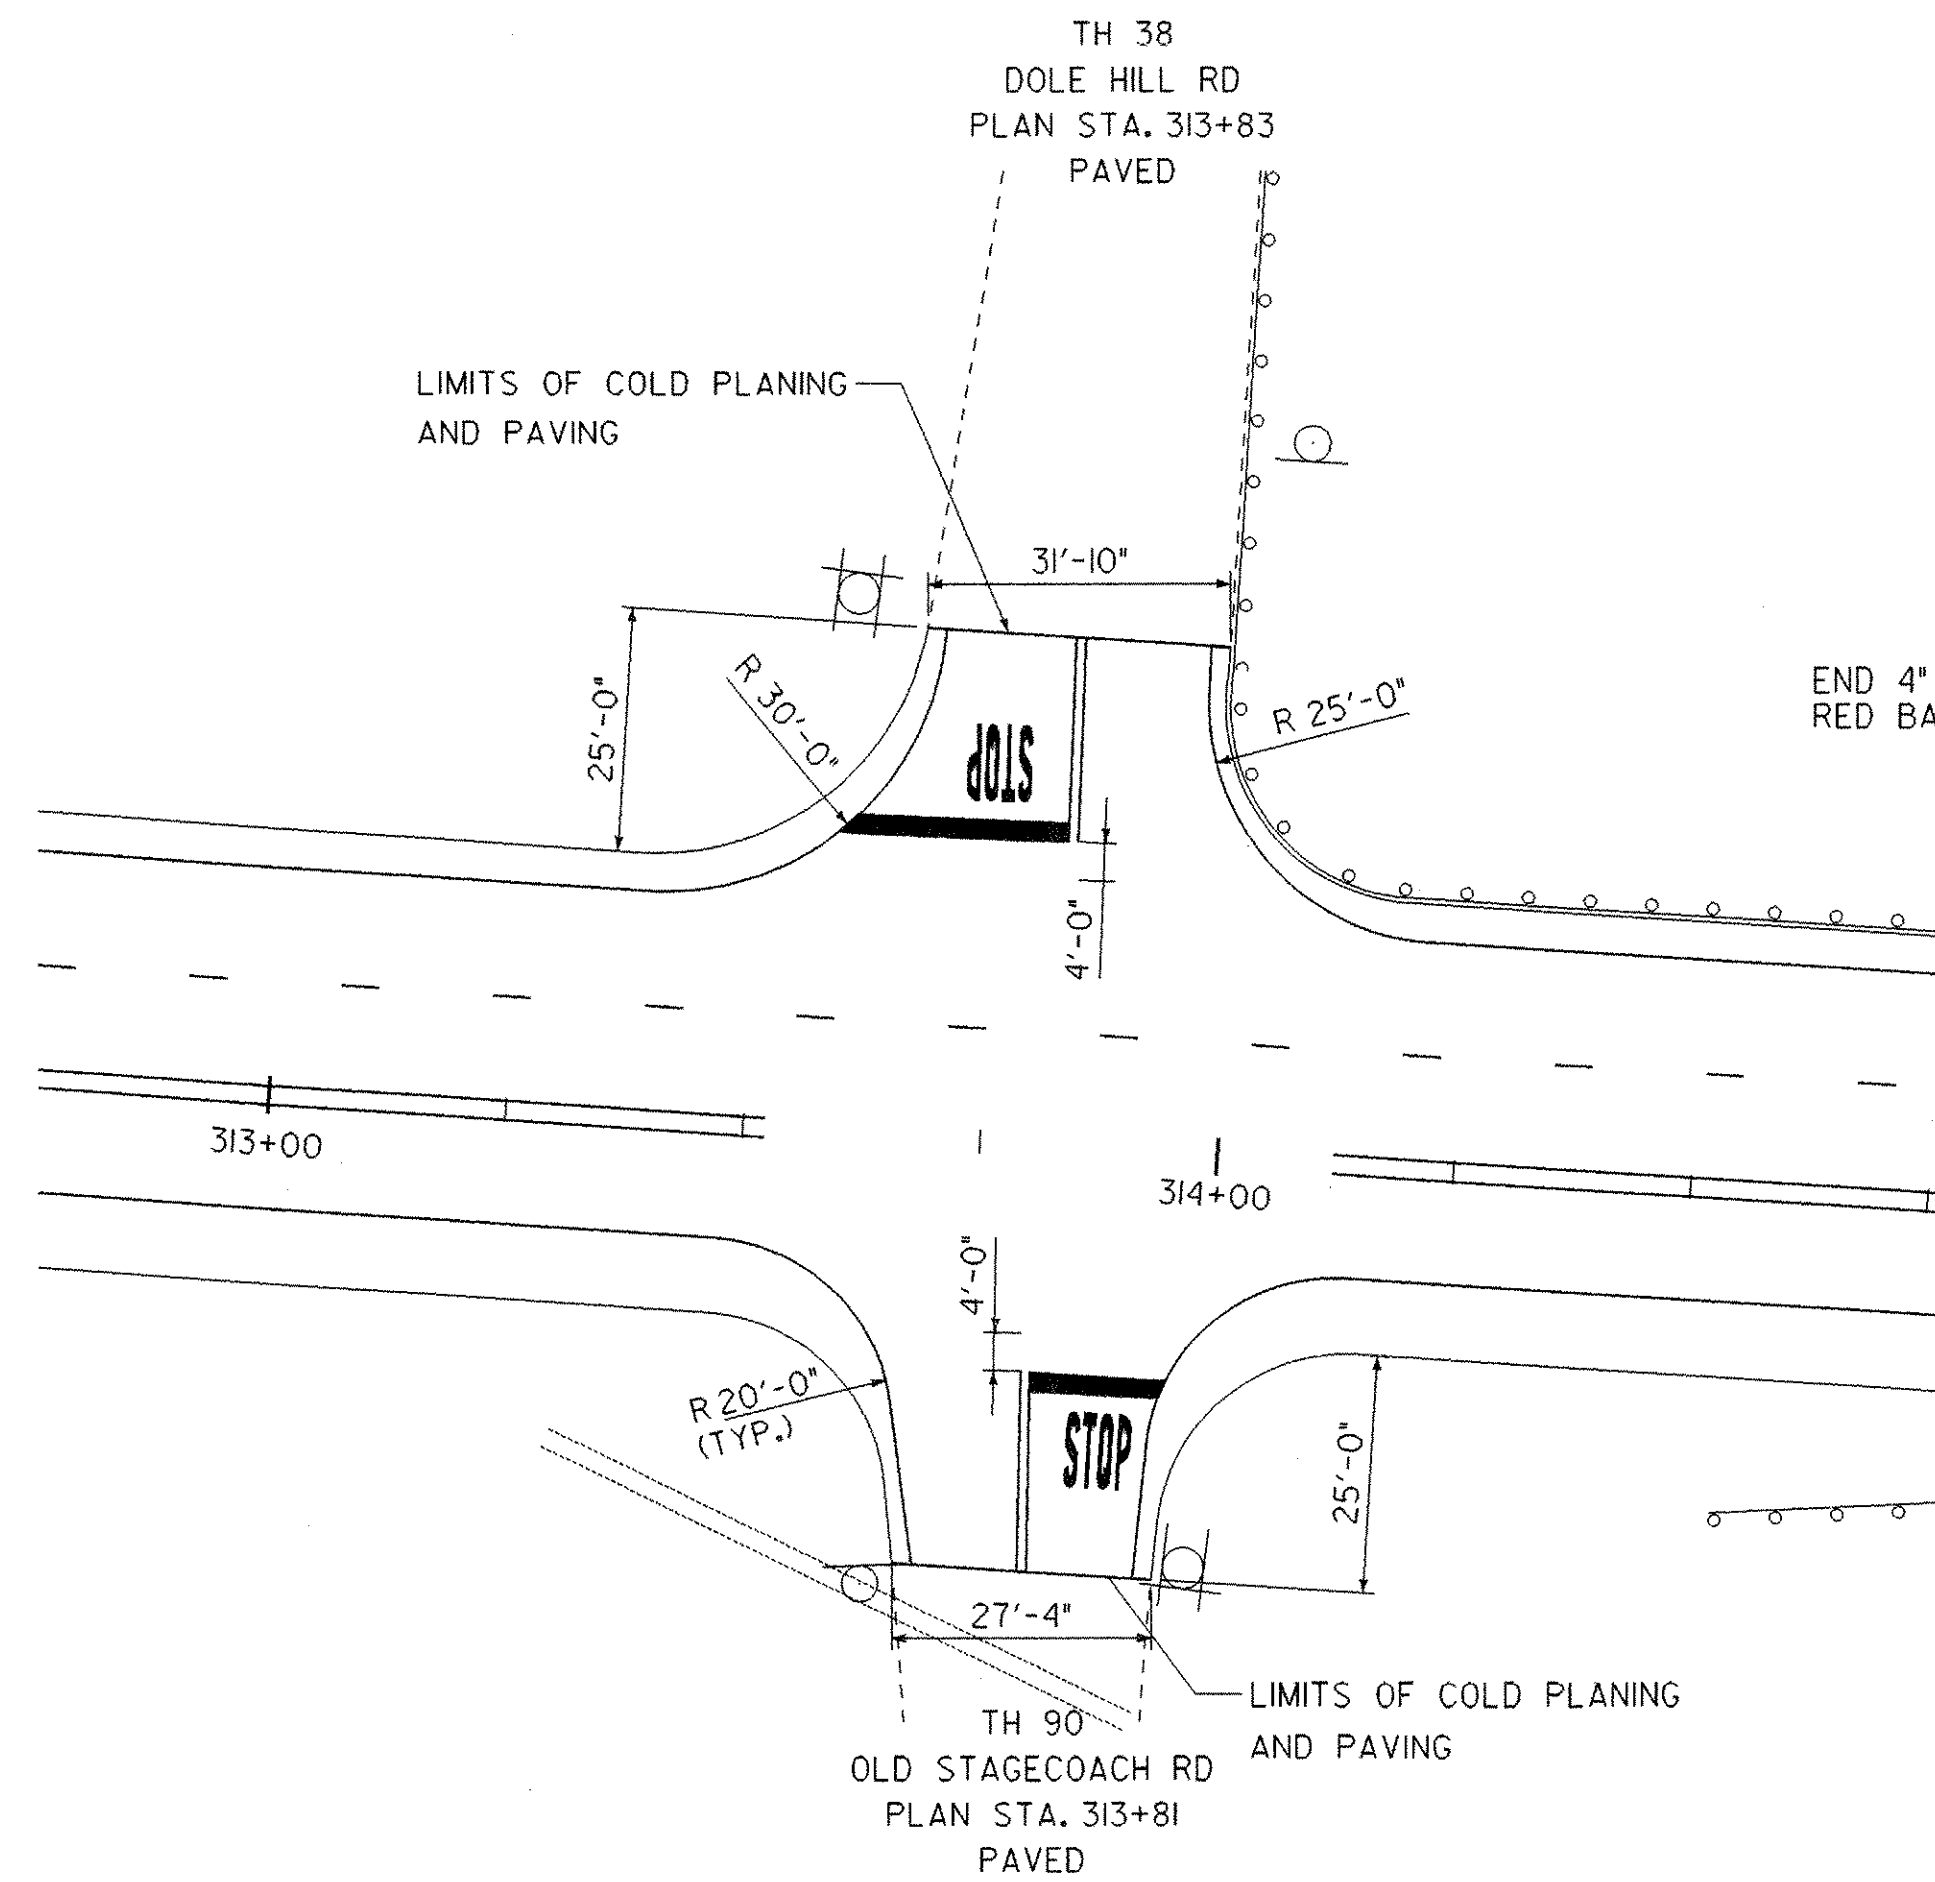


OLD STAGECOACH RD / DOLE HILL RD INTERSECTION

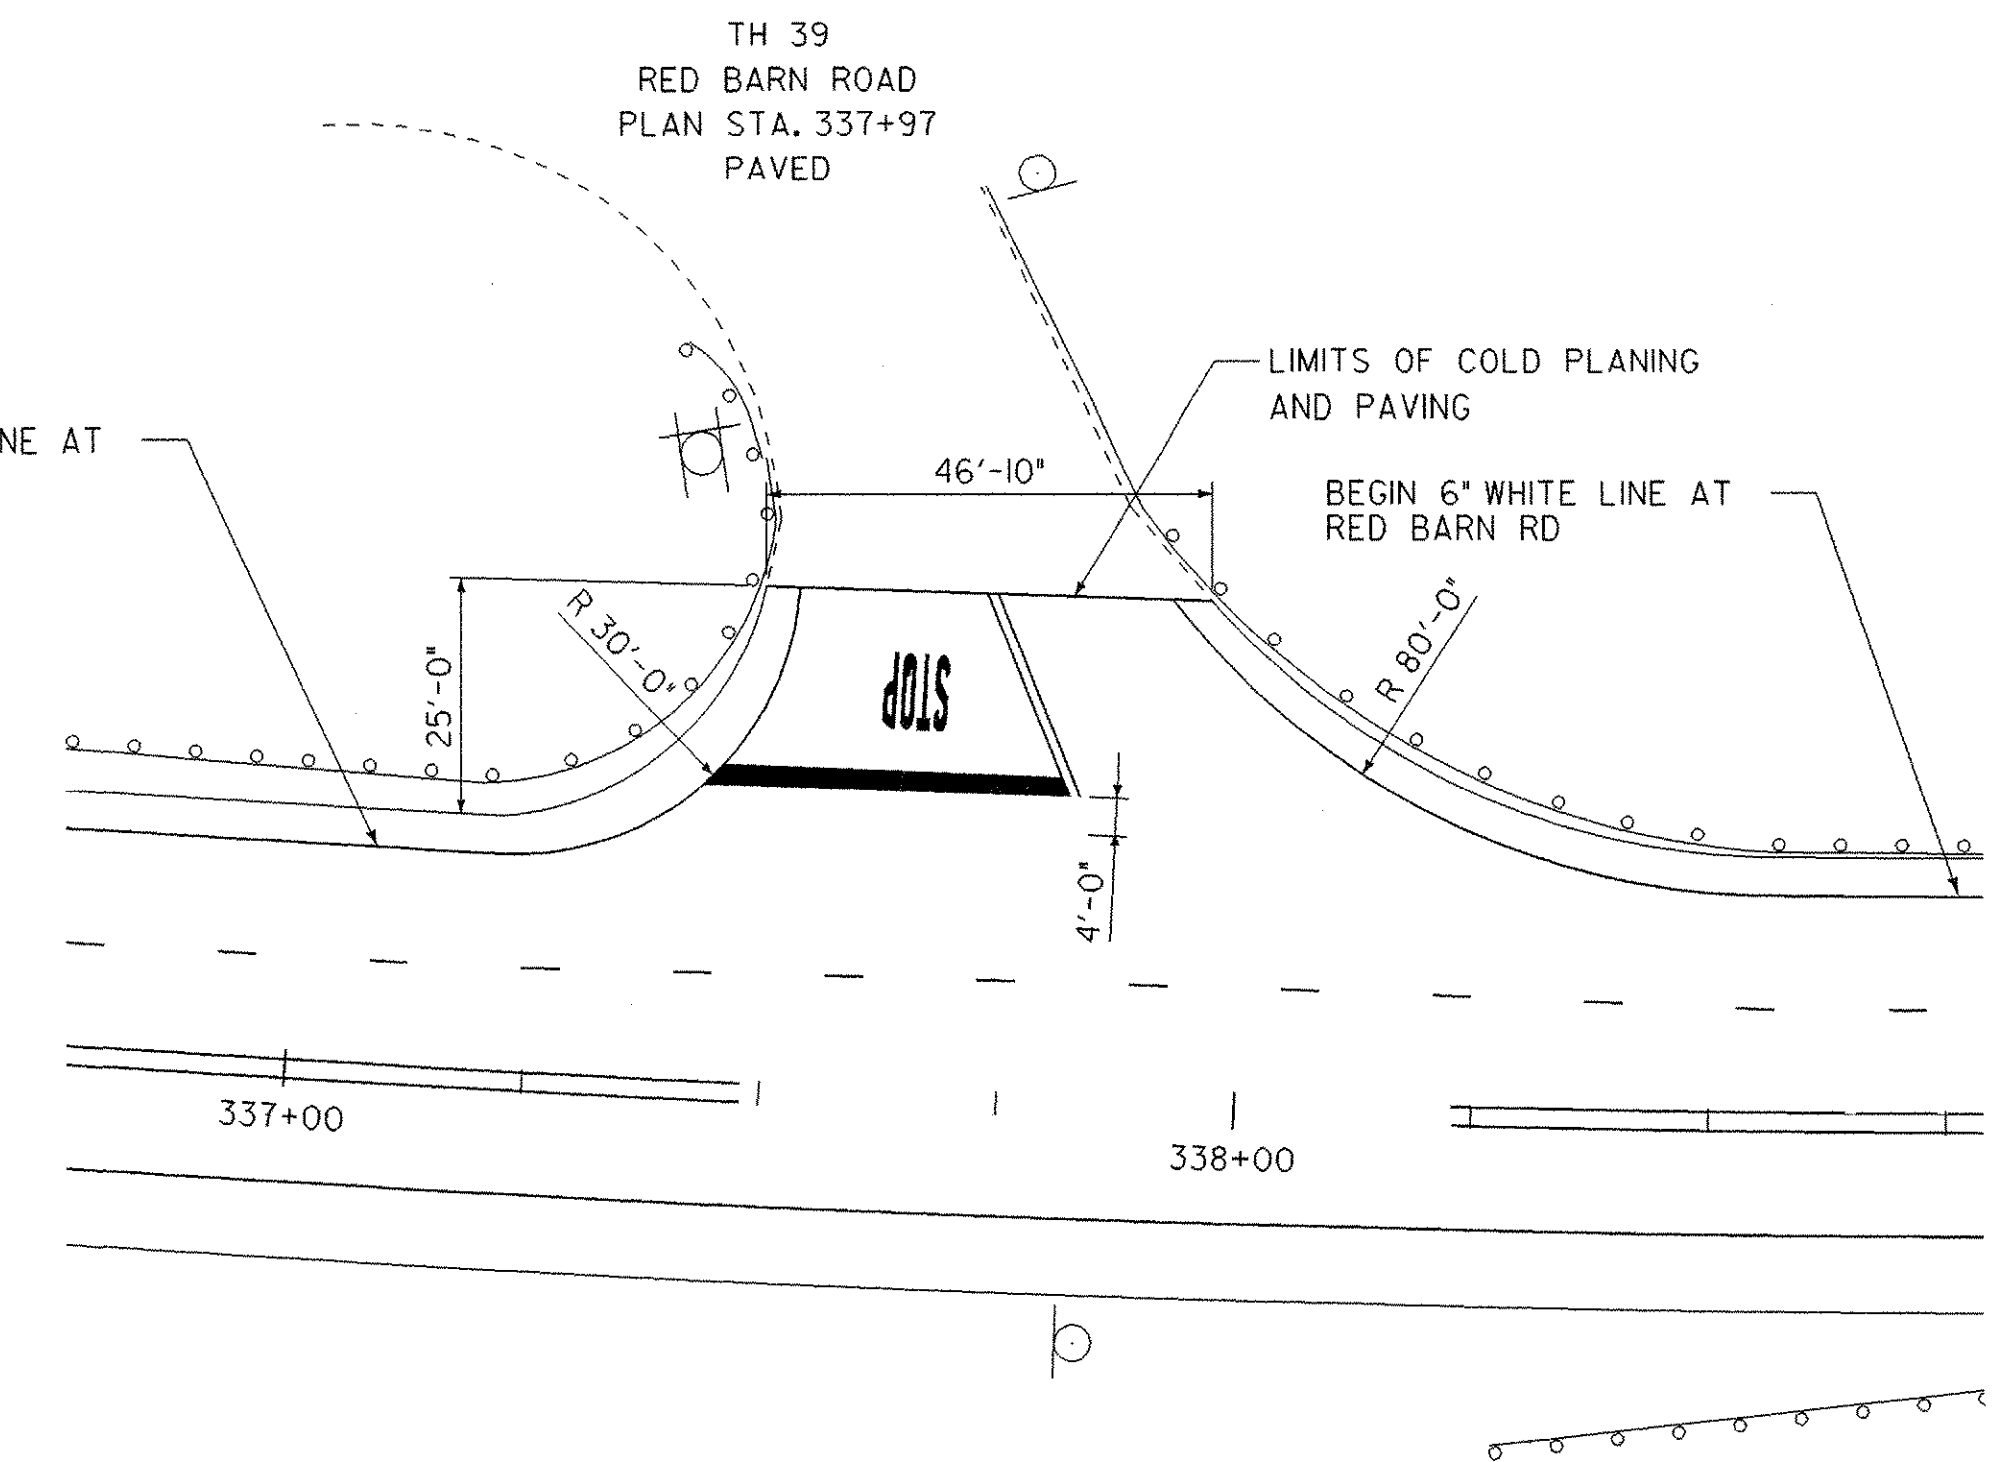

RED BARN ROAD INTERSECTION

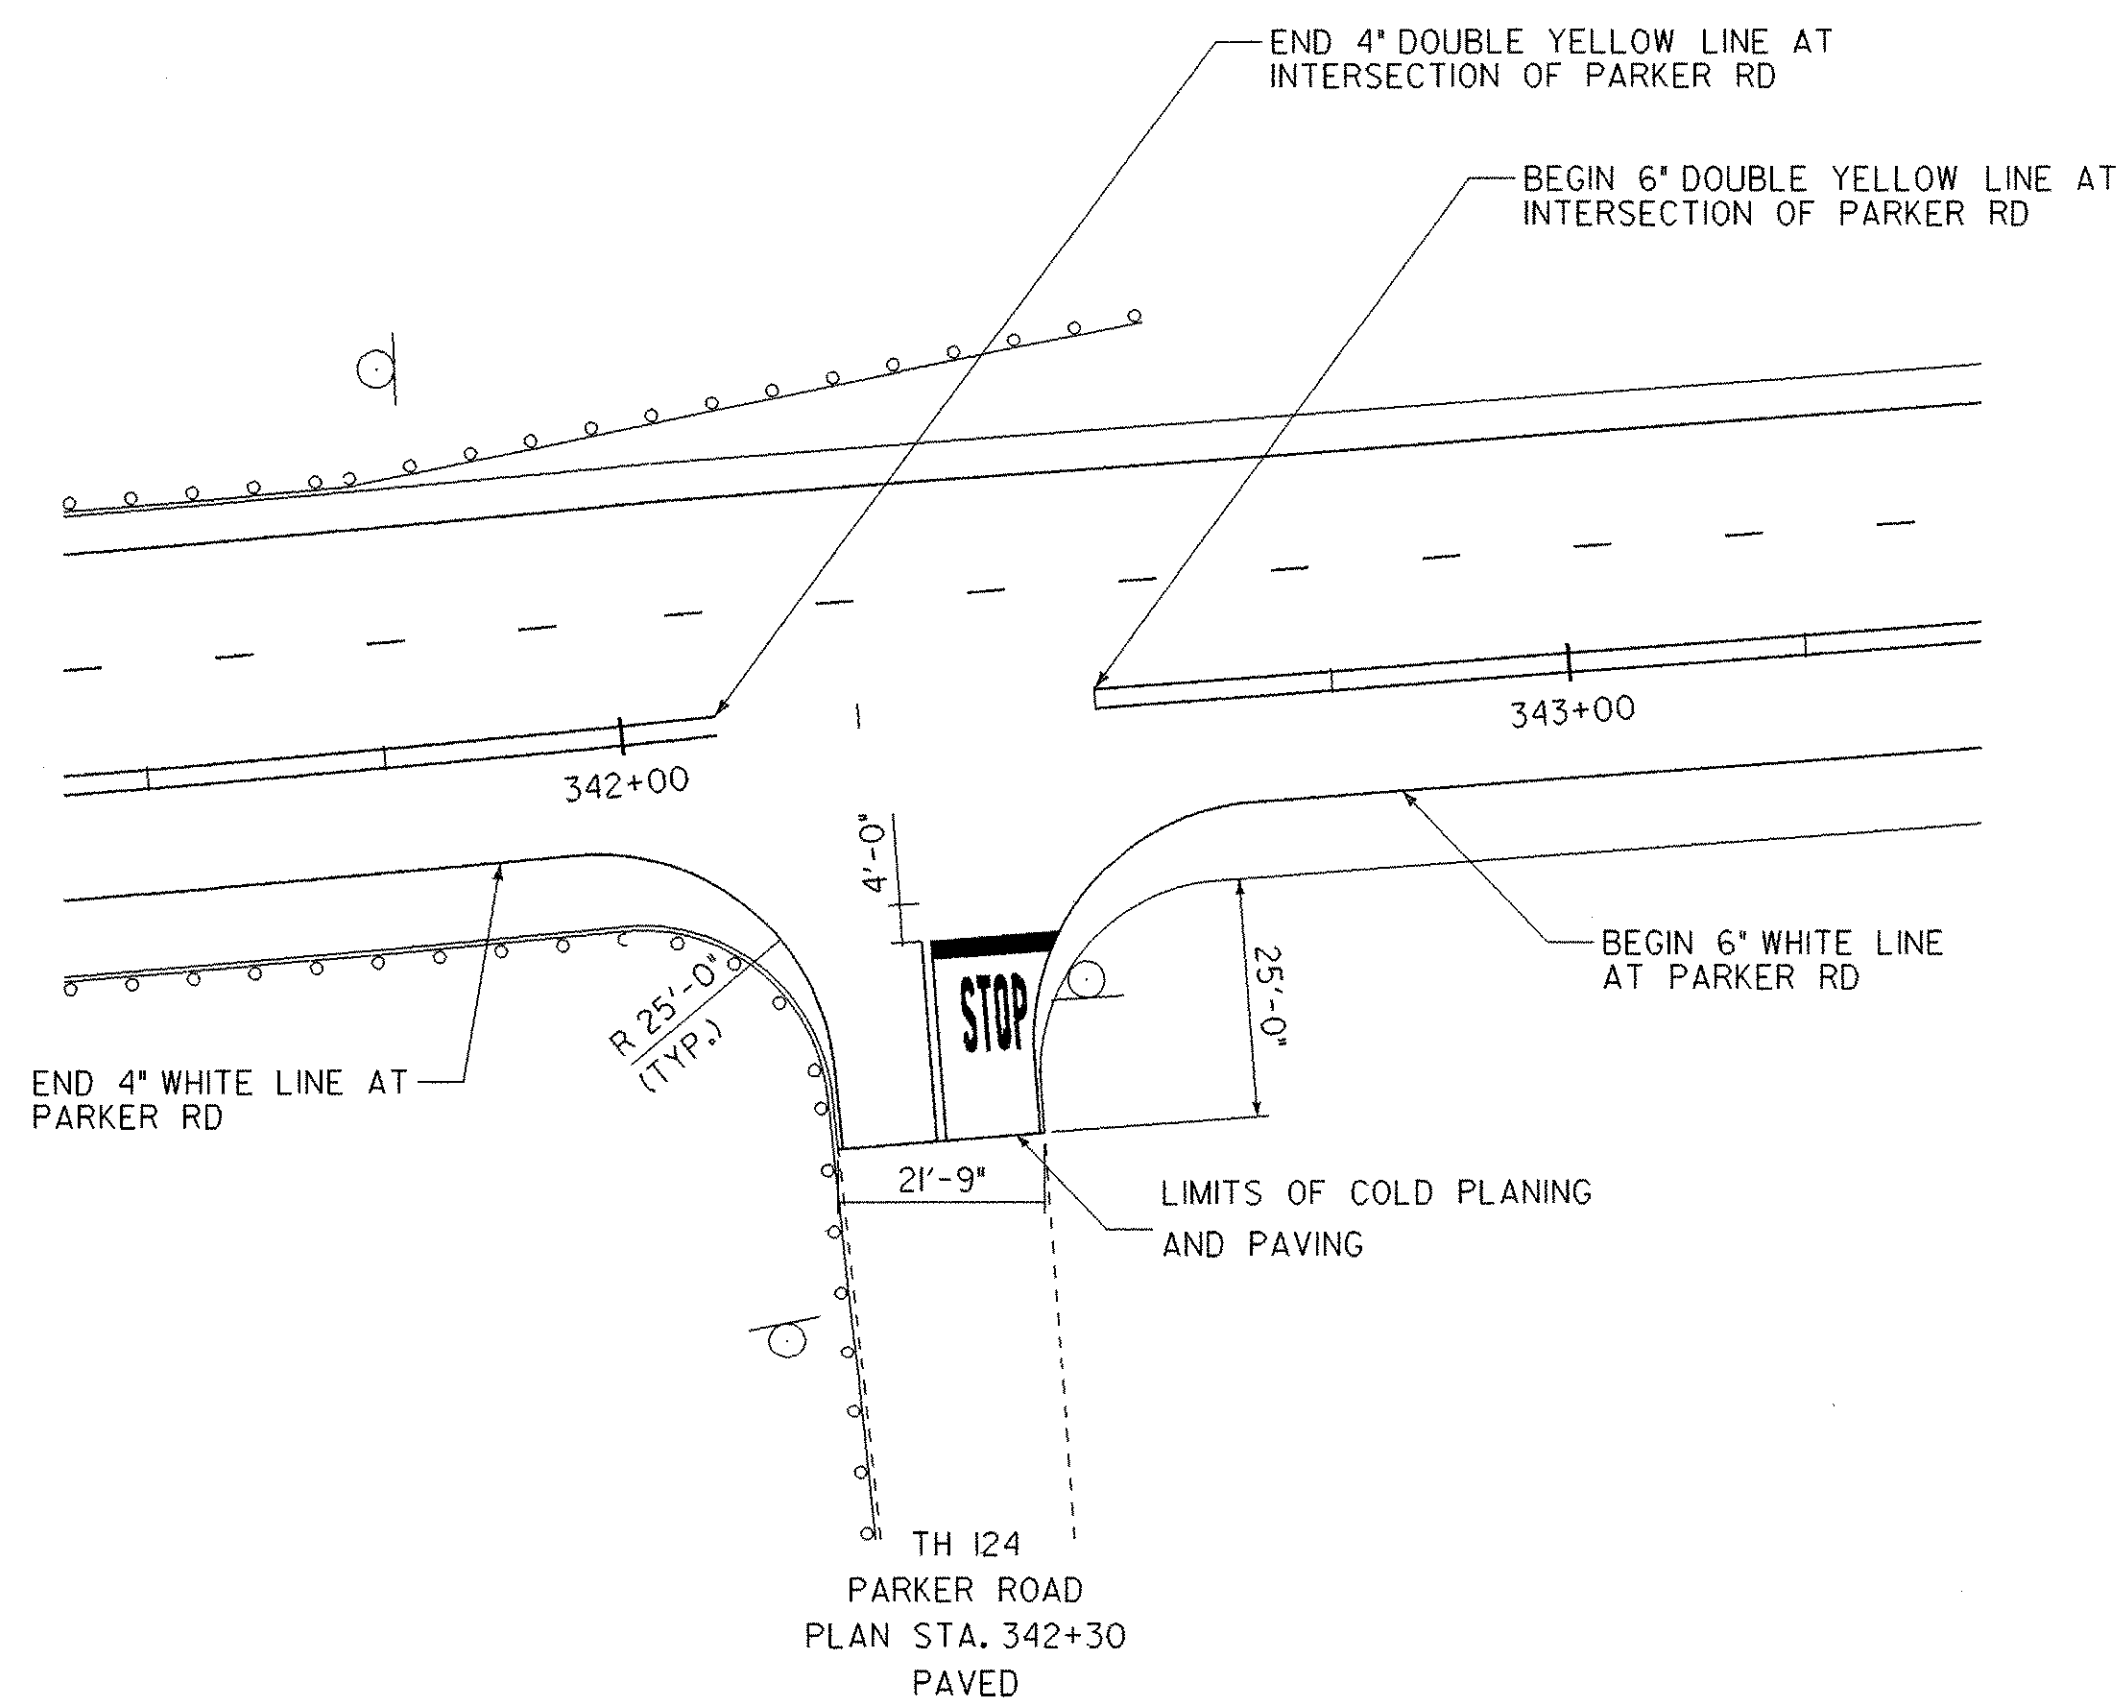

PARKER RD INTERSECTION

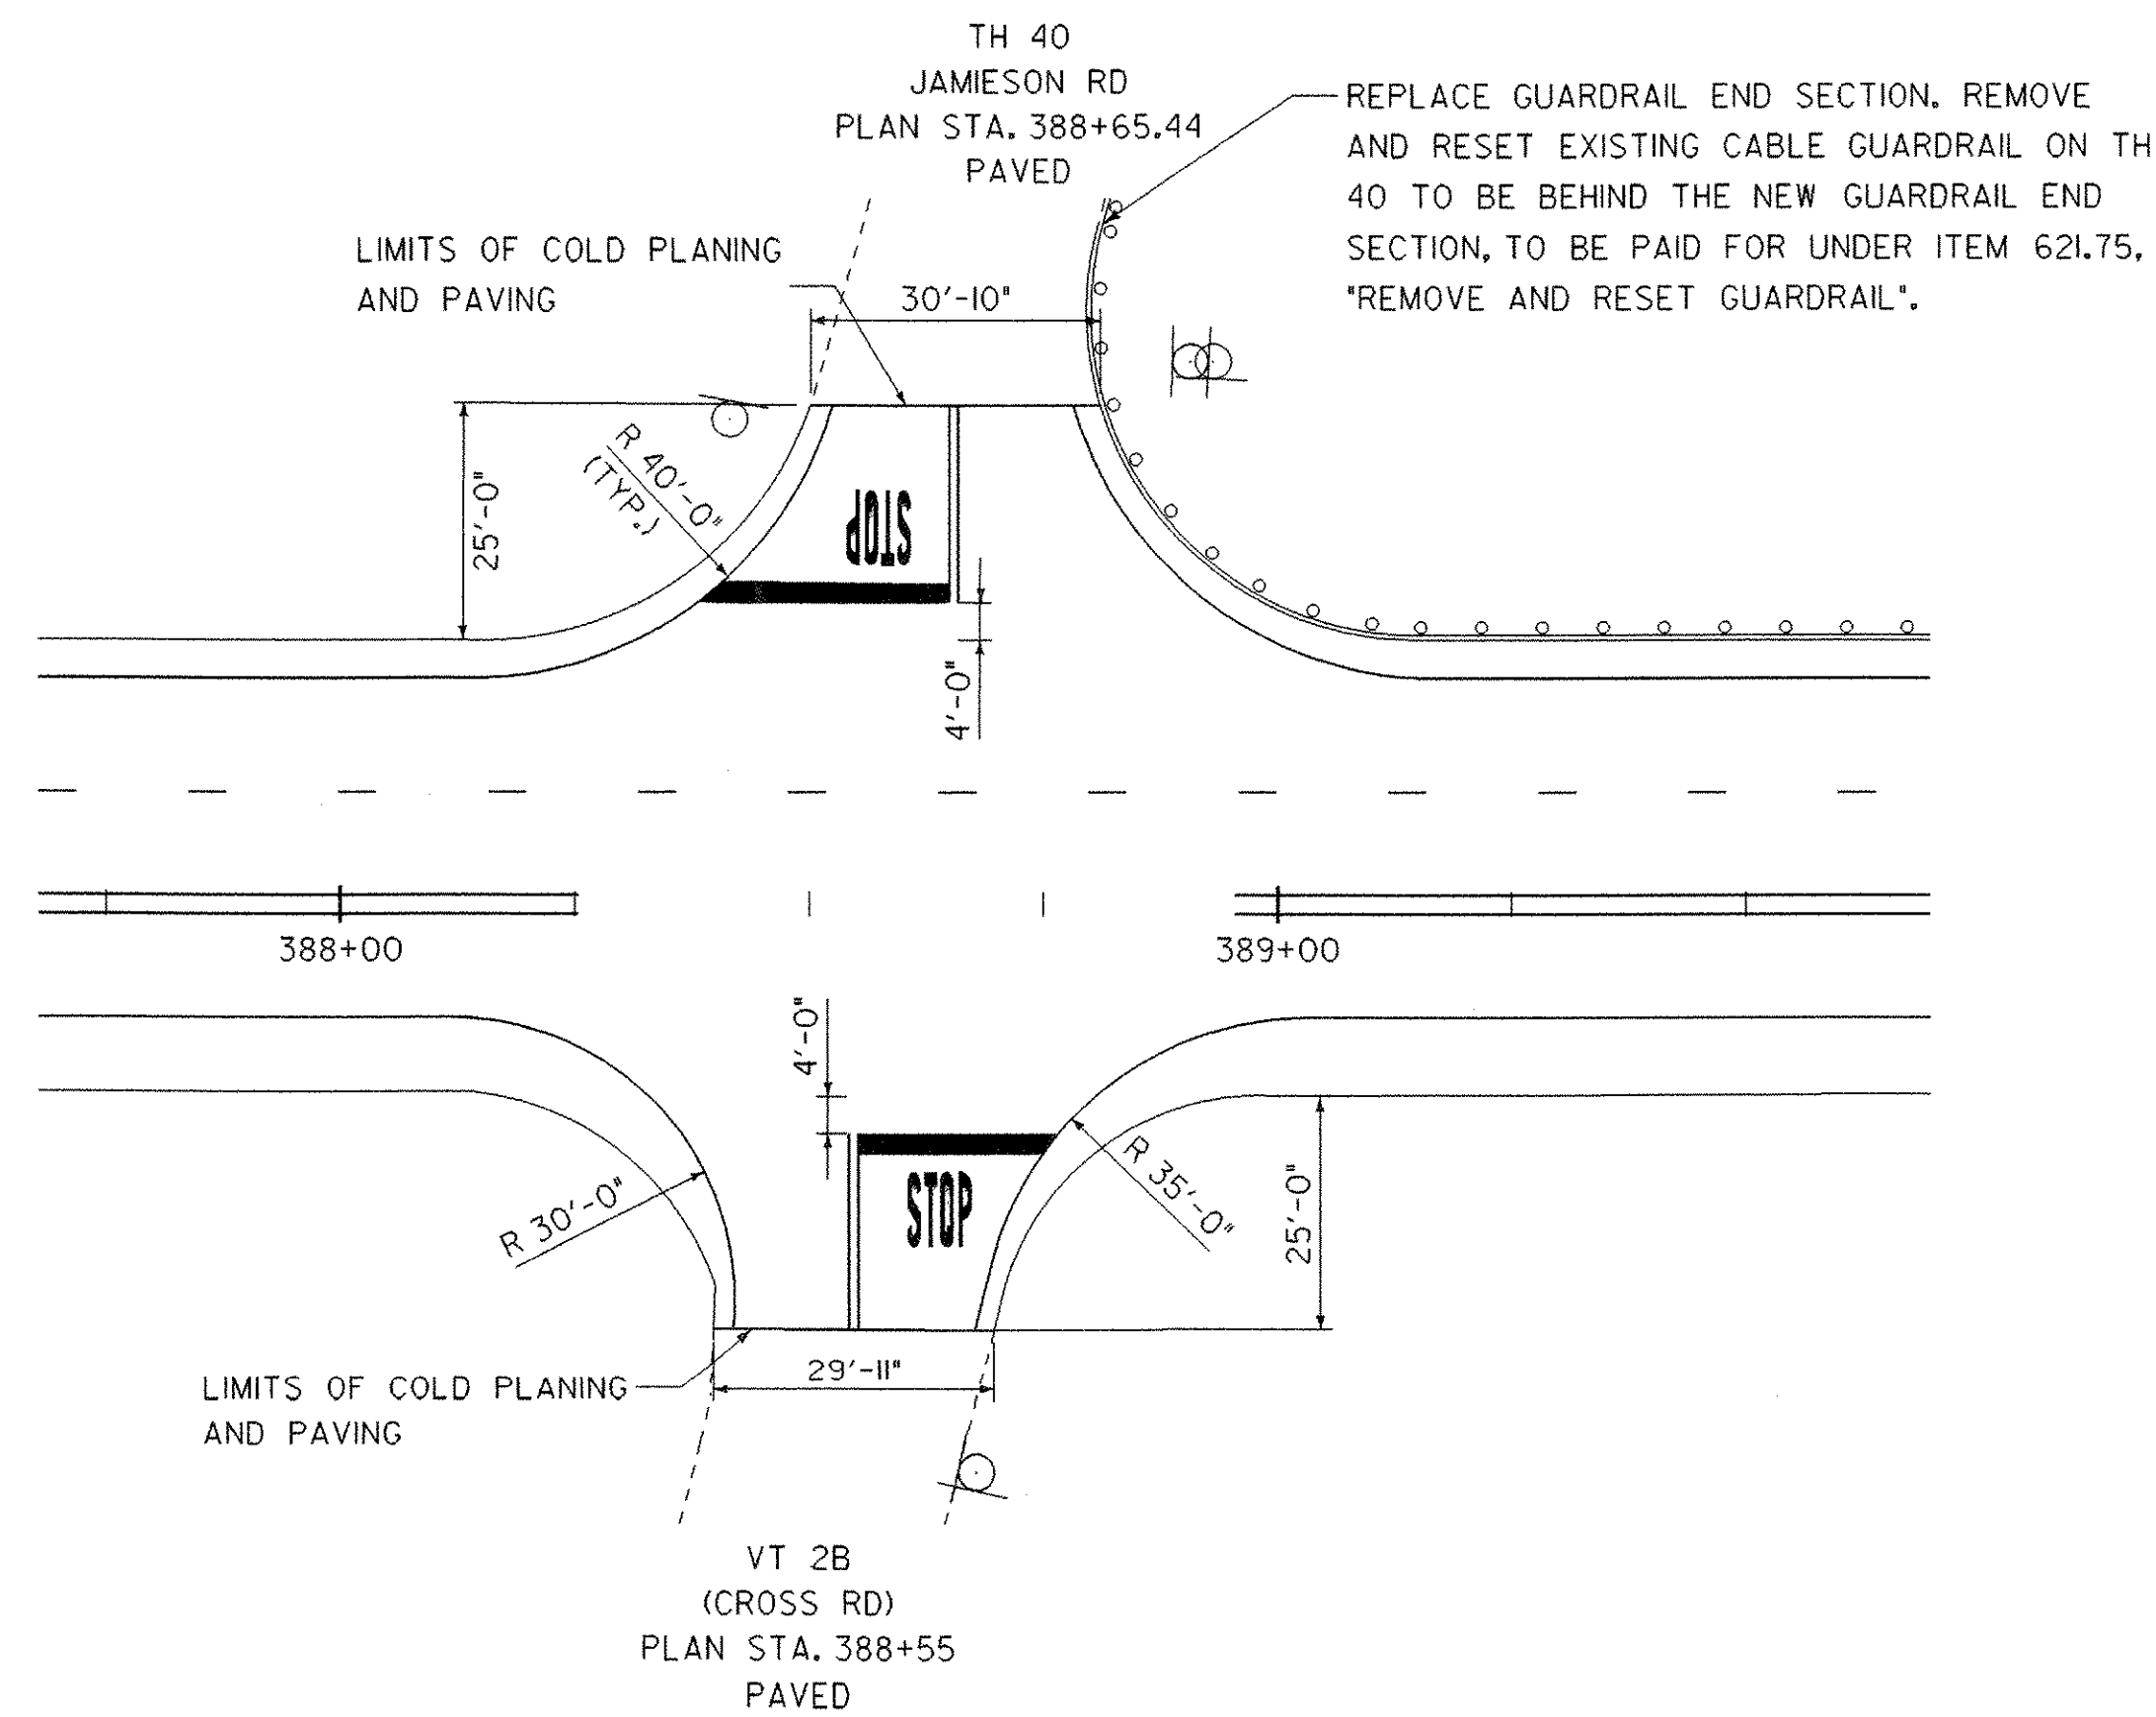

VT 2B (CROSS RD) / JAMIESON RD INTERSECTION

ALL DETAILS NOT TO SCALE

**INTERSECTION
DETAIL
SHEET 1**

PROJECT NAME:	
PROJECT NUMBER:	NH 2501(I)S
FILE NAME:	pave/p05b034/05b034
PROJECT LEADER:	EPD
DESIGNED BY:	JDA
PLOT FILE:	05b034in+1.i
PLOT DATE:	12-JAN-2007
DRAWN BY:	
CHECKED BY:	EPD
SHEET	61 OF 63