


NORTH DANVILLE RD INTERSECTION

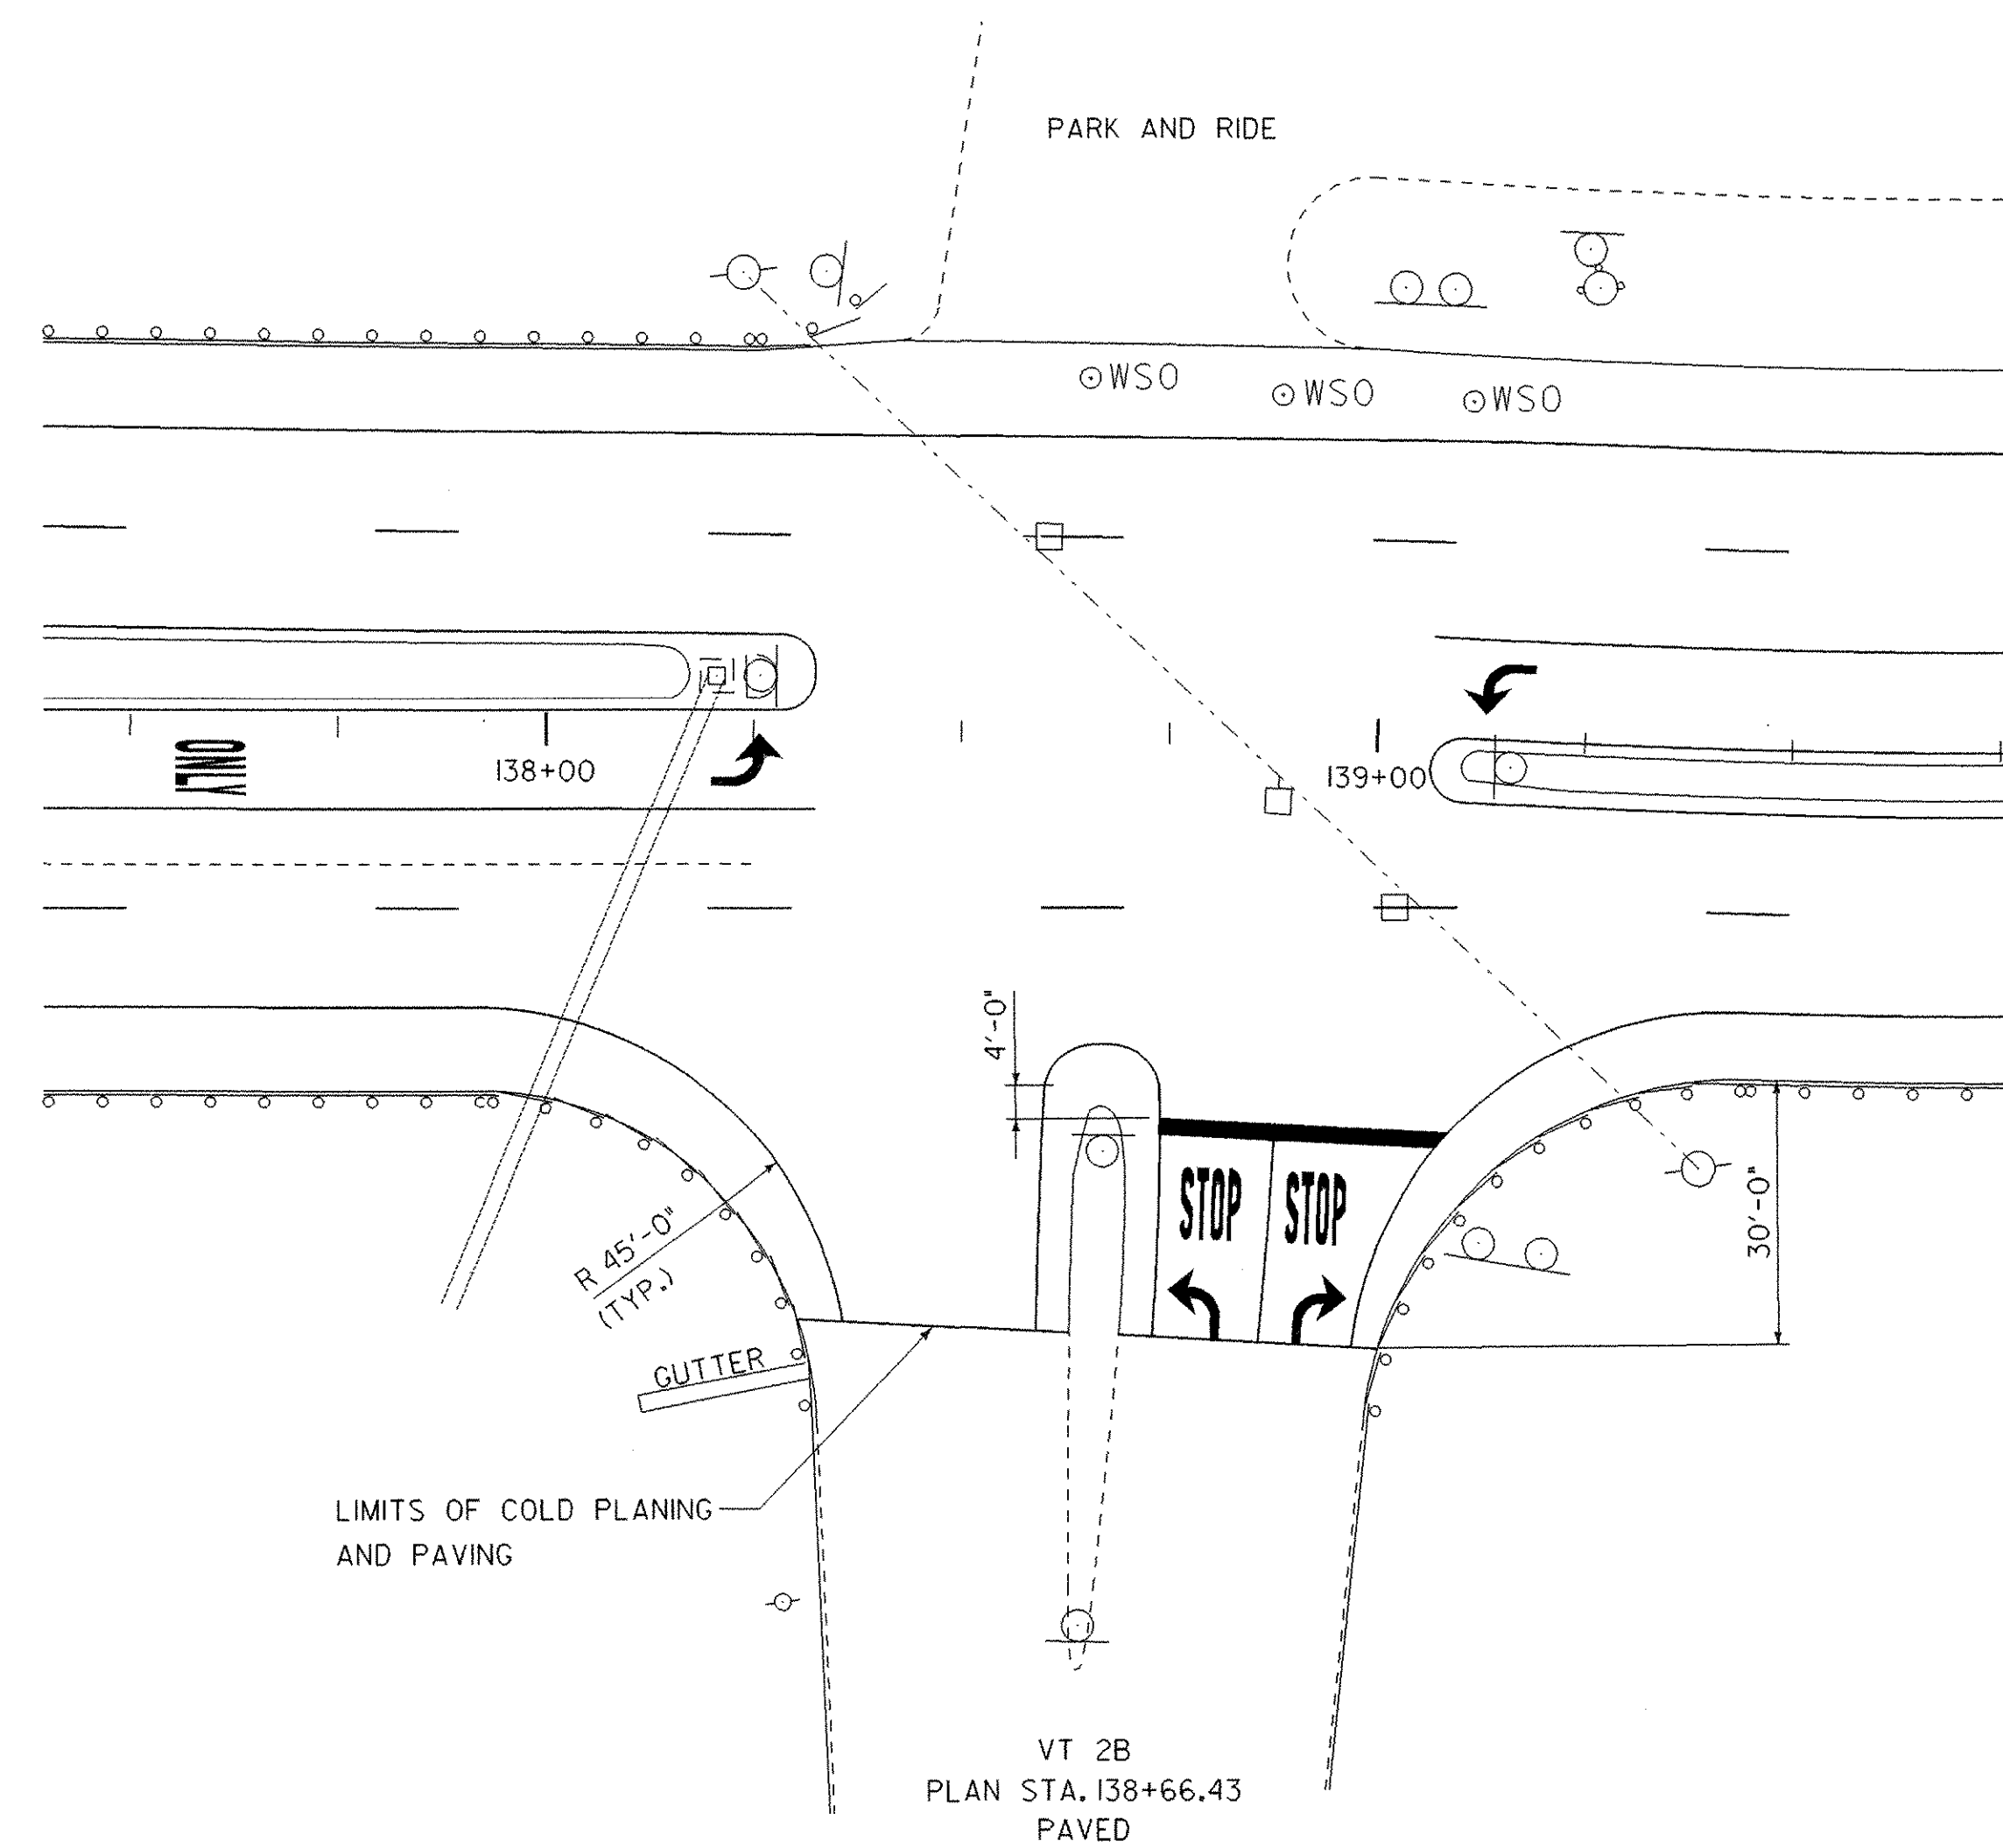

**VT 2B INTERSECTION
(ST. JOHNSBURY)**

ALL DETAILS NOT TO SCALE

INTESECTION DETAIL SHEET 2	PROJECT NAME:	
	PROJECT NUMBER: NH 2501(I)S	
	FILE NAME: pave/p05b034/05b034	PLOT DATE: 12-JAN-2007
	PROJECT LEADER: EPD	DRAWN BY:
DESIGNED BY: JDA	CHECKED BY: EPD	
PLOT FILE: 05b034In+2.1	SHEET 62	OF 63