


**BEGIN STP 2212(1)S
 VT ROUTE 15
 UNDERHILL
 STA. 7+056.97 = MM 4.385**



**ARCHIVED
 IN DPR**

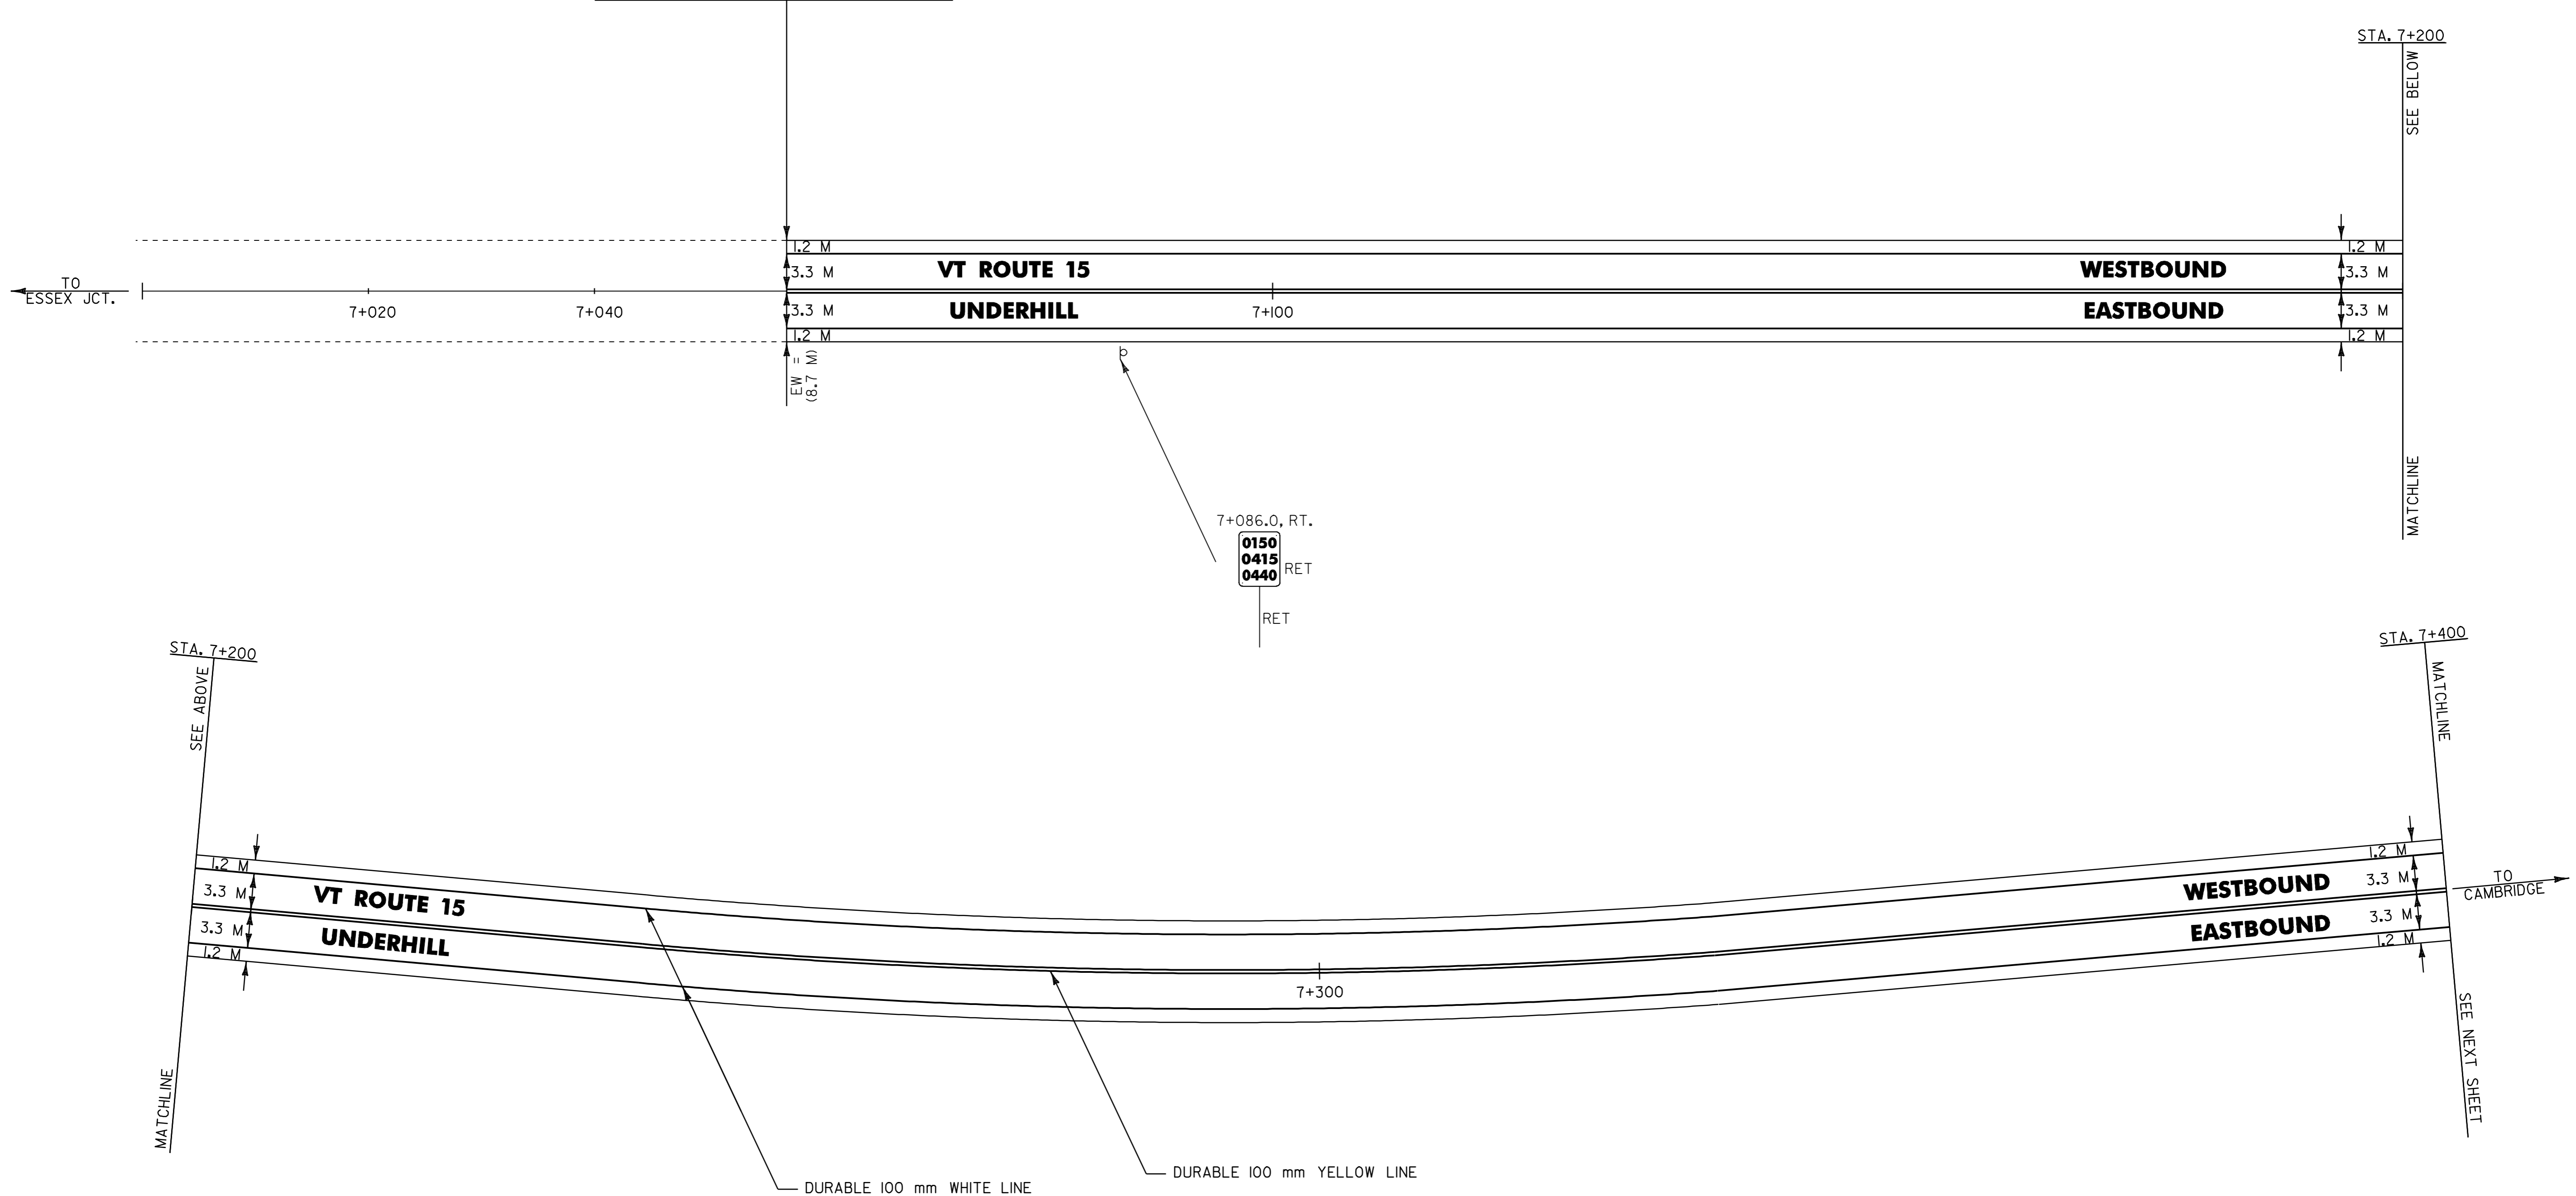

- NOTES: 1) ALL DIMENSIONS IN MILLIMETERS EXCEPT WHERE OTHERWISE INDICATED.
 2) FOR ANY TOWN HIGHWAY OR STREET DETAILS, SEE VTrans STANDARD E-193M.
 3) EW = EXISTING ROADWAY WIDTH

LAYOUT SHEET #1

PROJECT NAME: UNDERHILL - CAMBRIDGE	FILE NAME: ZpqveZ99bl76Zpb176.dgn	PLOT DATE: 26-JAN-2006 11:0
PROJECT NUMBER: STP_2212(1)S	PROJECT LEADER: JLL	DRAWN BY: D-H
	DESIGNED BY: D-H	CHECKED BY:
	IPARM FILE NAME: pb1761.i	SHEET 10 OF 36