

621.20 STEEL BEAM GUARDRAIL, GALVANIZED  
 STA. 336+81.5 TO 338+50, RT

621.50 MANUFACTURED TERMINAL SECTION, FLARED  
 STA. 336+44 TO 336+81.5, RT

621.80 REMOVAL AND DISPOSAL OF GUARDRAIL  
 STA. 336+44 TO 338+50, RT


~~646.402 DURABLE 4 INCH WHITE LINE, THERMOPLASTIC~~  
 STA. 332+48 TO 338+50, SOLID LT & RT

~~646.412 DURABLE 4 INCH YELLOW LINE, THERMOPLASTIC~~  
 STA. 332+48 TO 332+64, SOLID LT & RT  
 STA. 332+64 TO 338+50, SOLID LT, DASHED RT

646.602 TEMPORARY 4 INCH WHITE LINE, PAINT  
 STA. 332+48 TO 338+50, SOLID LT & RT

646.612 TEMPORARY 4 INCH YELLOW LINE, PAINT  
 STA. 332+48 TO 332+64, SOLID LT & RT  
 STA. 332+64 TO 338+50, SOLID LT, DASHED RT

**BEGIN STP 2213(1) VT ROUTE 25  
 BRADFORD STA 332+48.16=MM 6.297**

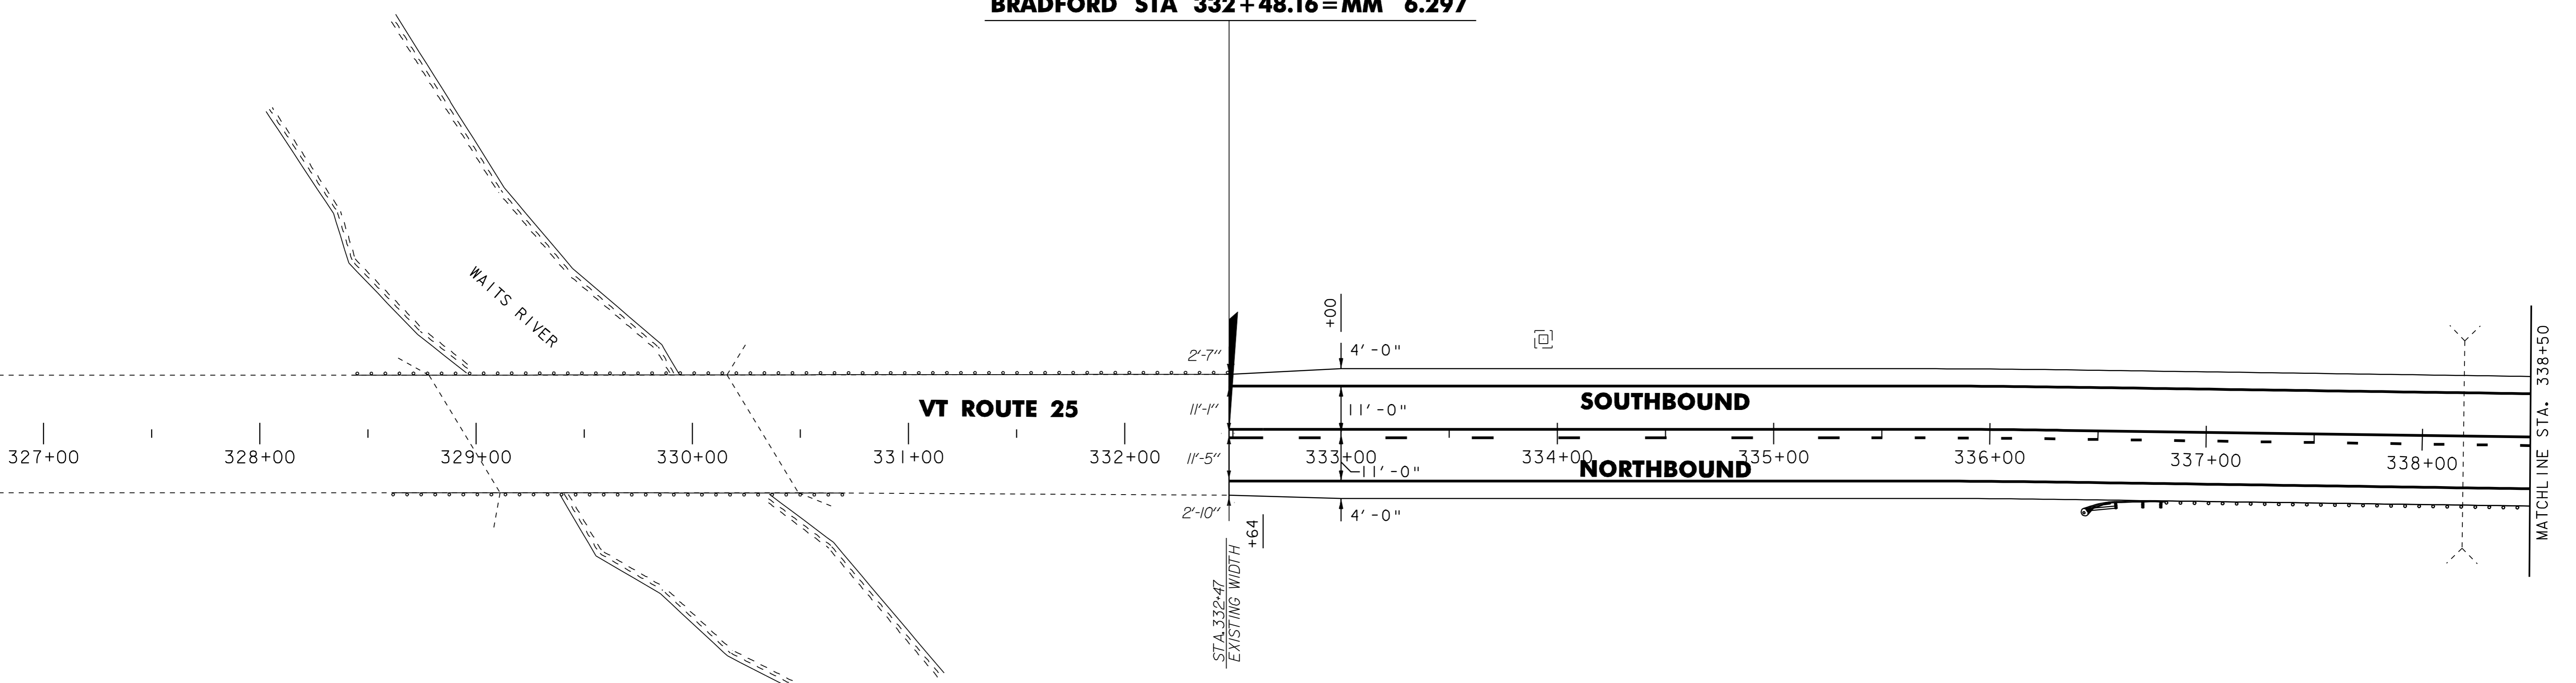

- UTILITY LEGEND**
- ⊙ = EXISTING HYDRANT
  - ⊠ = EXISTING DI
  - = EXISTING MANHOLE
  - TEL = EXISTING TELEPHONE MANHOLE
  - ELEC = EXISTING ELECTRIC MANHOLE
  - SMH = EXISTING SEWER MANHOLE
  - WSO = EXISTING WATER SHUTOFF
  - GSO = EXISTING GAS SHUTOFF
  - ♣ = EXISTING MAILBOX
- SIGN LEGEND**
- N = NEW
  - R = REMOVE
  - R&S = REMOVE & SALVAGE
  - S = SALVAGE SIGN
  - RET = RETAIN
  - B-B = BACK TO BACK

NOT TO SCALE

NOTE:  
 ALL EXISTING SIGNS NOT SHOWN SHALL BE RETAINED.

<b>PROJECT LAYOUT SHEET #1</b>	PROJECT NAME: BRADFORD - ORANGE
	PROJECT NUMBER: STP 2213(1)
	FILE NAME: p99b178.dgn
	PLOT DATE: 28-MAY-2010 13:4
PROJECT LEADER: JLL	DRAWN BY: STANTEC
DESIGNED BY: STANTEC	CHECKED BY: JLL
IPARM FILE: p99b178IO1.i	SHEET 18 OF 84

