

621.20 STEEL BEAM GUARDRAIL, GALVANIZED
 STA. 338+50 TO 344+44, RT
 56.5

621.50 MANUFACTURED TERMINAL SECTION, FLARED
 STA. ~~344+44~~ TO ~~344+81.5~~, RT
 344+56.5 344+94

621.80 REMOVAL AND DISPOSAL OF GUARDRAIL
 STA. 338+50 TO 344+83, RT

621.205 STEEL BEAM GUARDRAIL, GALVANIZED W/ 8' POSTS
 STA 338+81.5 TO 343+81.5 RT (225')

646.20
~~646.402 DURABLE 4 INCH WHITE LINE, THERMOPLASTIC~~
 STA. 338+50 TO 349+50, SOLID LT & RT


646.21
~~646.412 DURABLE 4 INCH YELLOW LINE, THERMOPLASTIC~~
 STA. 338+50 TO 339+24, SOLID LT & DASHED RT
 STA. 339+24 TO 342+14, DASHED LT & SOLID RT
 STA. 342+14 TO 349+50, DASHED LT, SOLID RT

646.602 TEMPORARY 4 INCH WHITE LINE, PAINT
 STA. 338+50 TO 349+50, SOLID LT & RT

646.612 TEMPORARY 4 INCH YELLOW LINE, PAINT
 STA. 338+50 TO 339+24, SOLID LT & DASHED RT
 STA. 339+24 TO ~~342+14~~, DASHED LT & SOLID RT
 STA. ~~342+14~~ TO 349+50, DASHED LT, SOLID RT
 345+20 345+20 SOLID

675.50 REMOVING SIGNS
 AS SHOWN - I

675.60 ERECTING SALVAGED SIGNS
 AS SHOWN - I

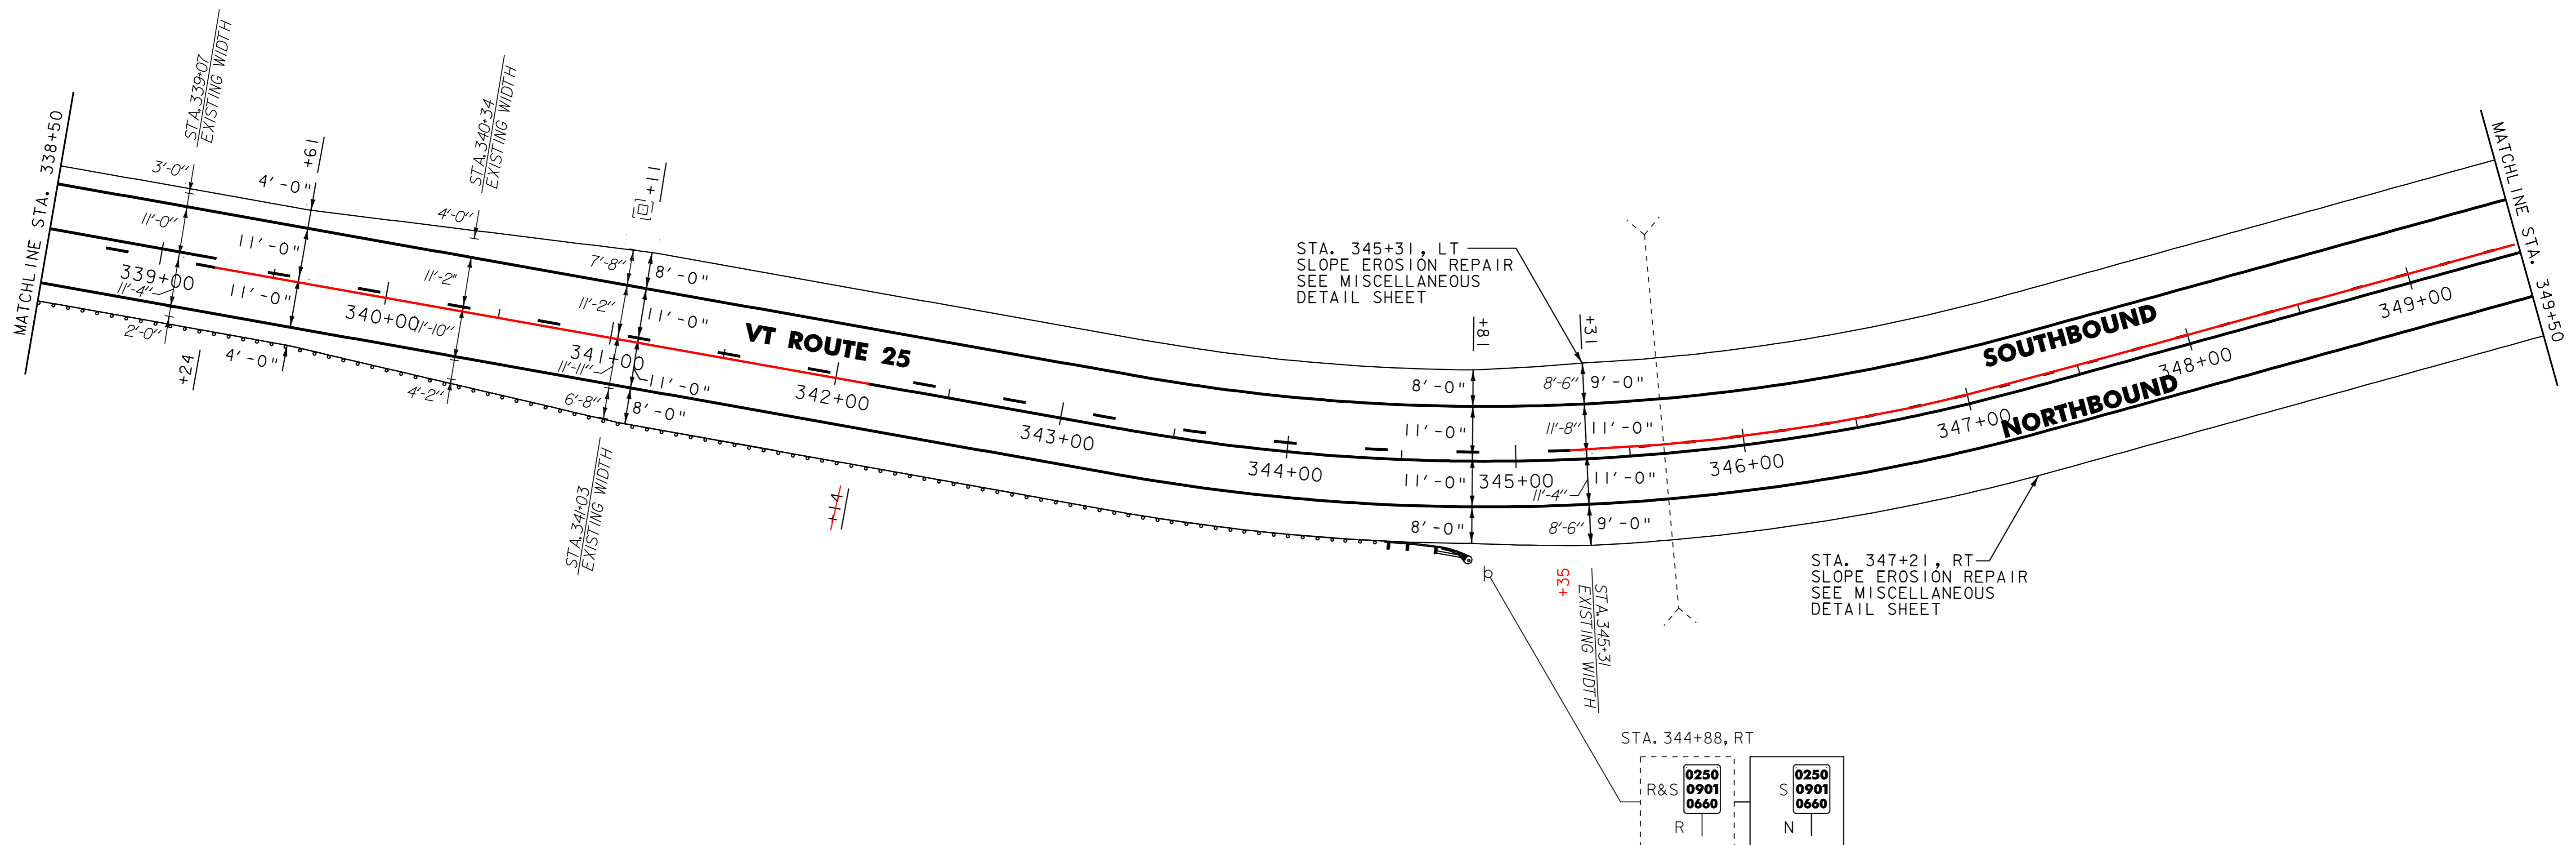

- NOTES:
1. ALL EXISTING SIGNS NOT SHOWN SHALL BE RETAINED.
 2. FOR LEGEND, SEE LAYOUT SHEET #1

NOT TO SCALE

PROJECT LAYOUT SHEET #2



PROJECT NAME: BRADFORD - ORANGE	FILE NAME: p99b178.dgn	PLOT DATE: 28-MAY-2010 13:4
PROJECT NUMBER: STP 2213(I)	PROJECT LEADER: JLL	DRAWN BY: STANTEC
DESIGNED BY: STANTEC	CHECKED BY: JLL	SHEET 19 OF 84
IPARM FILE: p99b178IO2.i		